



As built from 2011

As built from 2011



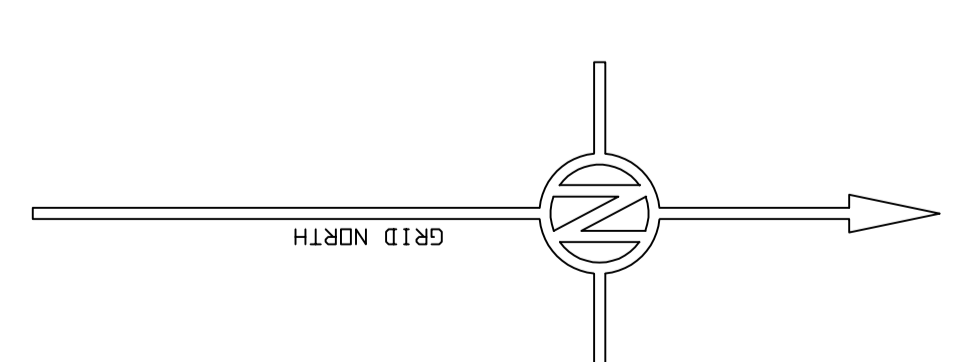

**THE RIDGEWAY, CUFFLEY**

CLIENT: **ADAM BURGESS ARCHITECTS**

---

**THE SURVEY**

SHEET 1 OF 1	SCALE 1:200	42530
REF. NO. 2024	SURVEY JOB NO. 2024	
SURVEYED - SEPT 2016		1:0

STANDARD REFERENCE

DATA SOURCES - OSNAMED SURVEY DATA IS IN USE

BOUNDARY DATA - OSM OF THE SITE

SITE BOUNDARY ESTABLISHED - SURVEY TRAINING SET PLAN

SURVEY TRAINING SURVEY DATA

PROJECTION - OSN IS IN UTM COORDINATE AND UTM

---

ABBREVIATIONS

AO	AS CONSTRUCTION UNIT	ND	NON DUTY	RP	RANGE MARKER
C	CORNER	LA	LABOURER	SI	SHOULDER
CP	CORNER POINT	LP	LABOURER POINT	SK	SKINNY
EP	EXISTING POINT	MP	MURDERER	SM	SHOULDER MARKER
FP	FIXED POINT	NP	NON POINT	SP	SHOULDER POINT
LP	LABOURER POINT	OP	OBSCURE POINT	ST	SHOULDER TIE
MP	MURDERER POINT	PP	POINT POINT	TT	TIE TIE
NP	NON POINT	RP	RANGE MARKER	UT	UTILITY
OP	OBSCURE POINT	SM	SHOULDER MARKER	VP	VERTICAL POINT
PP	POINT POINT	SK	SKINNY	WP	WATER POINT
RP	RANGE MARKER	SM	SHOULDER MARKER	WT	WATER TIE
SK	SKINNY	SP	SHOULDER POINT	WT	WATER TIE
SM	SHOULDER MARKER	ST	SHOULDER TIE		
SP	SHOULDER POINT				
ST	SHOULDER TIE				
TT	TIE TIE				
UT	UTILITY				
VP	VERTICAL POINT				
WP	WATER POINT				
WT	WATER TIE				