



GROUND FLOOR PLAN 1:50

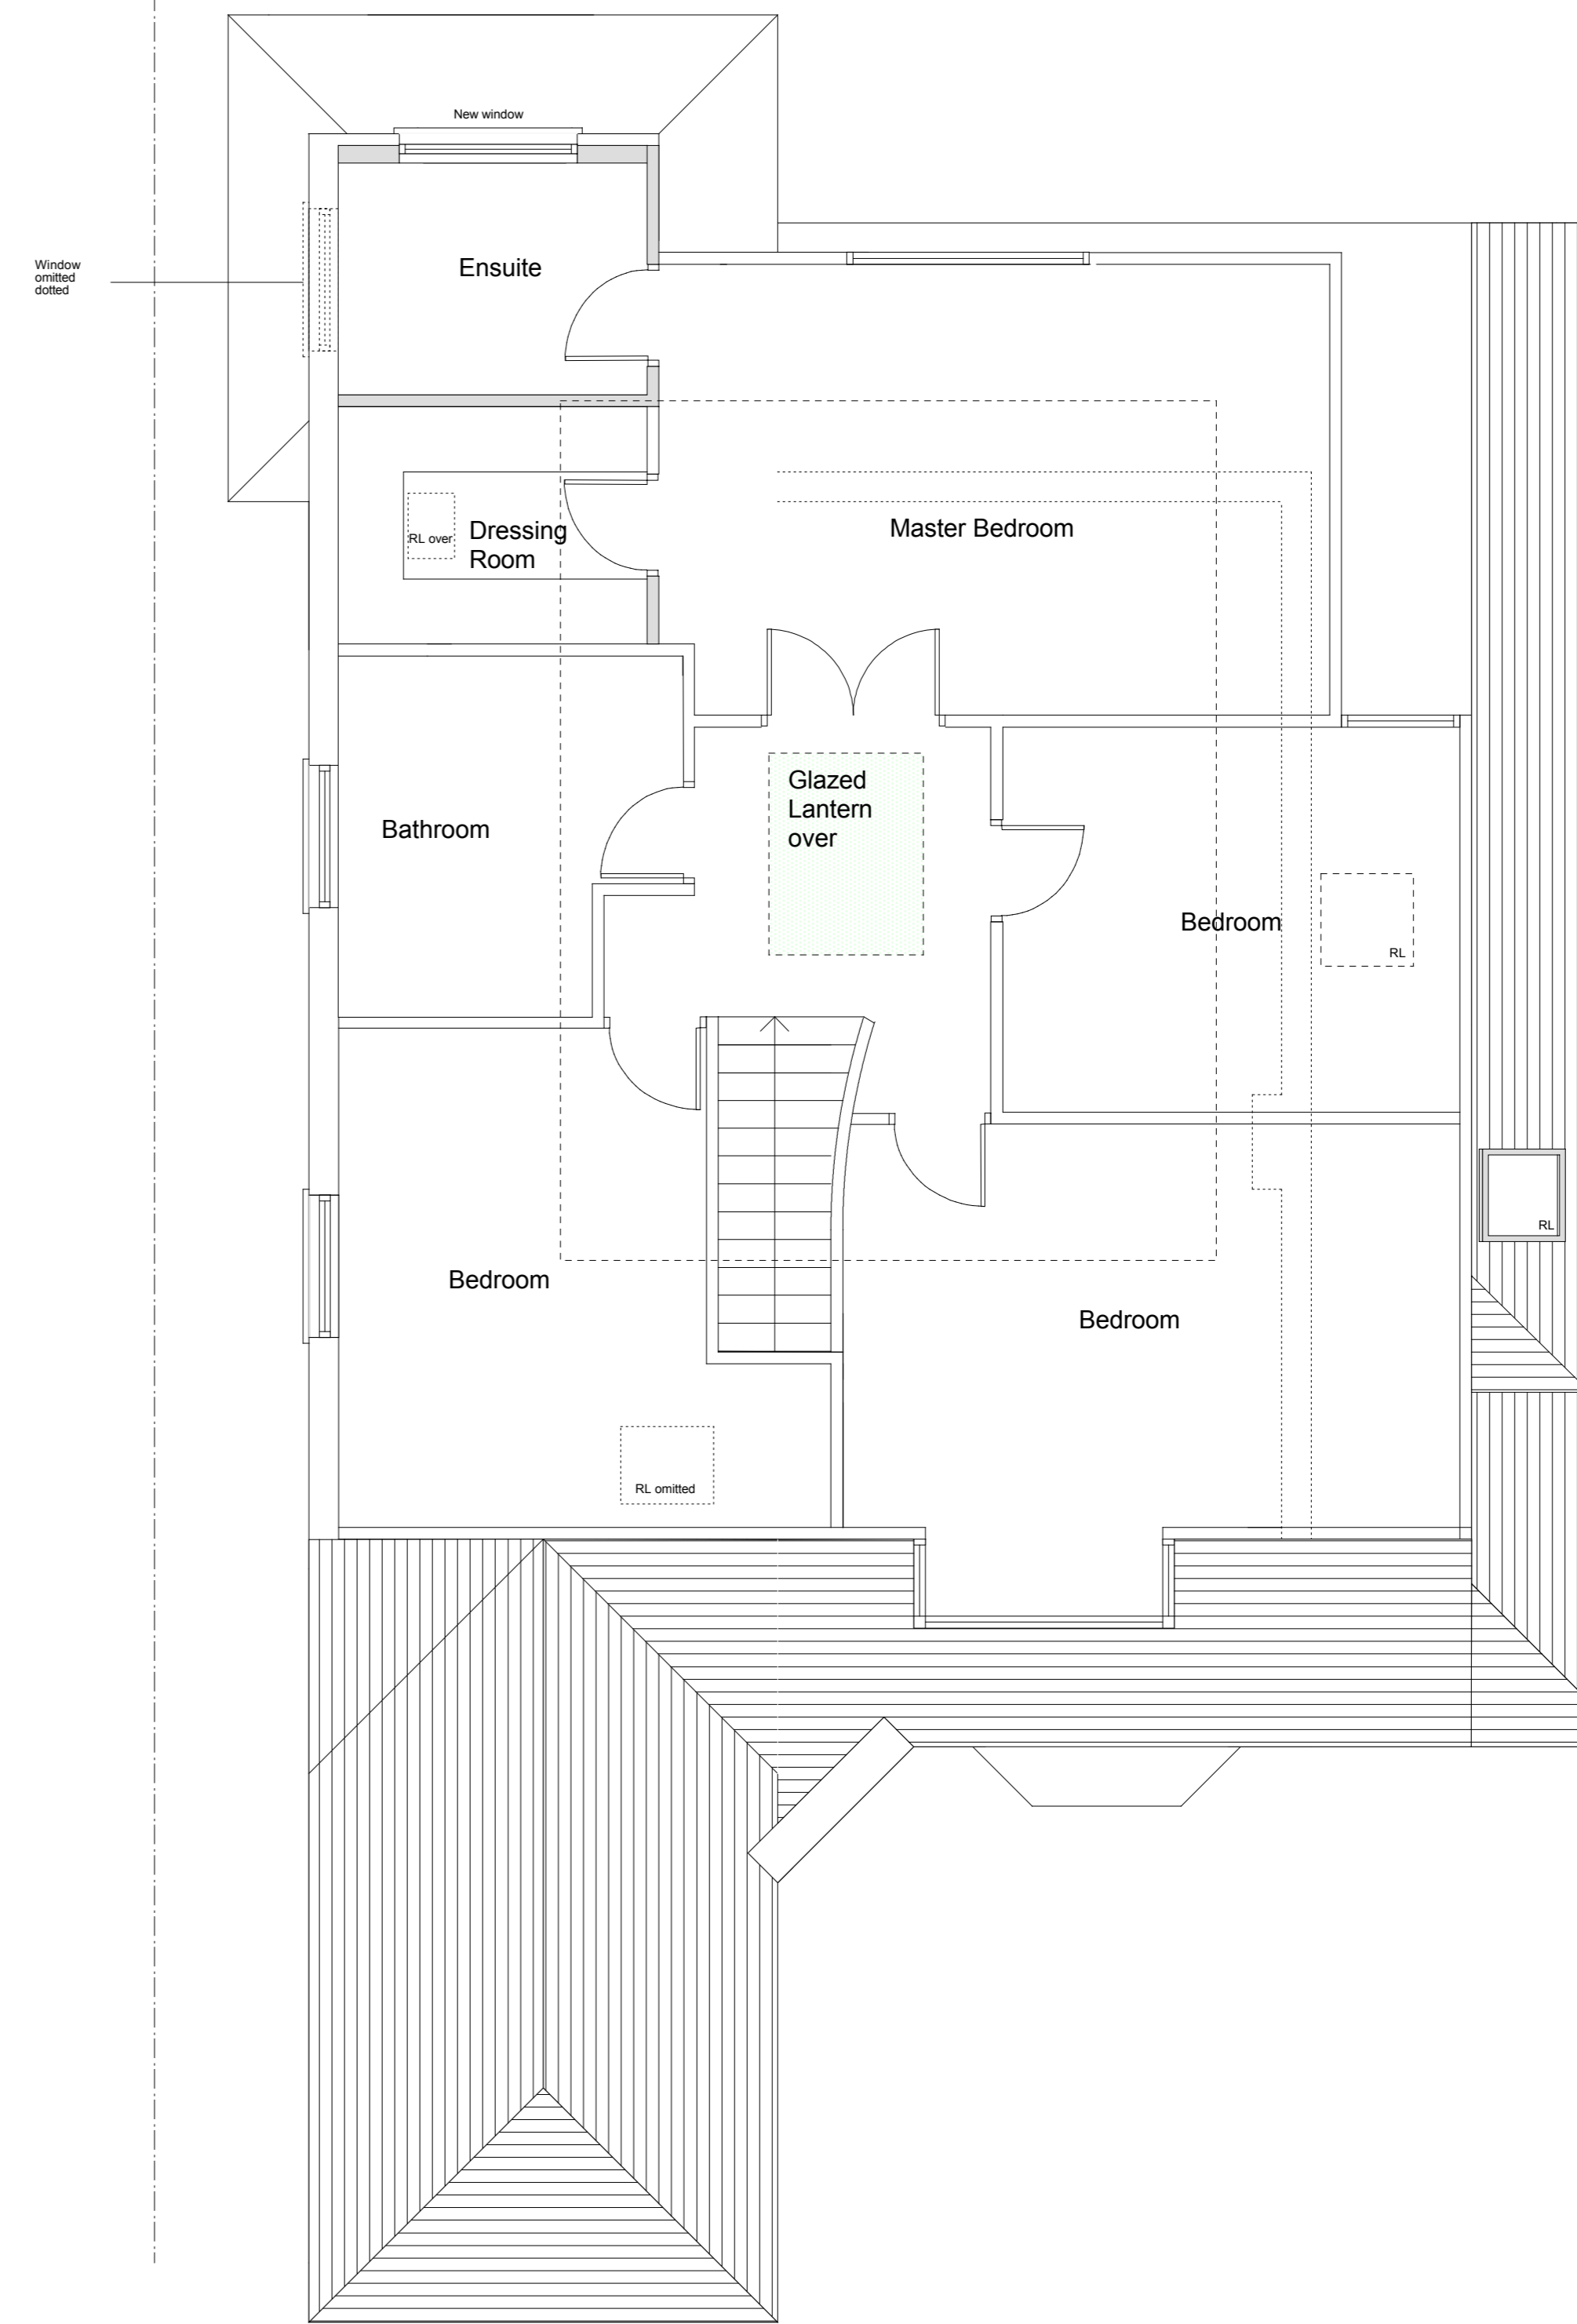

FIRST FLOOR PLAN 1:50

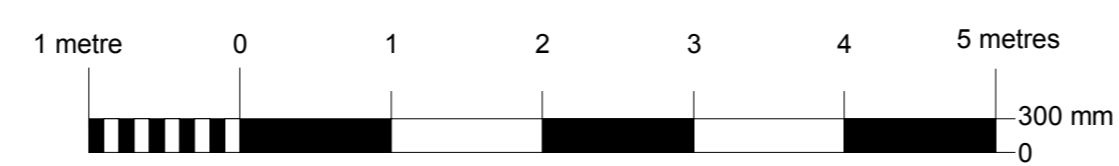

PLANNING

1:50 @ A1

Rev. A. Revised to As Built

Drg. No. PA.03A