




PROPOSED EXTENSIONS AND ALTERATIONS AT 17 KINGSMEAD, CUFFLEY, HERTS.

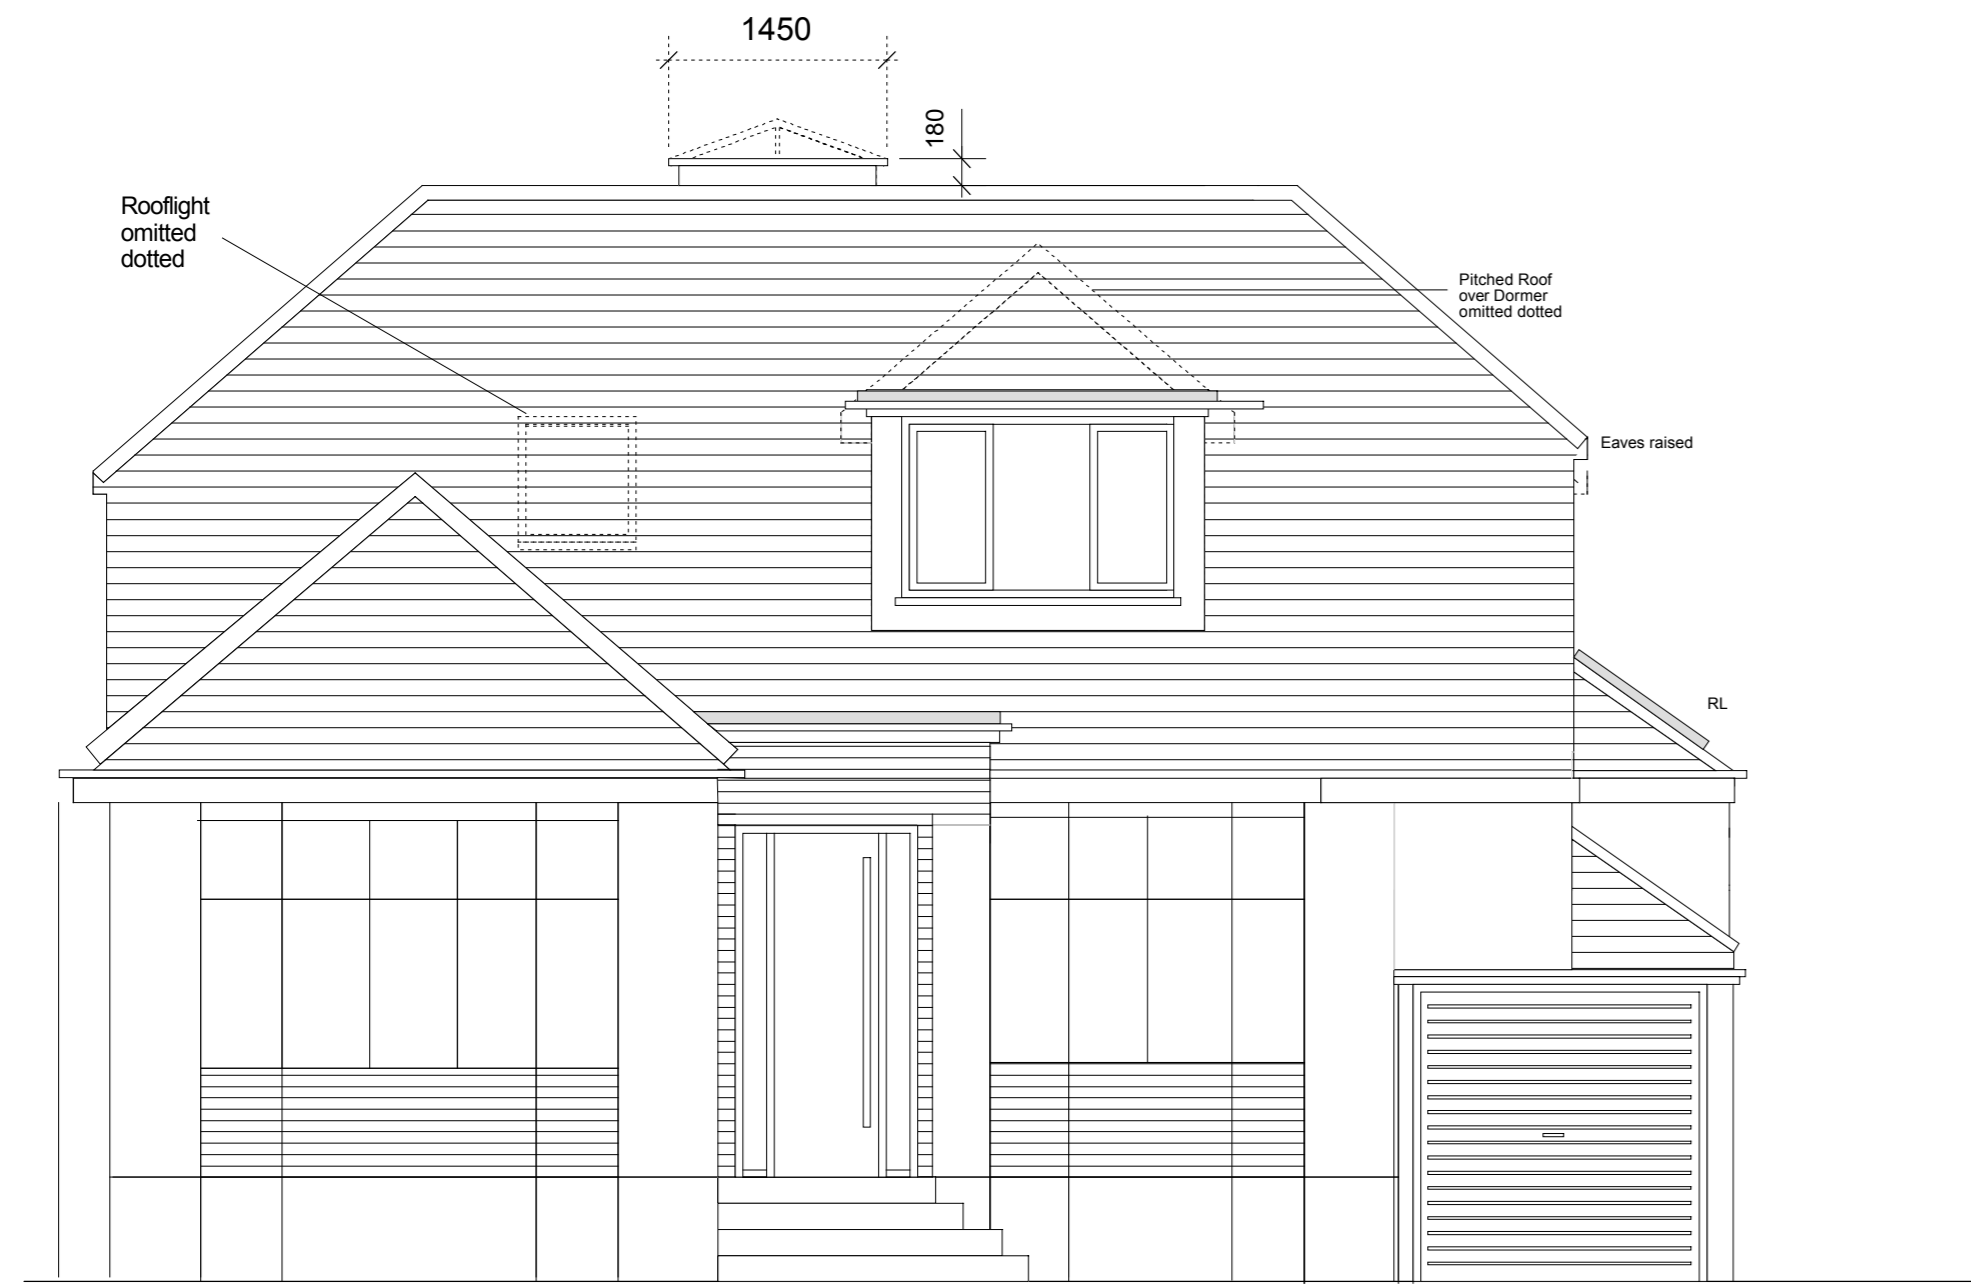

FRONT ELEVATION 1:50

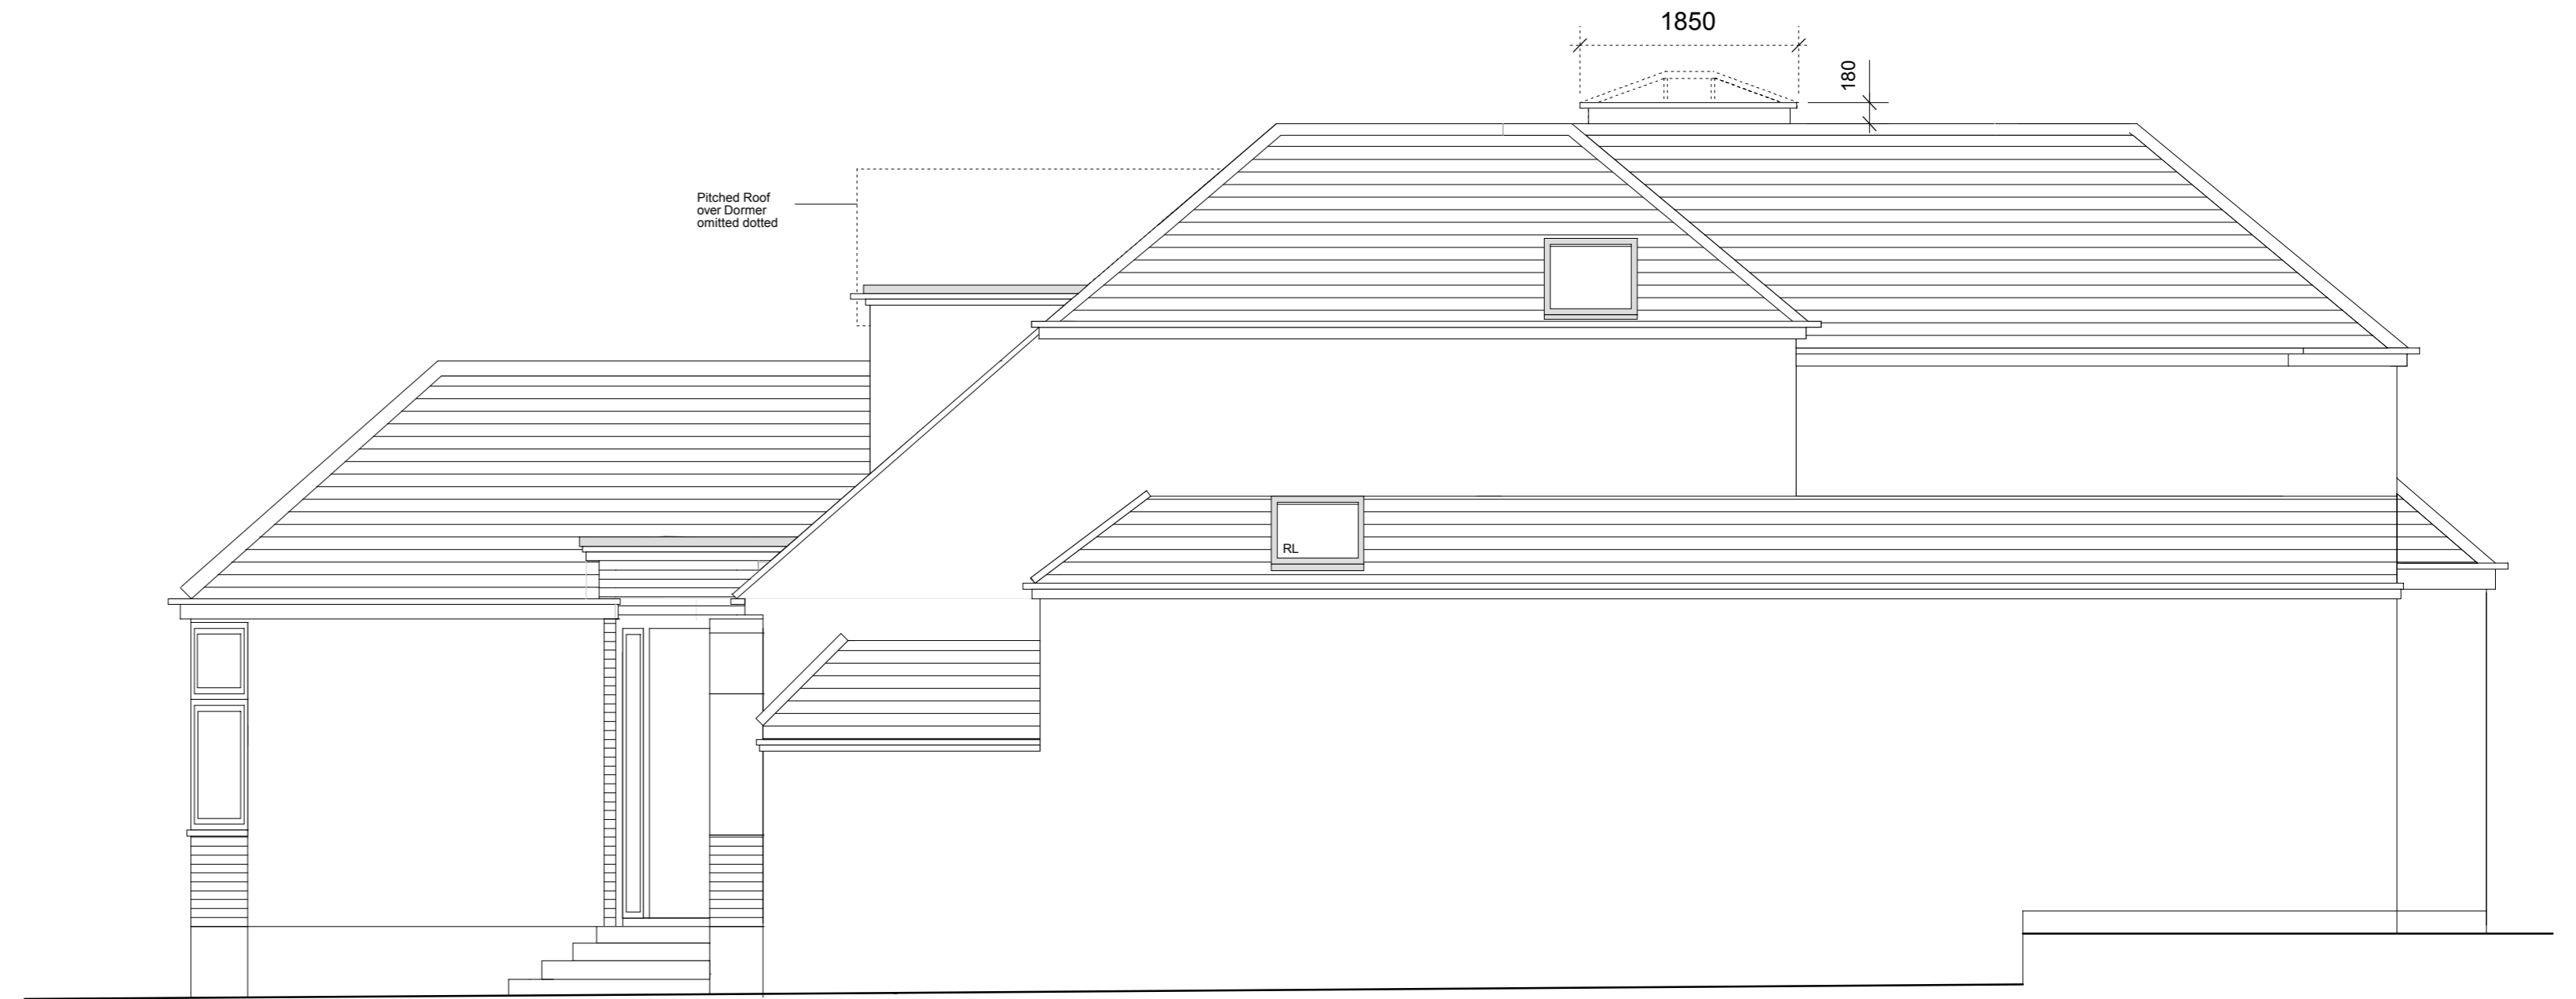

NORTH ELEVATION 1:50

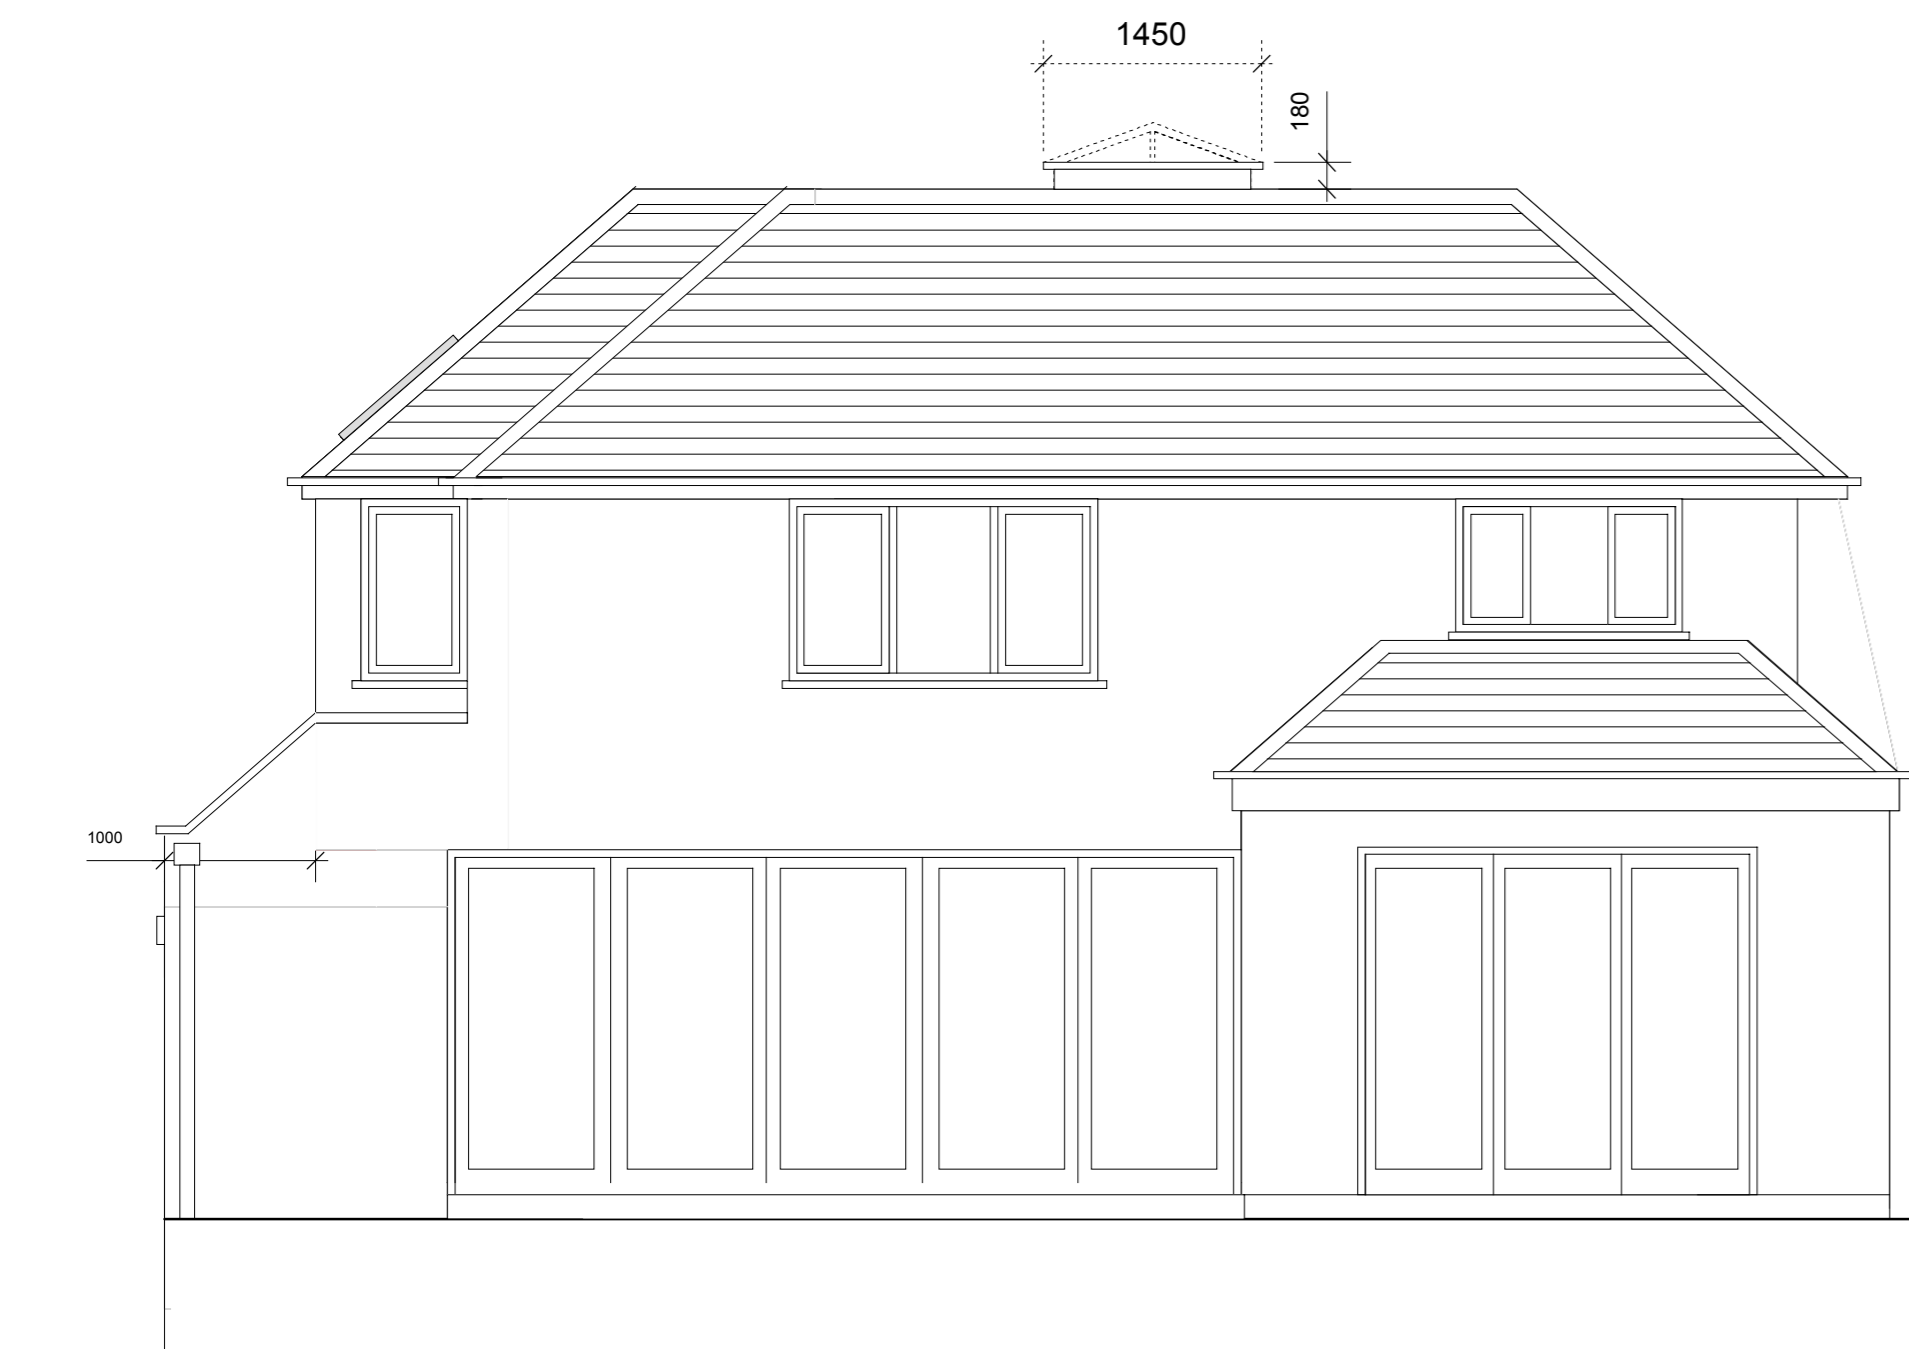


REAR ELEVATION 1:50



SOUTH ELEVATION 1:50

AS PROPOSED

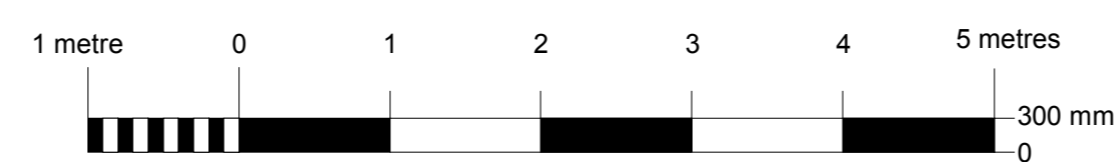

PLANNING

1:50 @ A1

Rev. B As Built revisions
Rev. A Roof Lantern added

Drg. No. PA.04B