




**PRE-EXISTING FRONT ELEVATION**  
Scale 1:50

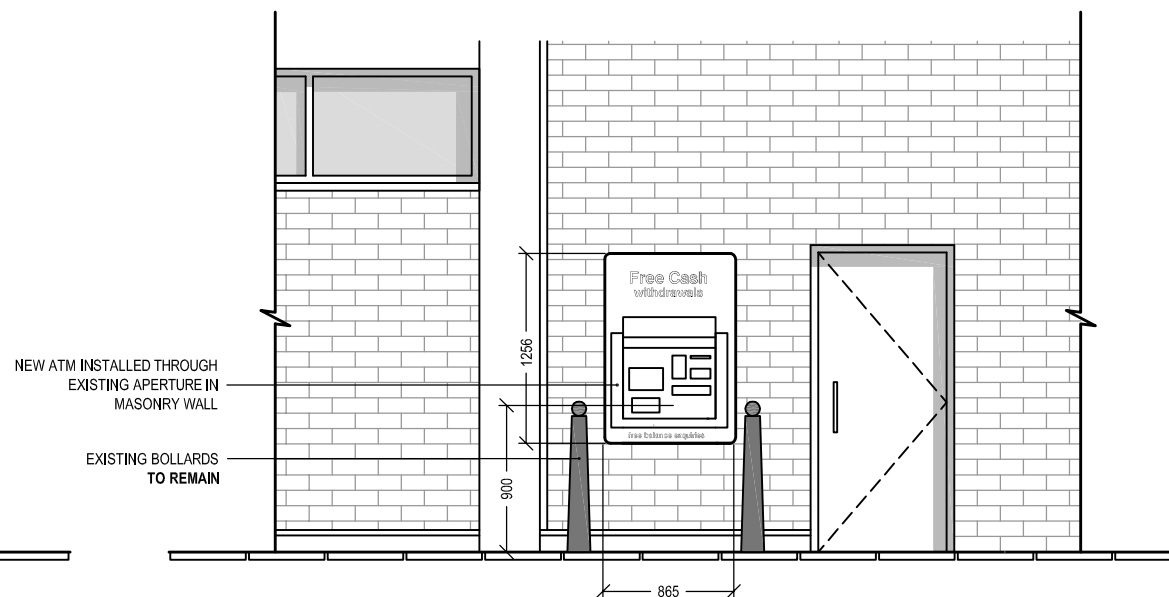


**AS INSTALLED FRONT ELEVATION**  
Scale 1:50

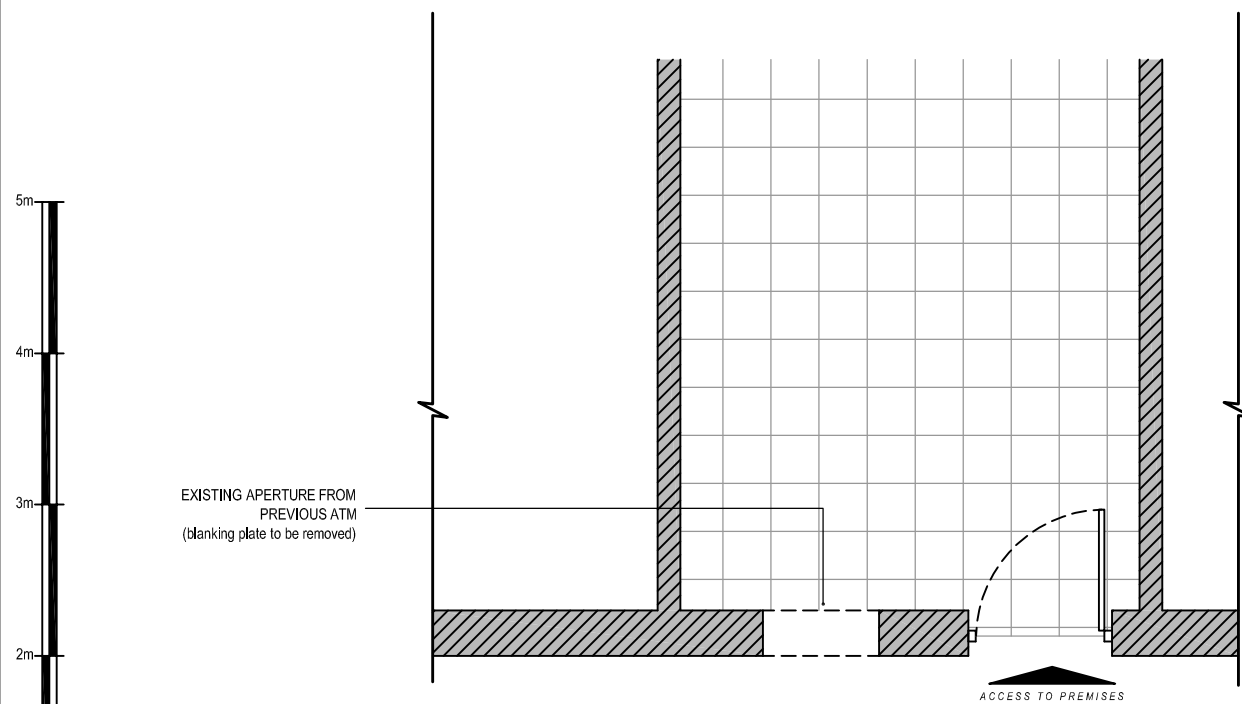

**PRE-EXISTING PART PLAN**  
Scale 1:50

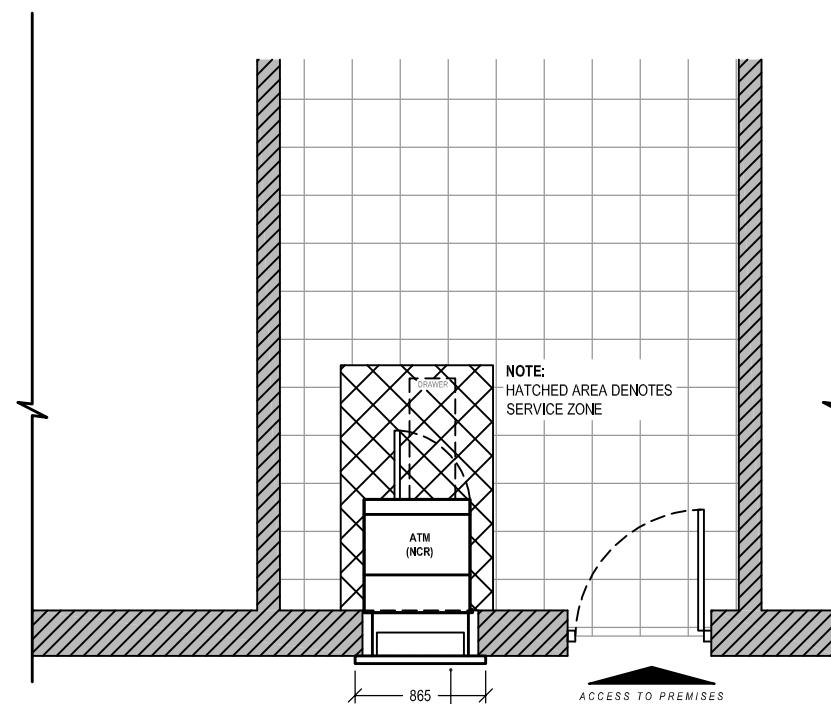

**AS INSTALLED PART PLAN**  
Scale 1:50

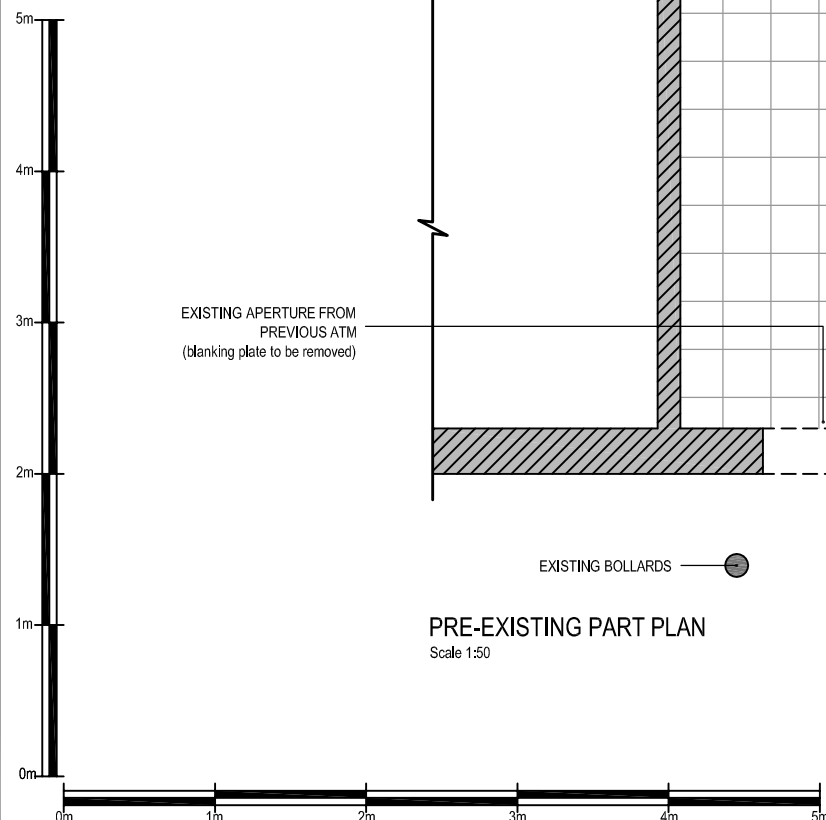

Date: \_\_\_\_\_ Comments: \_\_\_\_\_ By: \_\_\_\_\_

**GENERAL NOTES:**

1) All dimensions in millimeters unless otherwise stated.

**Site:**  
**COMET SQUARE**

Unit 4a, Parkhouse Court  
Comet Way  
Hatfield  
AL10 9RQ

**Drawing Title:**

Pre-Existing & As Installed Elevations and Plans

<b>Ref:</b> NM-06-2015-83-1	<b>Date:</b> 23-06-2015	<b>Rev:</b>
<b>Scale:</b> 1:50	<b>Paper:</b> A3	<b>Date Rev:</b>