


Front Elevation Existing



Front Elevation As built

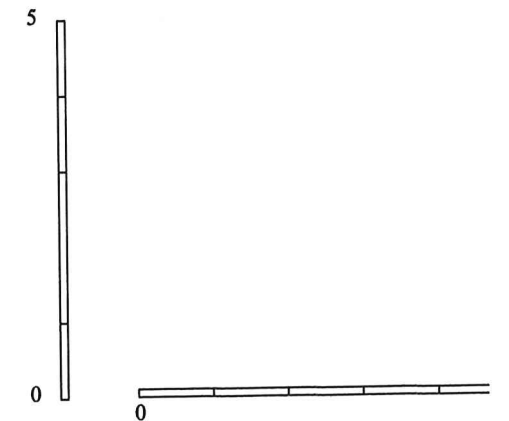

Scale 1:100

A3 Size paper

REVISIONS.			CONTRACT.	DETAIL.
NO.	DETAILS.	DATE.		
			Works at 2 Barlow Close Hatfield	Elevations as Existing and Built
			CLIENT.	
			DRAWN. rgl	DRAWING NO.
			REVISION.	DATE. july 03
			STATUS.	SCALE. 1:100
				mp.2770