




**MACHINERY SHED: FLOOR PLAN**

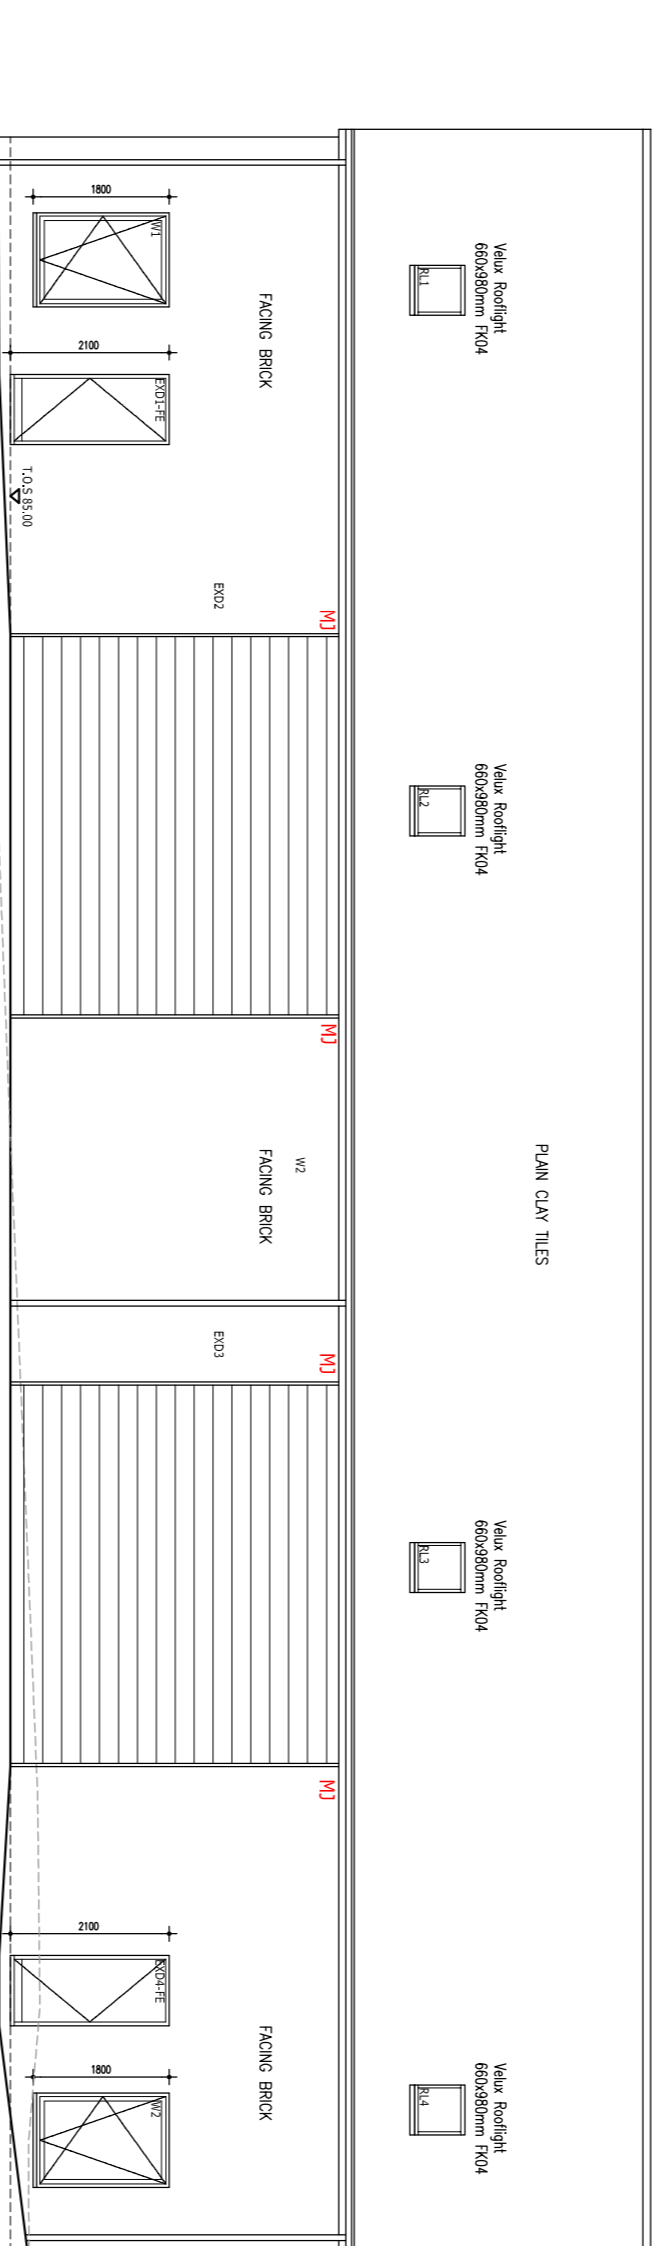


**MACHINERY SHED: FIELD ELEVATION**

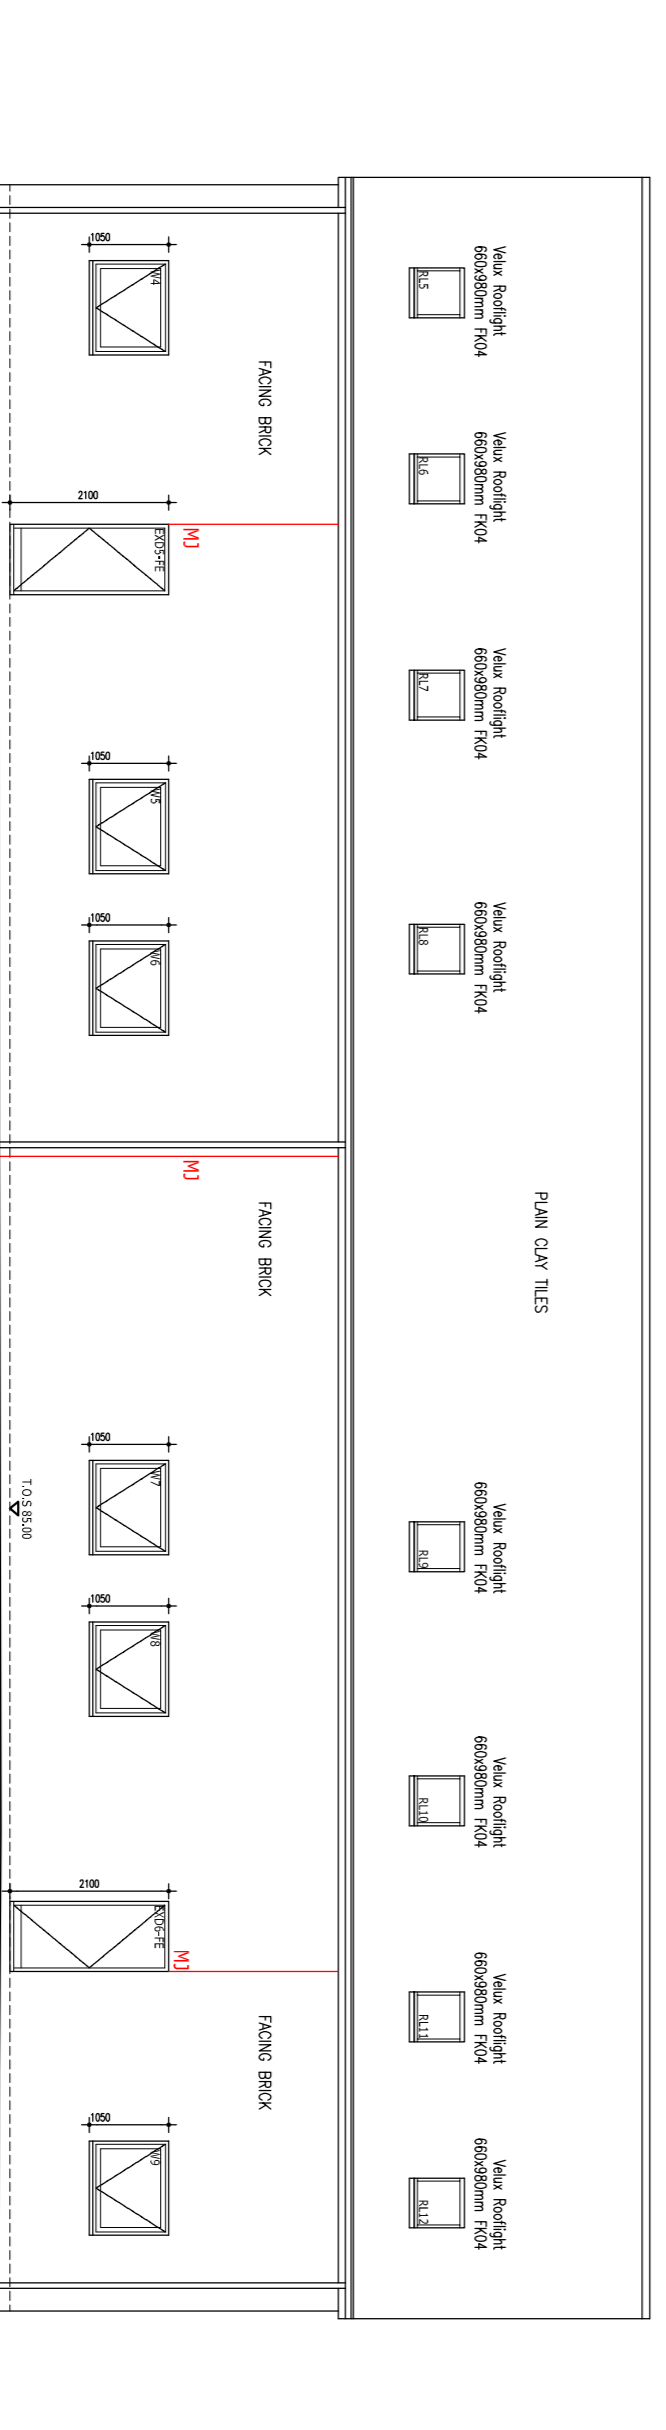


**MACHINERY SHED: OLD BARN ELEVATION**

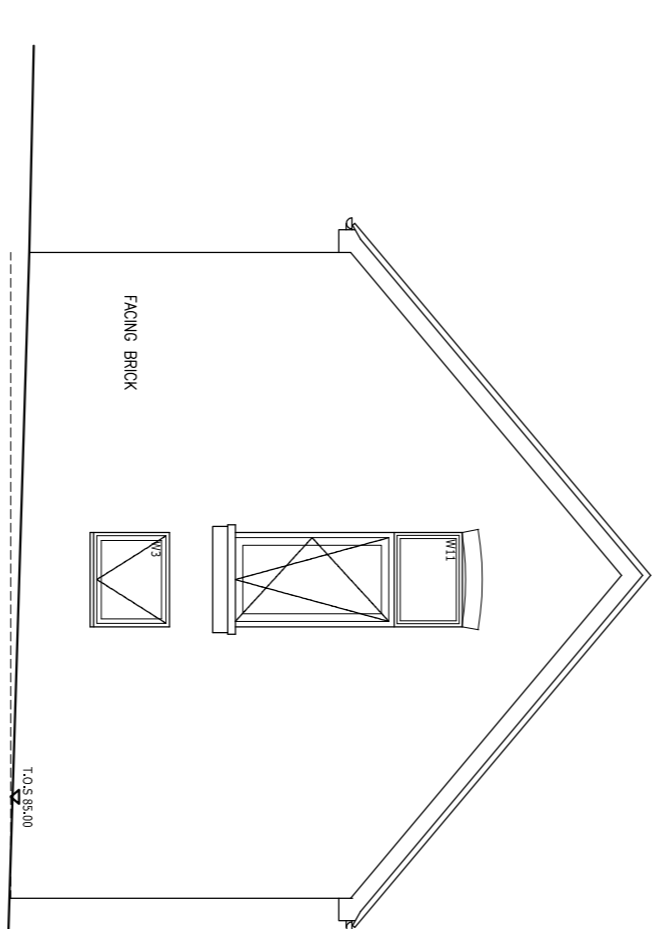

**MACHINERY SHED:  
SIDE ELEVATION**

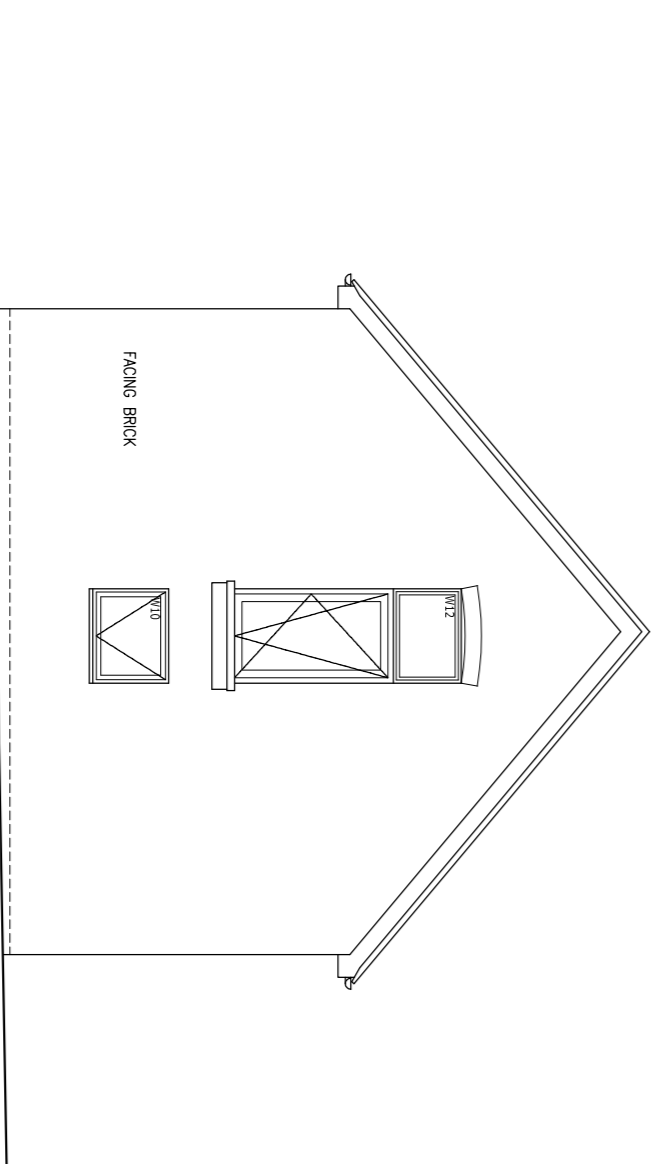

**MACHINERY SHED:  
SIDE ELEVATION**

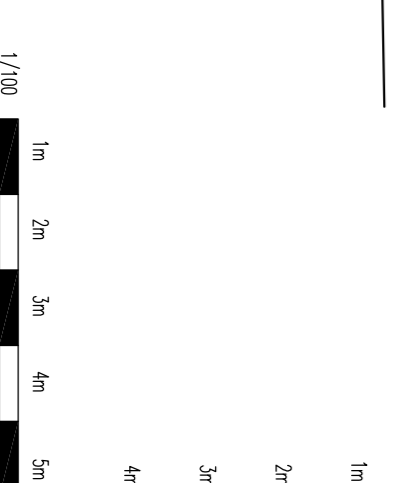

|         |           |
|---------|-----------|
| JOB No. | 2109      |
| DWG No. | PL10E     |
| SCALE   | 1/100 @A1 |
| DATE    | JULY 2019 |
| DRAWN   | PH        |
| CLIENT  |           |

NYN MANOR  
VINEYARDS ROAD  
NORTHAW EN6 4PQ

AS BUILT  
PLANS & ELEVATIONS

**Wastell & Porter**  
Architects Limited

BANKROFT HOUSE  
34 BANKROFT  
HITCHIN  
HERTFORDSHIRE  
SG5 1LA

Email: [contact@wastellporter.co.uk](mailto:contact@wastellporter.co.uk)  
Tel: 01462 432440  
Fax: 01462 420003