




MACHINERY SHED: FLOOR PLAN

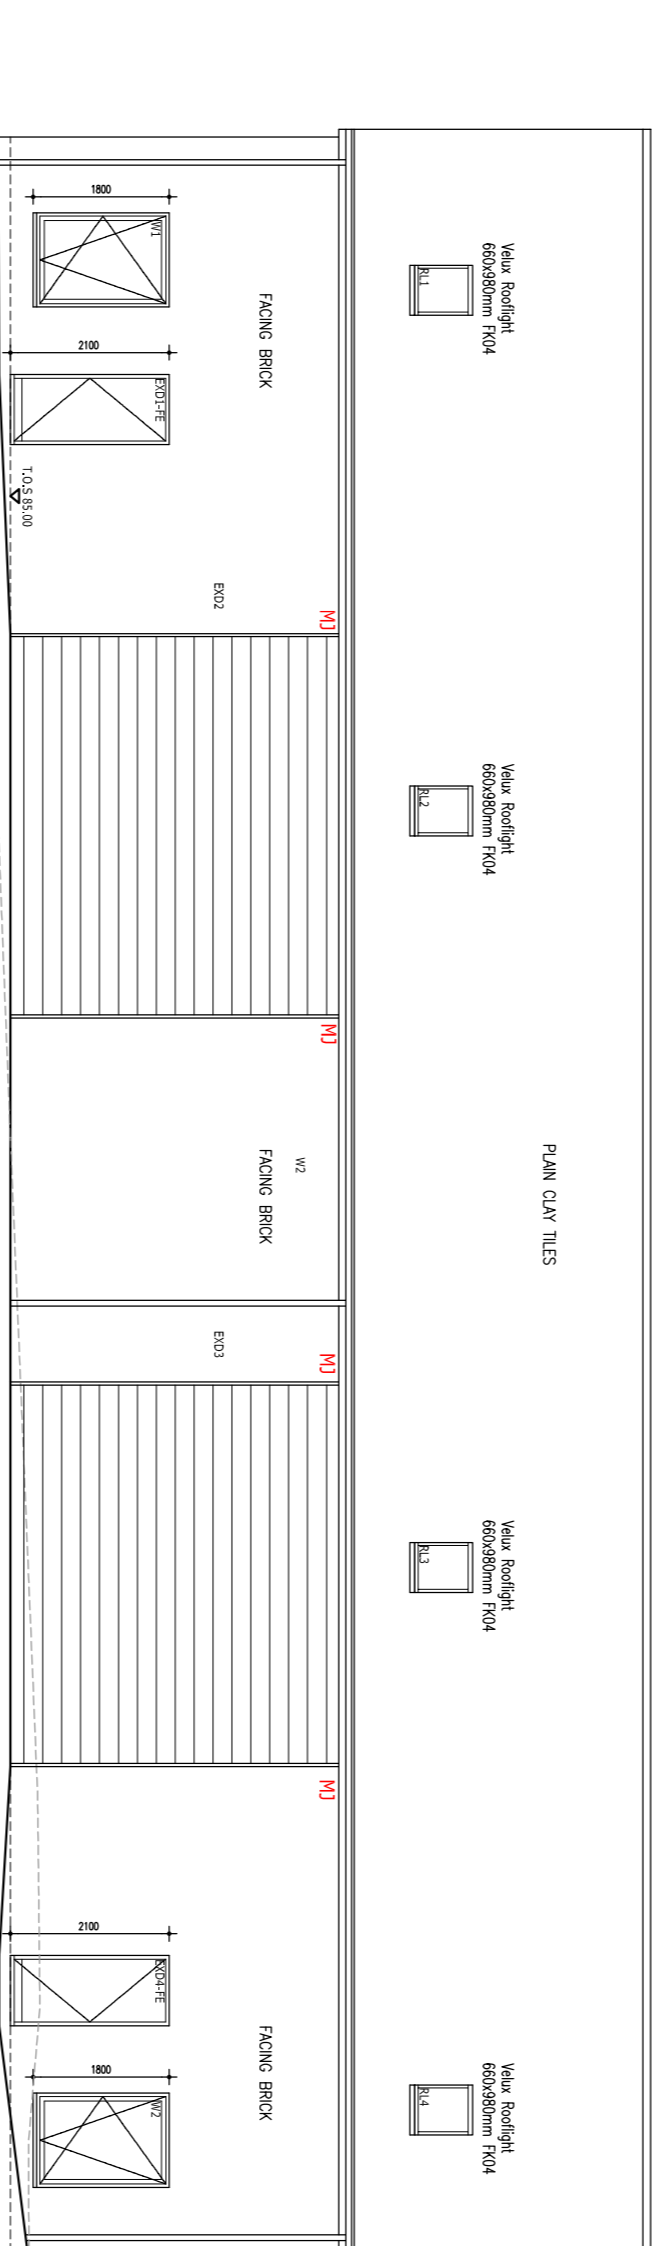


MACHINERY SHED: FIELD ELEVATION

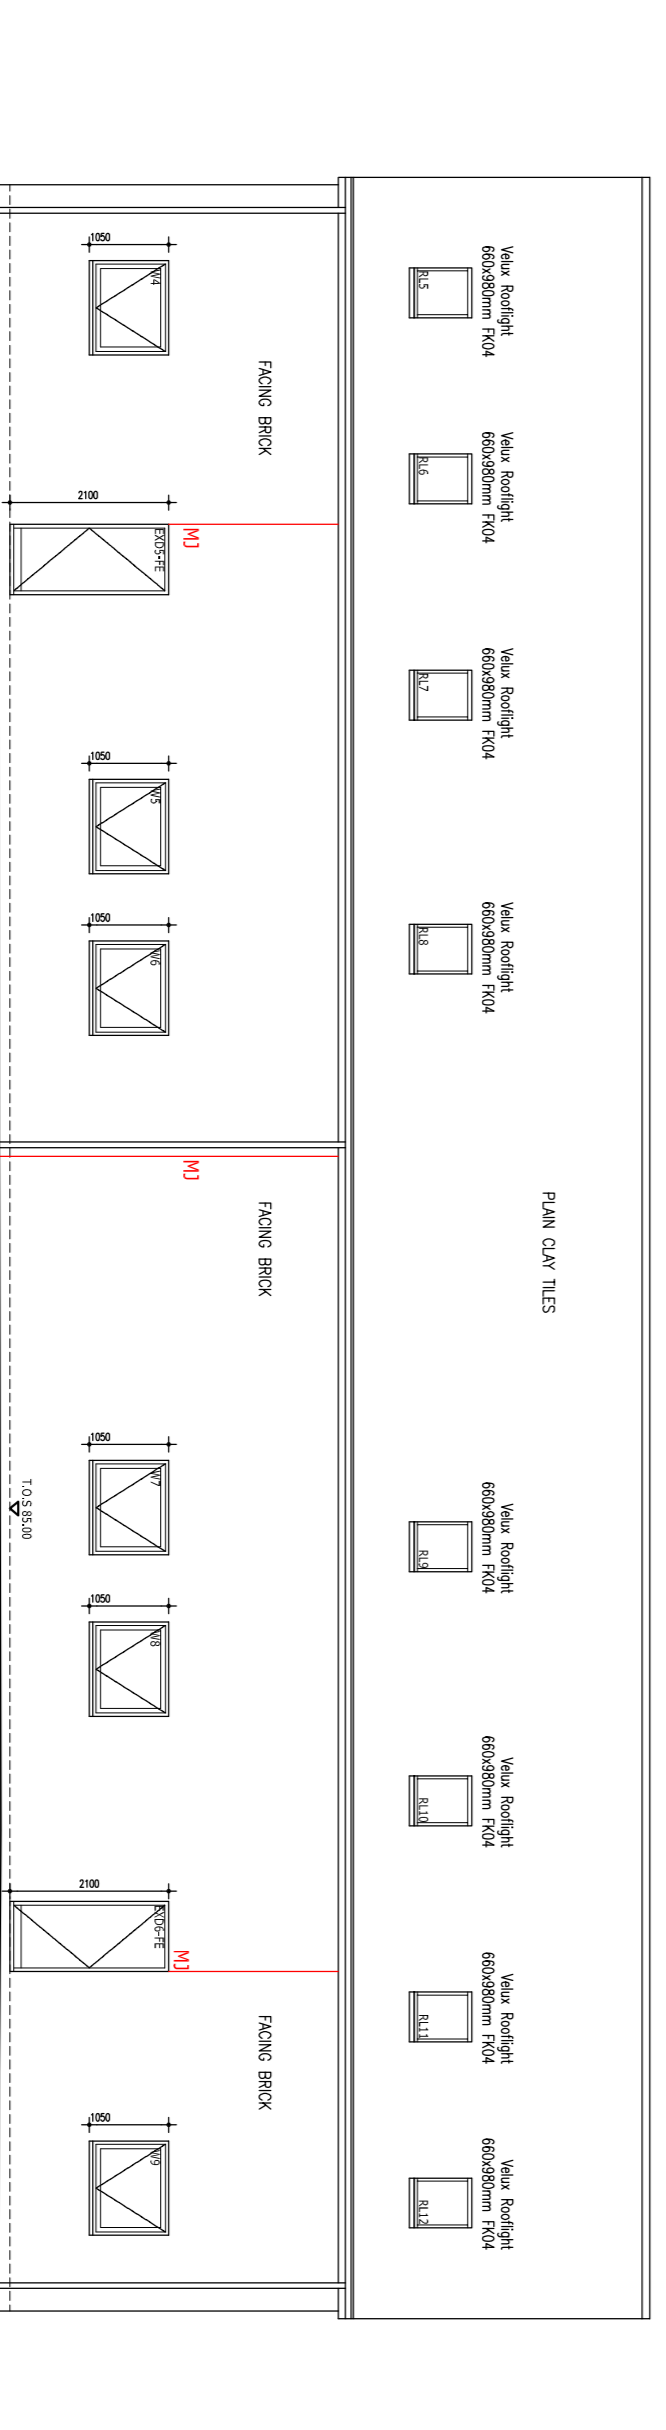


MACHINERY SHED: OLD BARN ELEVATION

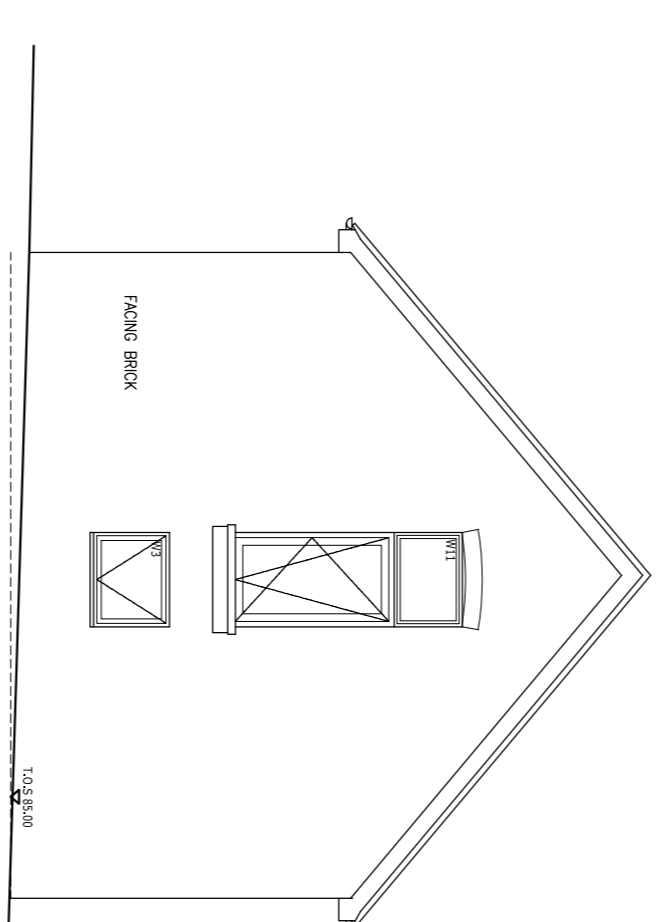

**MACHINERY SHED:
SIDE ELEVATION**

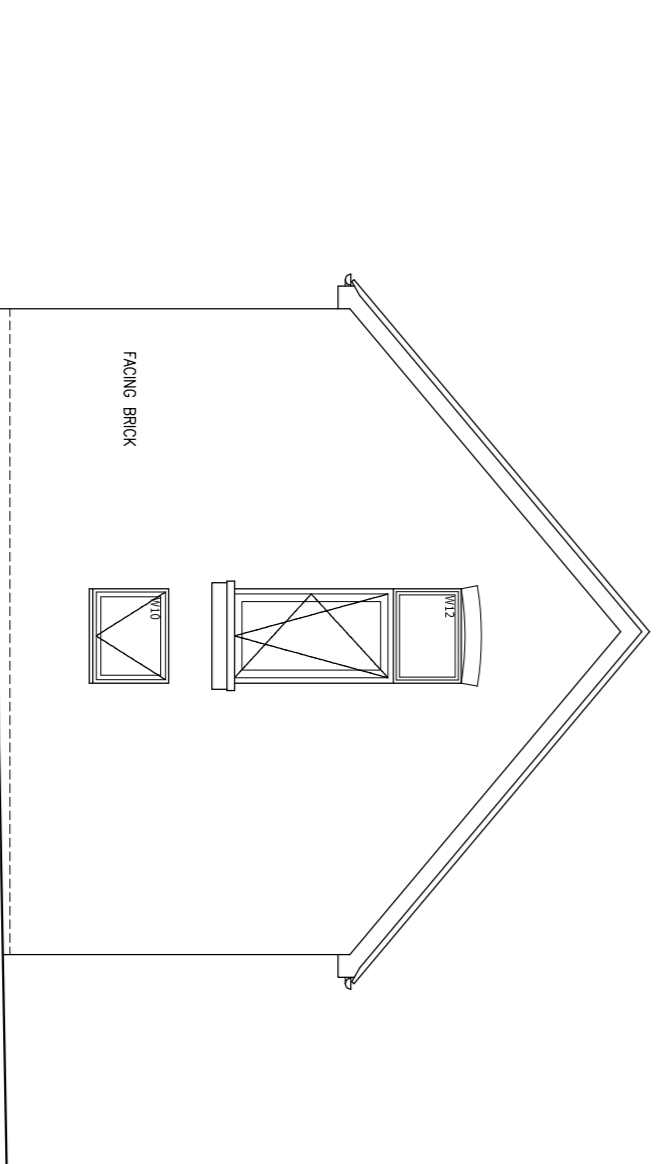

**MACHINERY SHED:
SIDE ELEVATION**

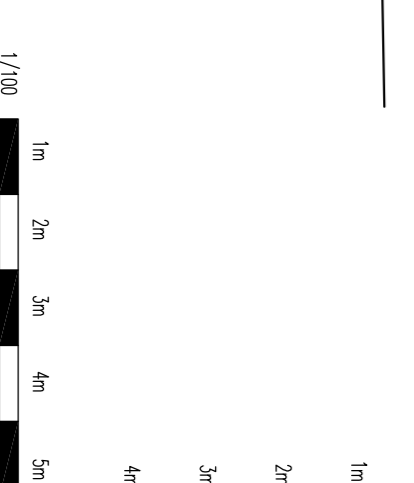

JOB No.	2109
DWG No.	PL10F
SCALE	1/100 @A1
DATE	JULY 2019
DRAWN	PH
CLIENT	

NYN MANOR
VINEYARDS ROAD
NORTHAW EN6 4PQ

AS BUILT
PLANS & ELEVATIONS

Wastell & Porter
Architects Limited

BANKROFT HOUSE
34 BANKROFT
HITCHIN
HERTFORDSHIRE
SG5 1LA

Email: contact@wastellporter.co.uk
Tel: 01462 42240
Fax: 01462 42003