




**MACHINERY SHED: FLOOR PLAN**

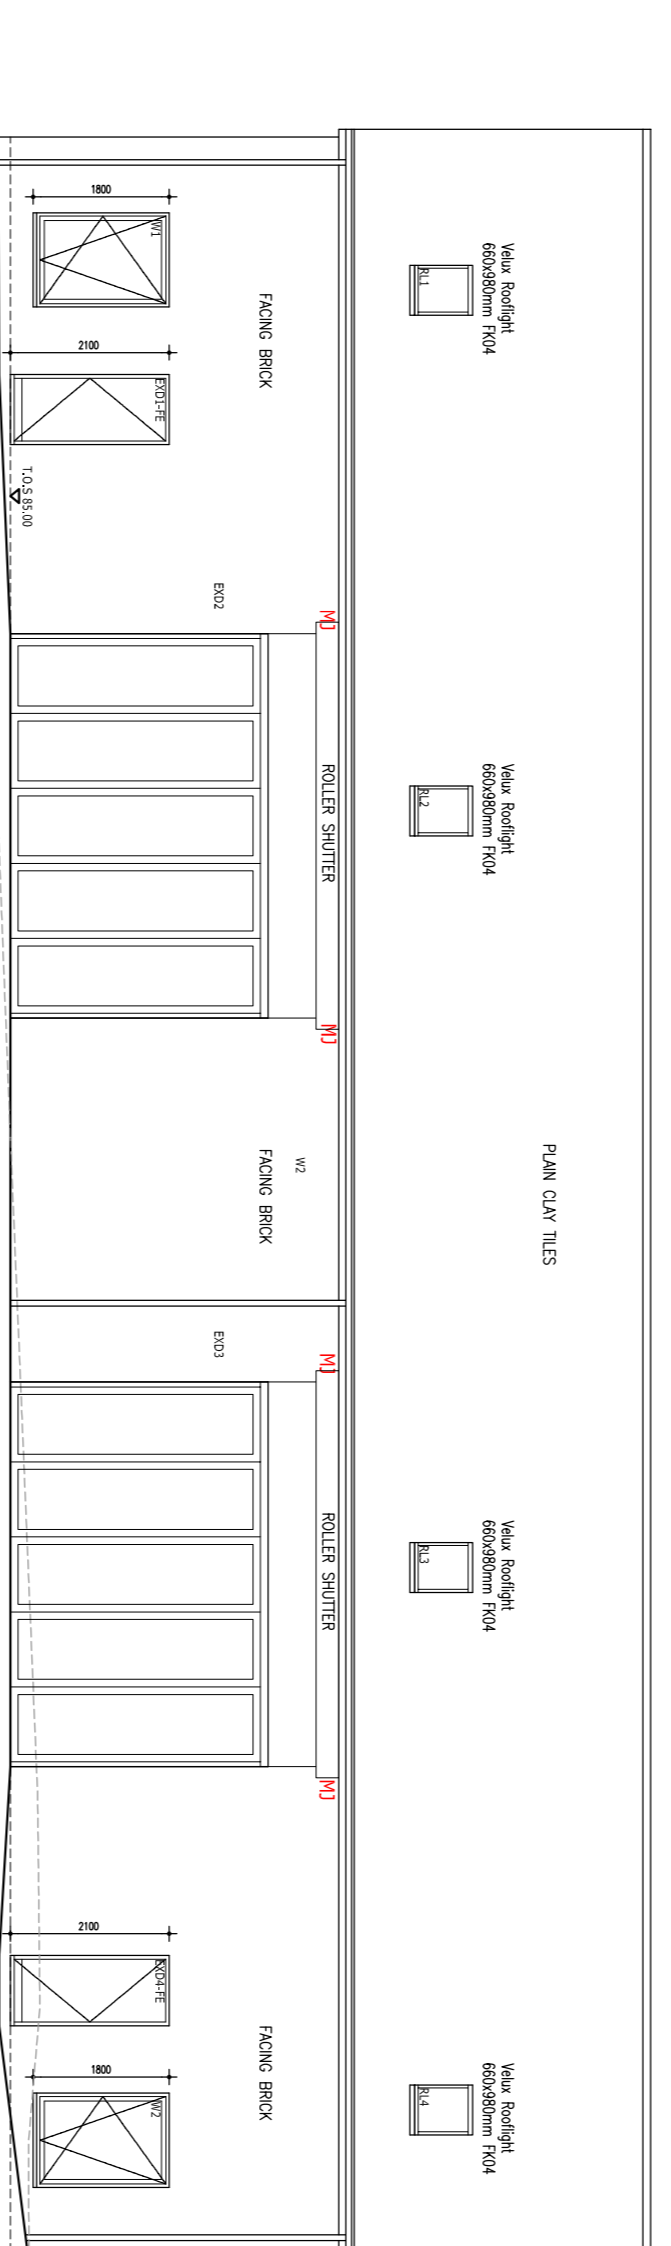


**MACHINERY SHED: FIELD ELEVATION**

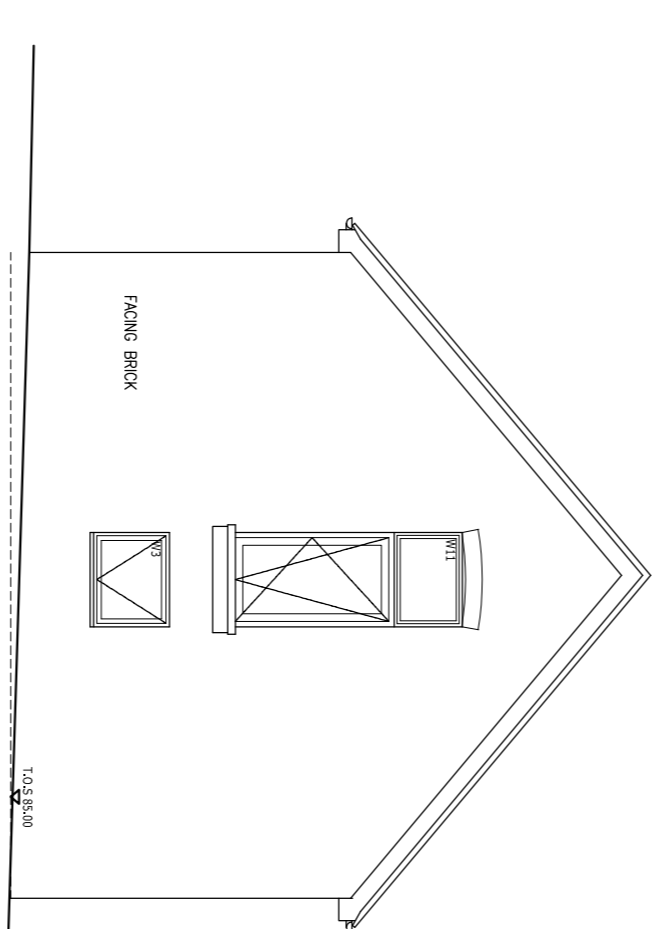


**MACHINERY SHED:  
SIDE ELEVATION**

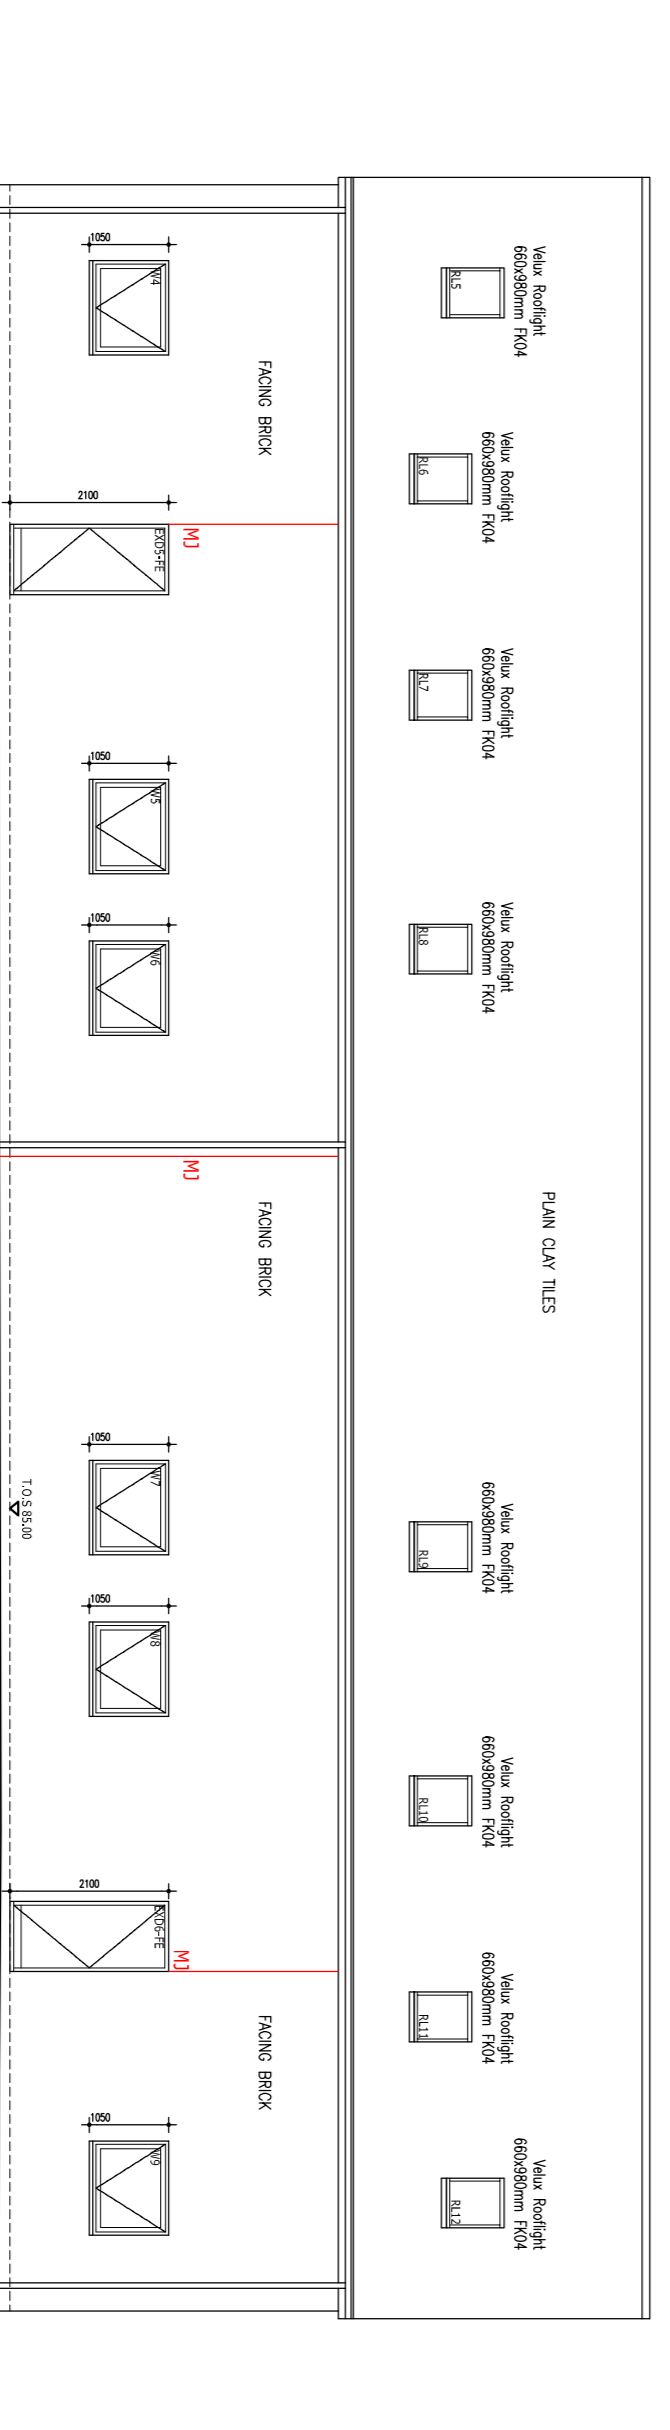

**MACHINERY SHED: OLD BARN ELEVATION**

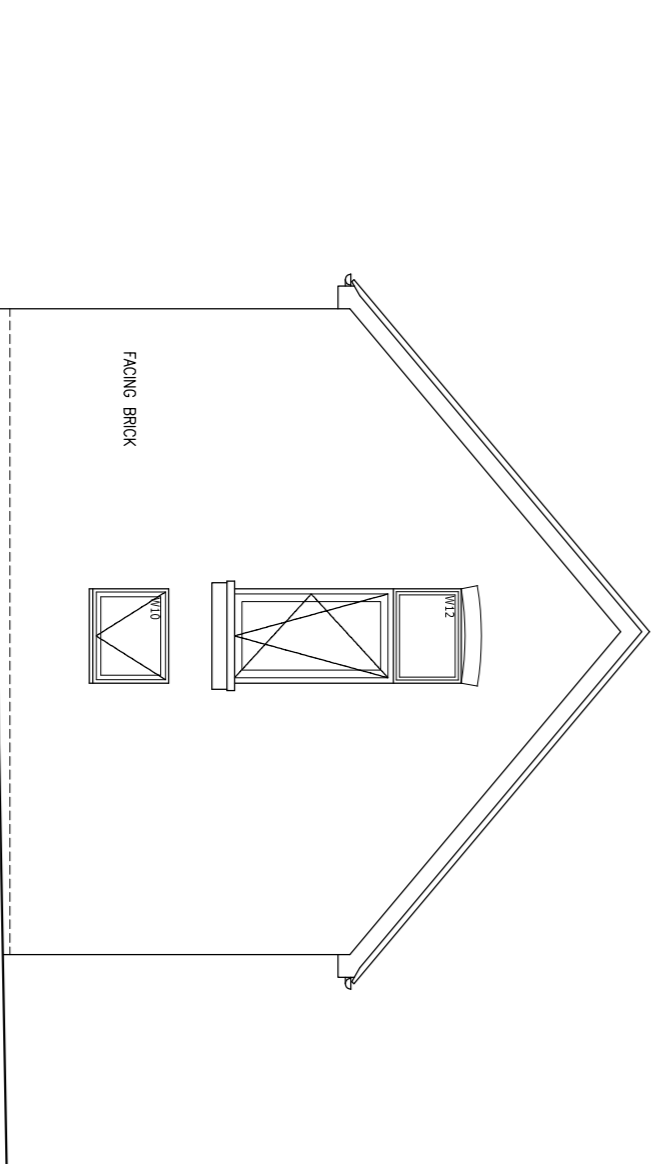

**MACHINERY SHED:  
SIDE ELEVATION**

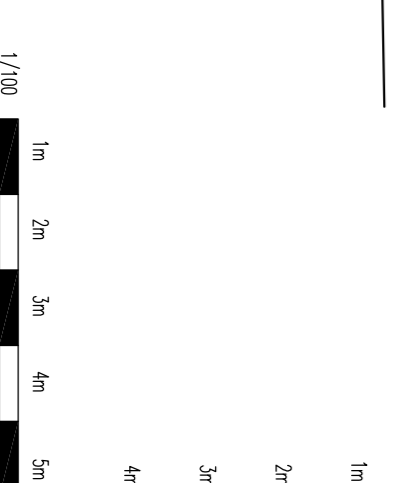

JOB No.	2109
DWG No.	PL10H
SCALE	1/100 @A1
DATE	JULY 2019
DRAWN	PH
CLIENT	

NYN MANOR  
VINEYARDS ROAD  
NORTHAW EN6 4PQ

AS BUILT  
PLANS & ELEVATIONS

**Wastell & Porter**  
Architects Limited

BANKROFT HOUSE  
34 BANKROFT  
HITCHIN  
HERTFORDSHIRE  
SG5 1LA

Email: [contact@wastellporter.co.uk](mailto:contact@wastellporter.co.uk)  
Tel: 01462 432440  
Fax: 01462 420003