




MACHINERY SHED: FLOOR PLAN

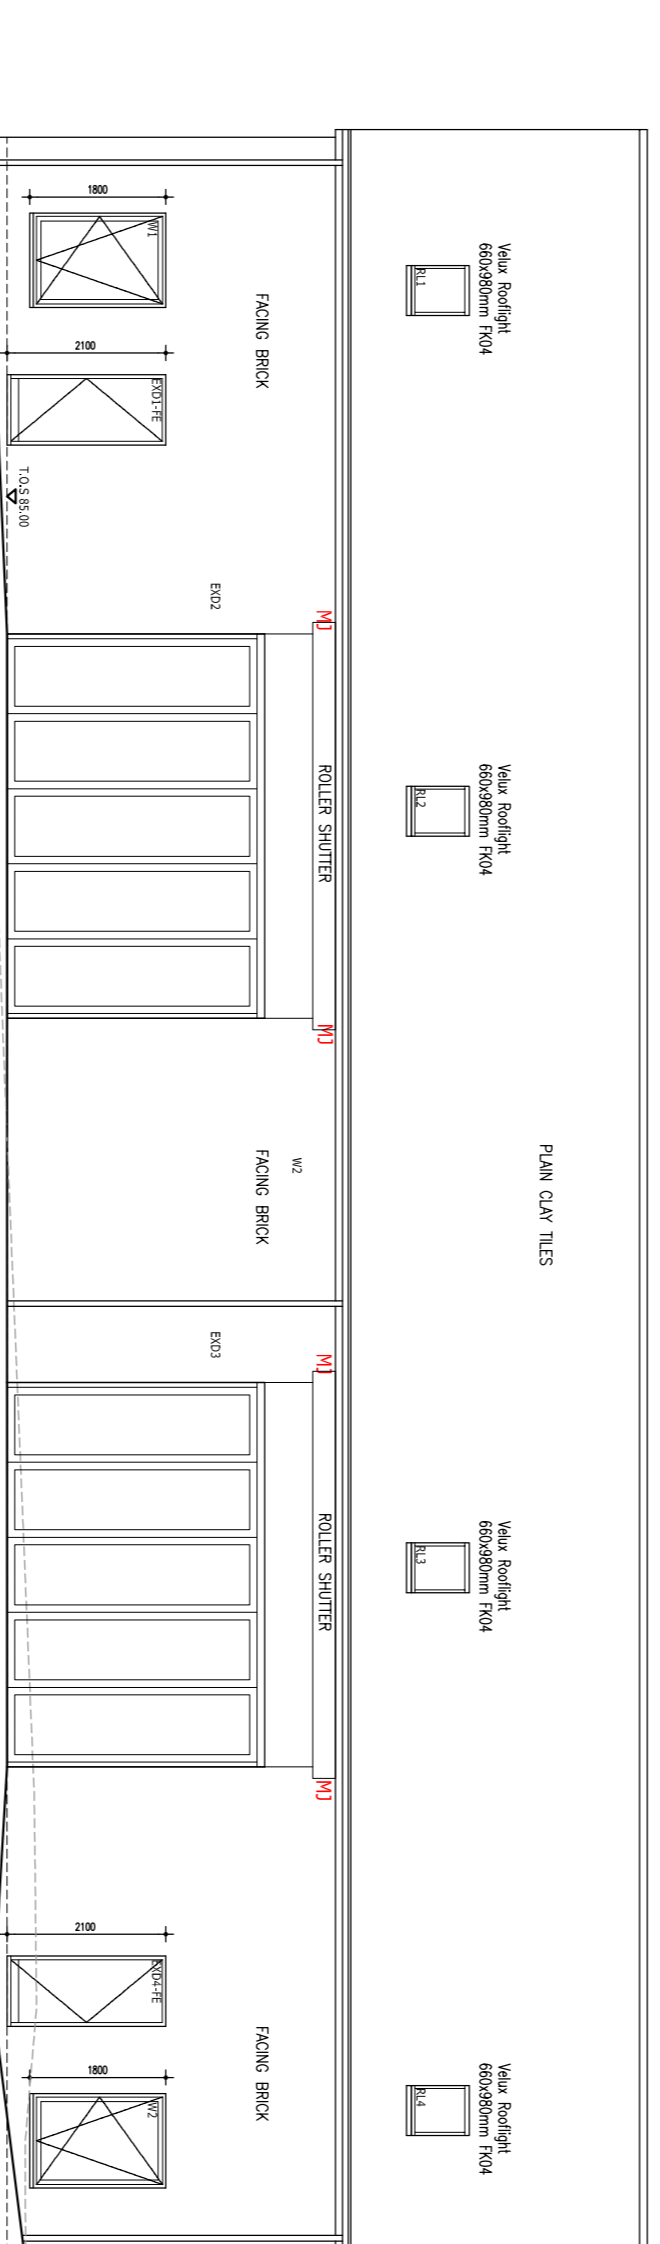


MACHINERY SHED: FIELD ELEVATION

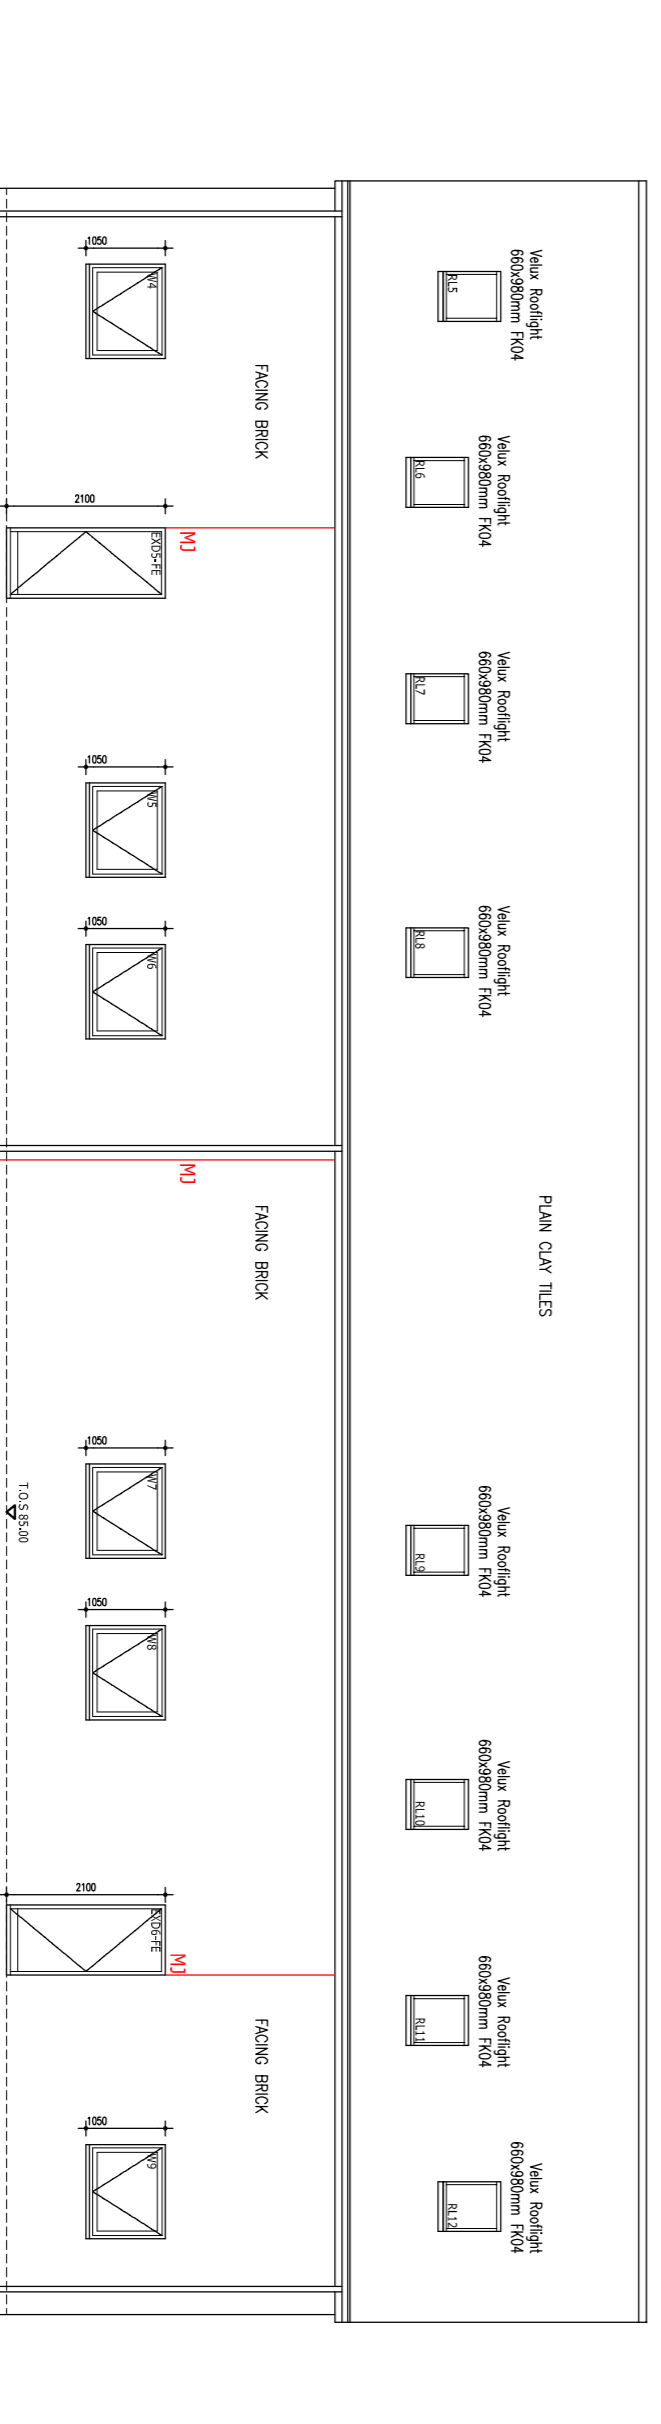


MACHINERY SHED: OLD BARN ELEVATION

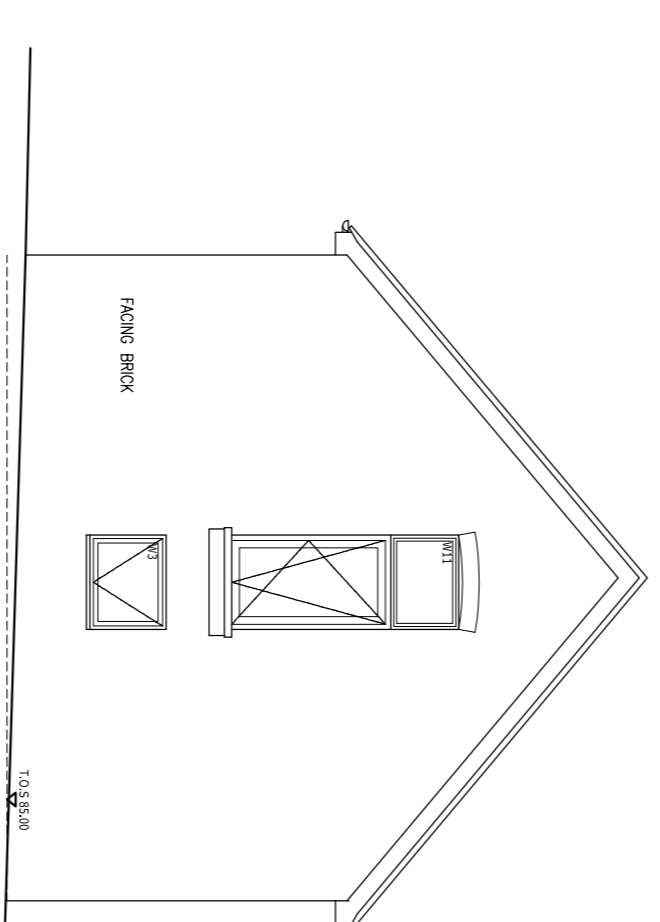

**MACHINERY SHED:
SIDE ELEVATION**

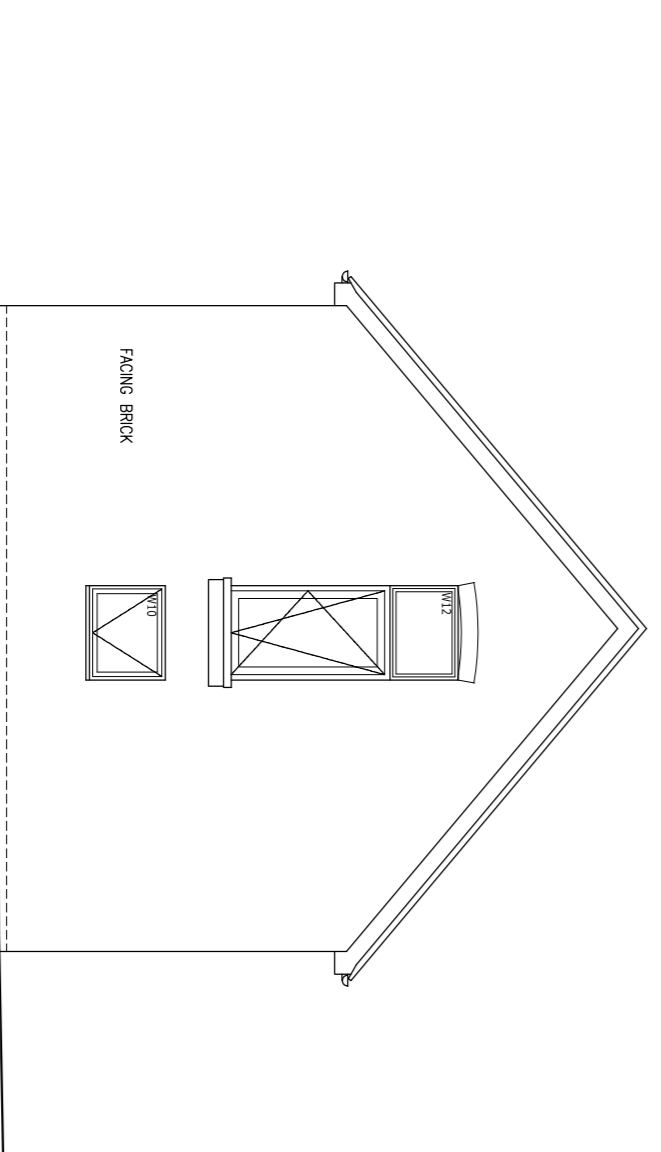

**MACHINERY SHED:
SIDE ELEVATION**

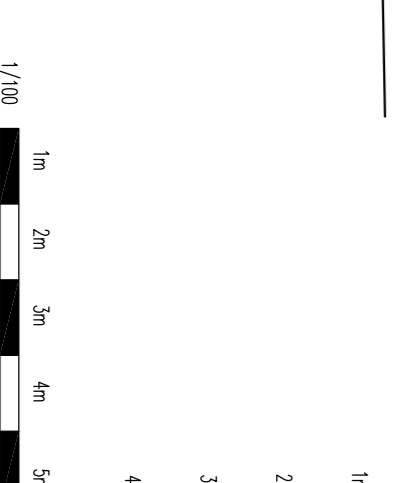

JOB No.	2109
DWG No.	PL11
SCALE	1/100 @A1
DATE	JULY 2019
DRAWN BY	PH
CLIENT	

NYN MANOR
VINEYARDS ROAD
NORTHAW ENG 4PQ

AS BUILT
PLANS & ELEVATIONS

Wastell & Porter
Architects Limited
BANCROFT HOUSE
34 BANCROFT
HITCHIN
HERTFORDSHIRE
SG5 1LA

Email: contact@wastellporter.co.uk
Tel: 01462 422400
Fax: 01462 420403