


This drawing is copyright and can not be copied or reproduced or altered, no extracts or any elements of this drawing or supporting information unless written consent has been obtained first.




FRONT ELEVATION
SCALE 1:100



REAR ELEVATION
SCALE 1:100

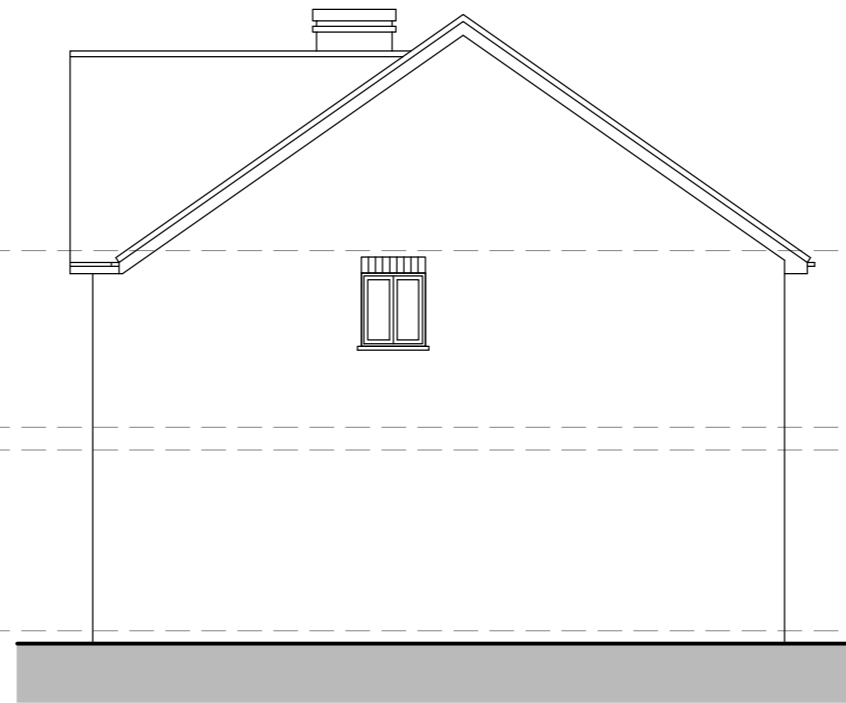


SIDE ELEVATION
SCALE 1:100

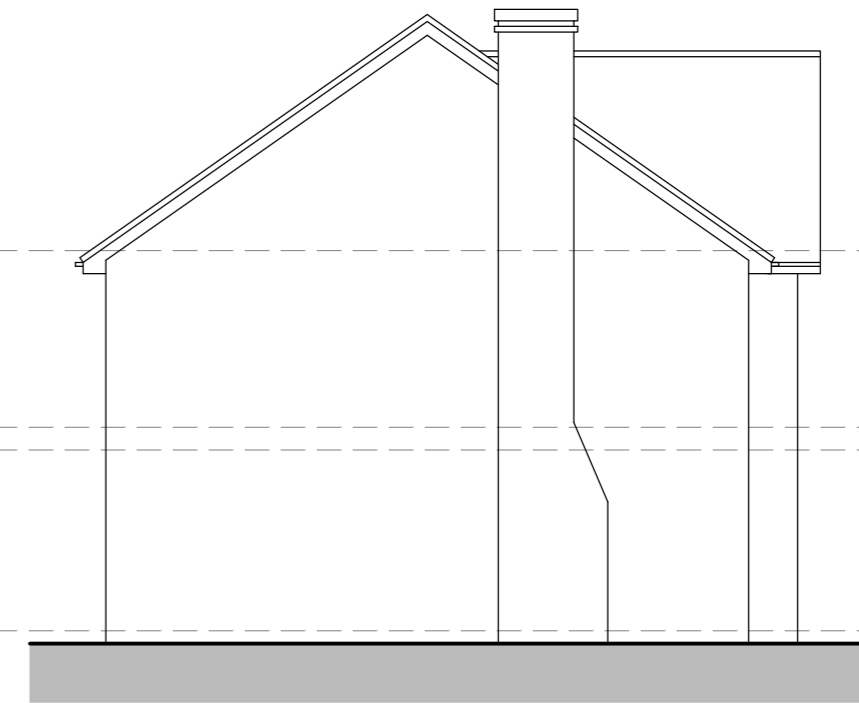


SIDE ELEVATION
SCALE 1:100




PROPOSED BLOCK PLAN
SCALE 1:500

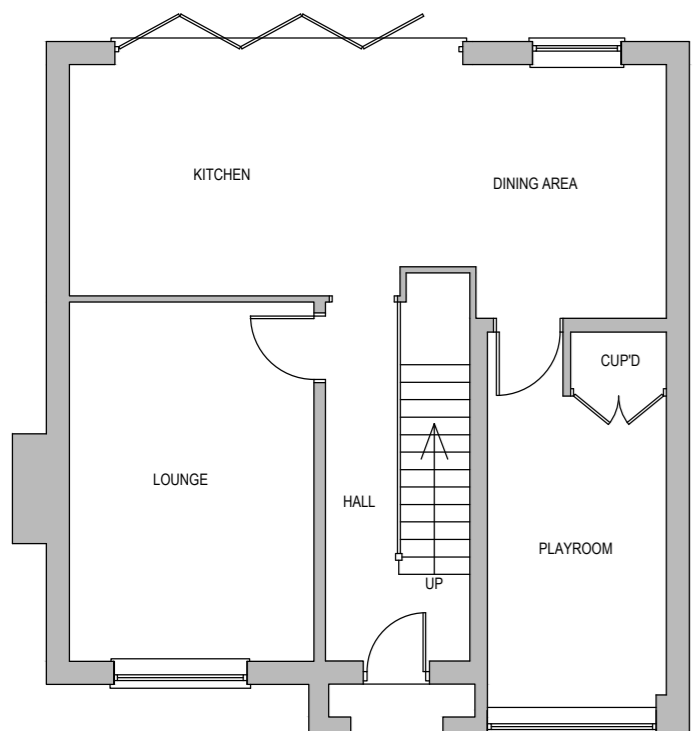


GROUND FLOOR PLAN
SCALE 1:100

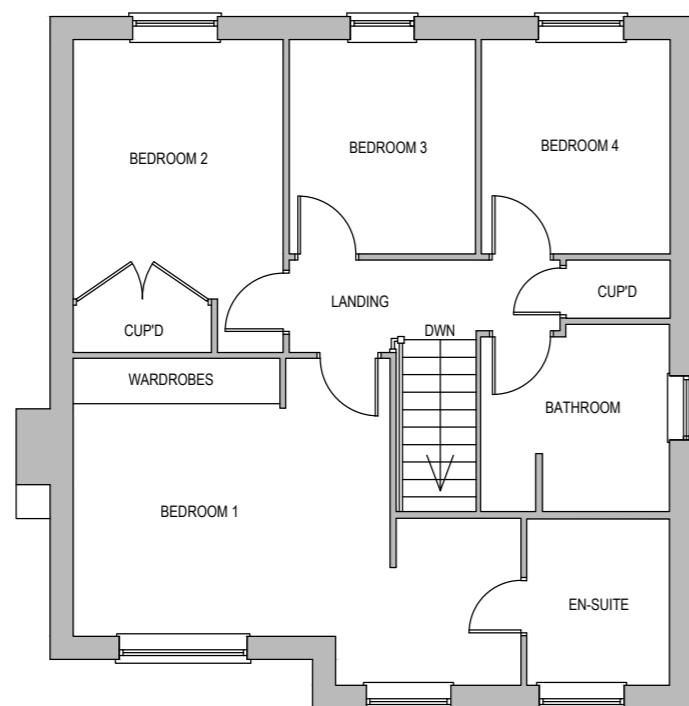



FIRST FLOOR PLAN
SCALE 1:100

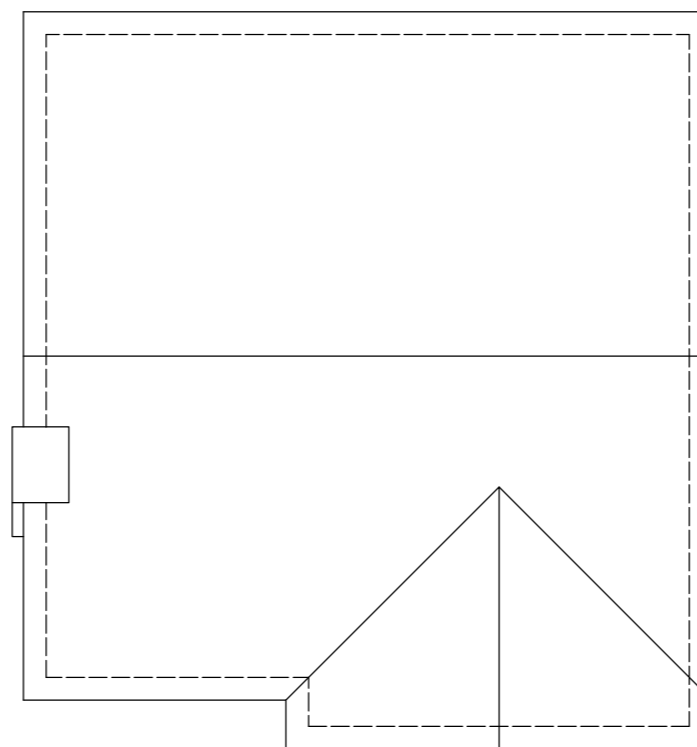

ROOF PLAN
SCALE 1:100

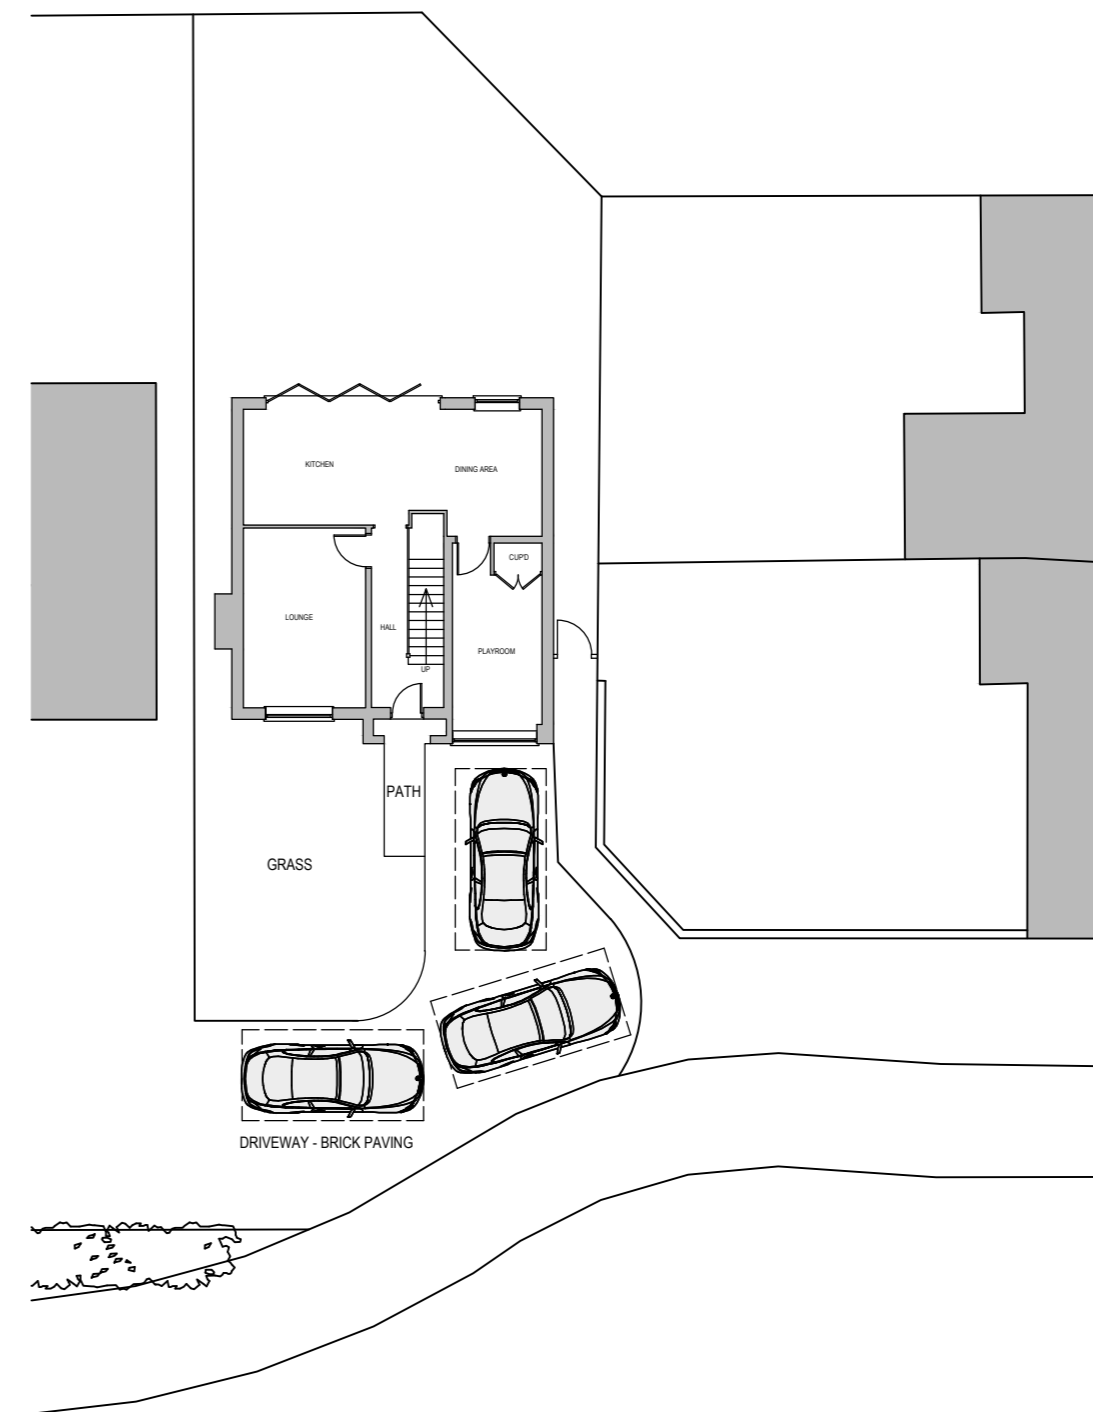

PROPOSED SITE LAYOUT (AS BUILT)
SCALE 1:200

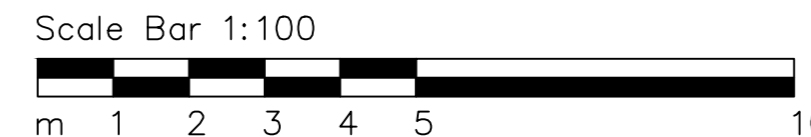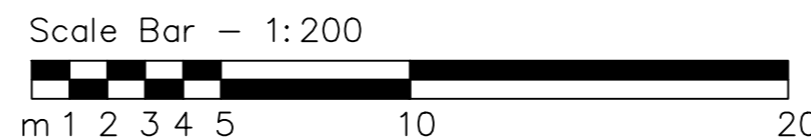

REV	DATE	DESCRIPTION

RTM Design
Architectural Services
Planning & Building Regulation Drawings

27 St. Andrews Close, Slip End, LU1 4DE
M 07979 575 456
E rtm.design@outlook.com

CLIENT
MR & MRS B HOLLAND

ADDRESS
8 ORCHID CLOSE
HATFIELD
HERTFORDSHIRE
AL10 9FE

TITLE
AS BUILT - PROPOSED PLANS AND
ELEVATIONS WITH BLOCK PLAN

SCALE - AS SHOWN @ A2 DATE - MARCH '21

JOB No.	DRAWING No.	REVISION
342	02	