
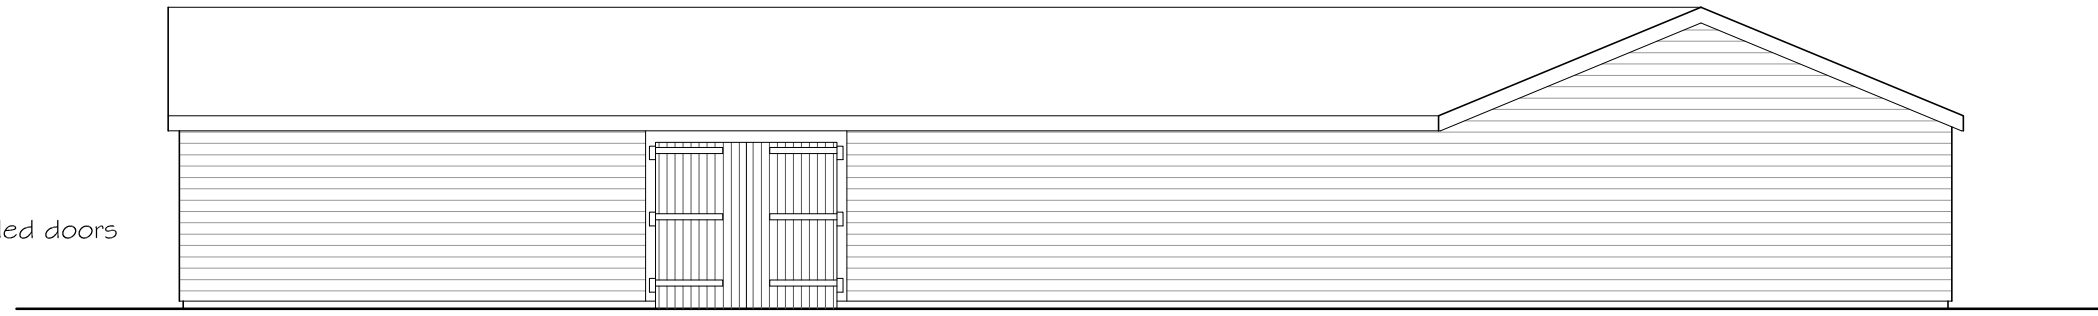


North West Elevation

timber boarded doors

plain clay tiled roof

timber weatherboarding

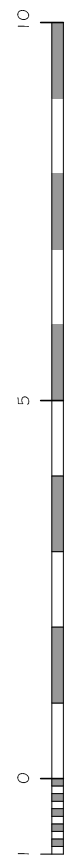 


South West Elevation

timber boarded doors

plain clay tiled roof


timber weatherboarding



South East Elevation

plain clay tiled roof

timber weatherboarding

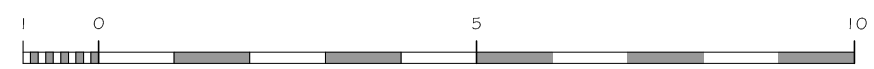

Rev A: Scale Bars added

PNA

2 The Coach House, Corneybury Farm
 Ermine Street, Buntingford, Herts SG9 9RS
 Tel: 01763 271292 / 01707 276595
 Copyright © email : info@pna.eclipse.co.uk ~~Do Not Scale~~

August 2016

WARREN WOOD MANOR
 Hornbeam Lane
 Essendon, Herts

Scale: 1:100

Date: November 2015

Maintenance & Groundsmans Store
 Elevations as Constructed : Sheet 1

Drg. No
 703 / 404A