
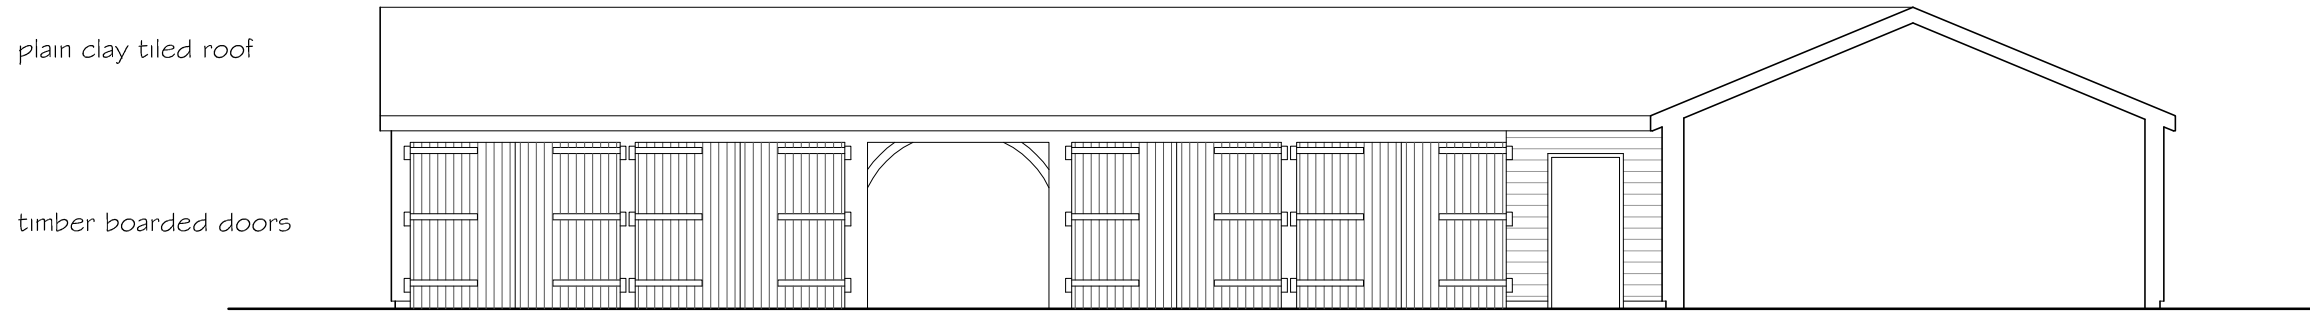


plain clay tiled roof

timber weatherboarding


North East Elevation

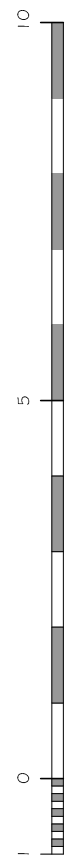

plain clay tiled roof

timber boarded doors

South West Elevation to Courtyard

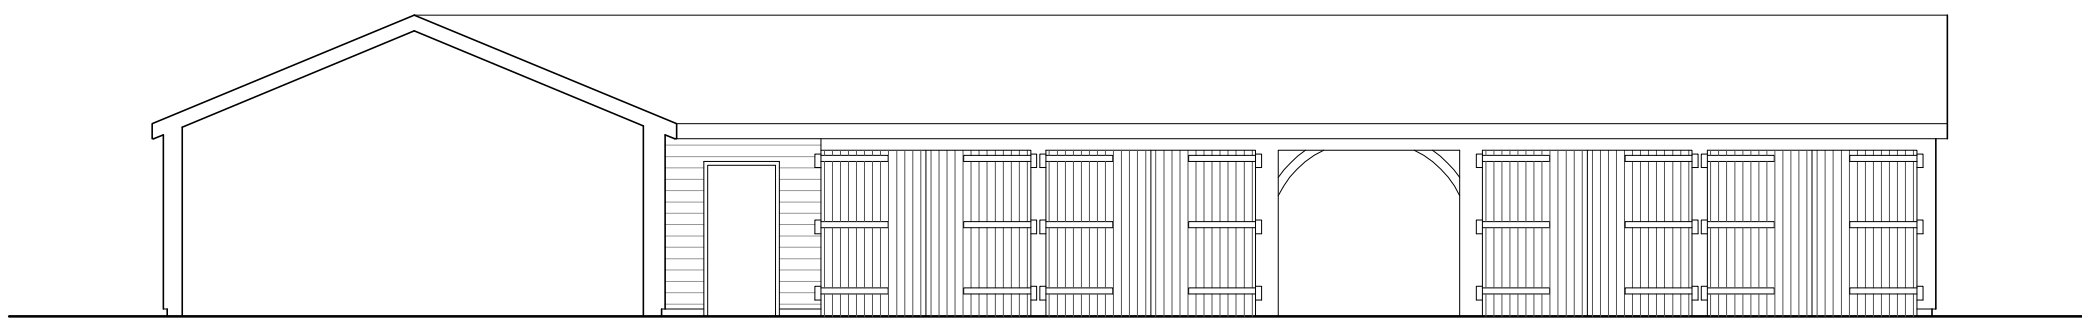


plain clay tiled roof

timber boarded doors

exposed timber framing

North East Elevation to Courtyard

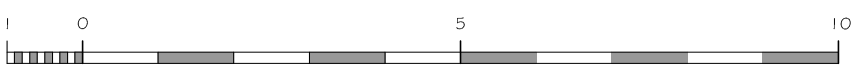

Rev A: Scale Bars added

**PNA**

2 The Coach House, Corneybury Farm  
 Ermine Street, Buntingford, Herts SG9 9RS  
 Tel: 01763 271292 / 01707 276595  
 Copyright © email : info@pna.eclipse.co.uk ~~Do Not Scale~~

August 2016

WARREN WOOD MANOR  
 Hornbeam Lane  
 Essendon, Herts

Scale: 1:100

Date: November 2015

Maintenance & Groundsmans Store  
 Elevations as Constructed : Sheet 2

Drg. No  
 703 / 405A