


PROPOSED WORKS
 EXISTING 3No. A0C4518R8x06 ANTENNAS TO BE RAISED ON NEW
 CRANKED ANTENNA SUPPORT POLES FOR ICNIRP COMPLIANCE

EE OPERATOR STATUS : **A**
 NOTE: A0C4518R8x06 ANTENNAS
 TO BE RAISED TO 27.6m FOR
 ICNIRP COMPLIANCE

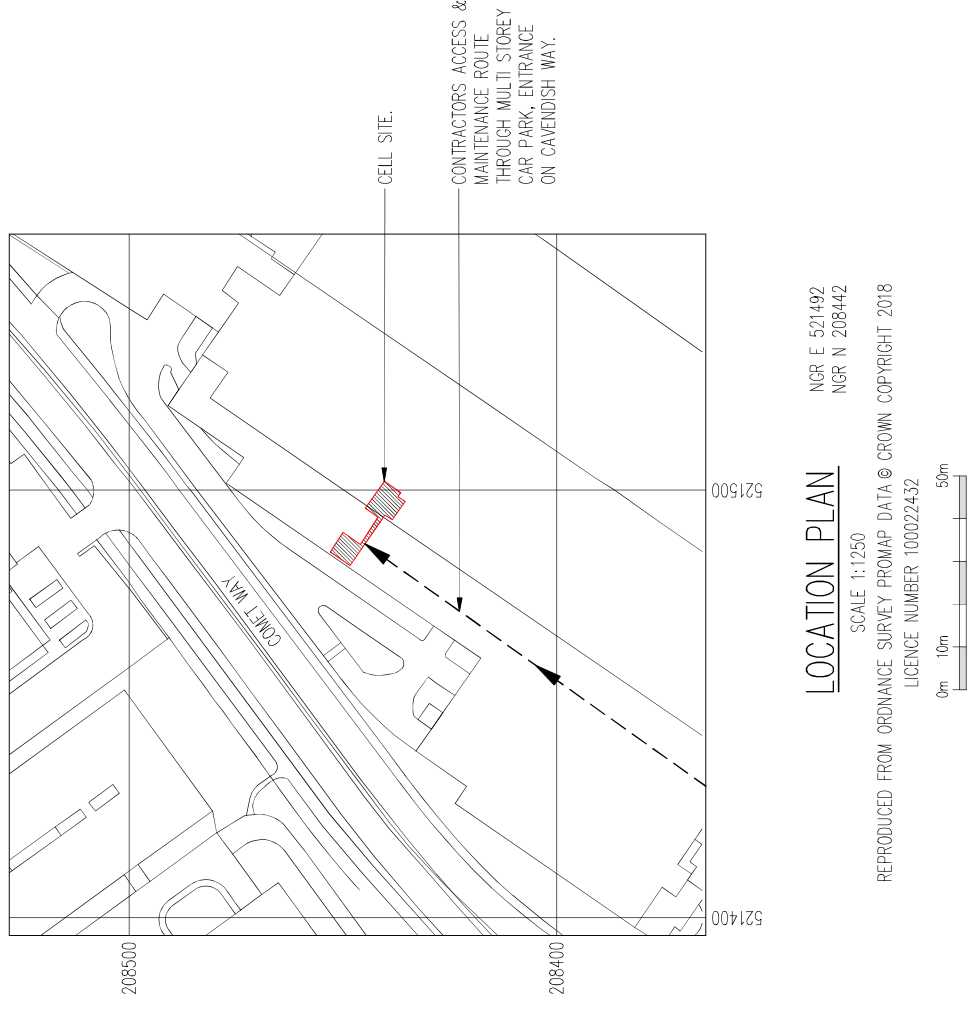

Fixt No: 56249
 Approved By: **Turner Townsend**
 Status Date: **14/04/2021**
 Comments: **PROX-5 RF Compliance Report 61149- THE GALLERIA Date of Assessment: 14/02/21 Assessor: Anthony Eye**
Fixt ID: 56249 Drawing Rev: Drawing Date: 08/03/2021 Project Strategy Lite Subject to Concrete >100mm: N/A Site has
been modelled in ProX5 using drawings provided by WHP: 08/03/2021 WEH010 THE GALLERIA_61149_EE Strategy
Lite-interim_01-24_A5_PA Previous Fixt 23150 was assessed previously, assuming that the upper level was occupiable. A
only, due to the presence of comms room, AC units etc. However, it has now been identified as public accessible. A
ProX-5 assessment is required to identify the design changes required before going in to build. Operators on Site EE,
H3C, Sector A - T&A Step 4.0 - is Not Compliant, Sector B - T&A Step 4.0 - is Not Compliant, Sector C - T&A Step 4.0
- is Not Compliant It has been identified to achieve ICNIRP compliance, the proposed AOC antennas require raising by 1m
from 26.6m to 27.6m C/A, CONTRACTOR DUE DILIGENCE: The provision of suitable access controls / signage / awareness
is required to restrict access. Enquiries - MBULRFCompliance@turntown.co.uk

ALL DIMENSIONS IN
 MILLIMETRES UNLESS
 NOTED OTHERWISE

No.	Revision	Date	By	ckd
A7	NEW POLES PROPOSED FOR ANTENNA RAISE	21.09.21	JWS	JWS
A6	ICNIRP FIXT NOTES ADDED	06.03.21	JWS	JWS
A5	AS BUILT	27.09.19	RG	AW
A4	UPDATED AS PER CALCS. F/S FRAMES REMOVED	18.06.19	JWS	MA
A3	OVER-PLATE WALL DETAILS AMENDED	14.06.19	JWS	MA
A2	OVER-PLATE DETAILS ADDED	22.01.19	NP	AW
A1	PRELIMINARY ISSUE FOR COMMENT	15.11.18	CDH	AW



WHP Telecoms Ltd
 Unit 1 Maple Park
 Lowlands Road, Leeds
 LS12 6HH
 Tel: 0113 3023550 Fax: 0113 2878654
 email: info@whptelecoms.com

Site Name & Address:
**THE GALLERIA, COMET WAY
 HATFIELD, HERTFORDSHIRE
 AL10 0XR**

Title:
**TELECOMMUNICATIONS
 ROOFTOP UPGRADE
 SITE LOCATION**

Purpose of Issue:
PLANNING

Drawing No:
WEH010 - 01

Cell ID:	61149	Site ID:	835101	MBNL ID:	WEH010
Issue:	A7	Scale:	AS STATED	Ch'd:	AW
		Dwn:	CDH	Date:	14.11.18
		App:	AW	Date:	15.11.18

DEPENDENCY	REQUIRED	OUTCOME
LOS required?	N/A	N/A
Asbestos report	Yes	Report Checked- Controlled Hazard
Building Regulations	N/A	N/A
Electrical survey	N/A	N/A
GDC required?	N/A	N/A
Structural survey/ Cuts/Conformity?	Yes	Completed Internally See Declaration
Flagging survey?	N/A	N/A
GRP required?	N/A	N/A
REC type	Three Phase 100A REC	No Upgrade required
Cooling Check	N/A	Cooling Sufficient
ICNIRP Conformity	Yes	ICNIRP Pass - FIXT Submitted
FIXT submitted?	Yes	Submitted
CR (change request)?	N/A	N/A
Other	N/A	N/A

EXCLUSION ZONES CONFORM TO THE ICNIRP
 REFERENCE LEVEL FOR LIMITED EXPOSURE TO
 MEMBERS OF THE GENERAL PUBLIC