


light stained boarding
on brick base

SOUTH EAST ELEVATION

plain tiled roof


Oak posts on brick base

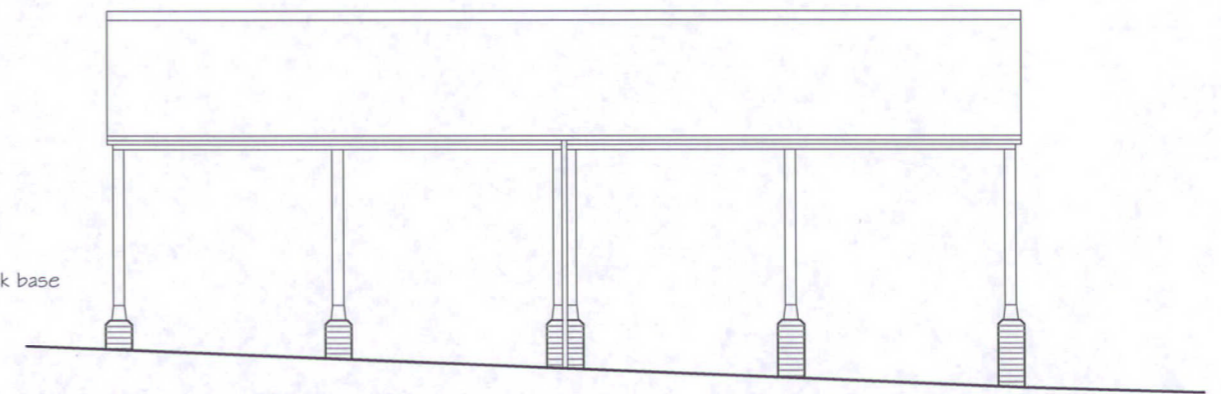


NORTH EAST ELEVATION

plain tiled roof


light stained boarding
on brick base

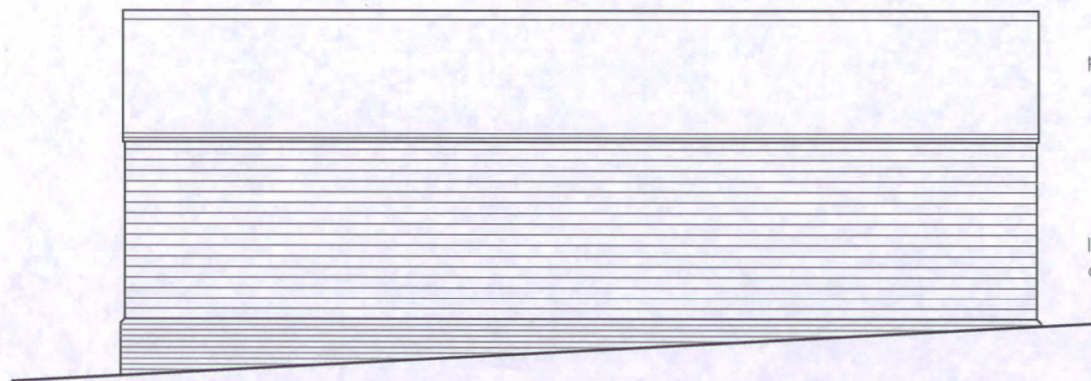


SOUTH WEST ELEVATION

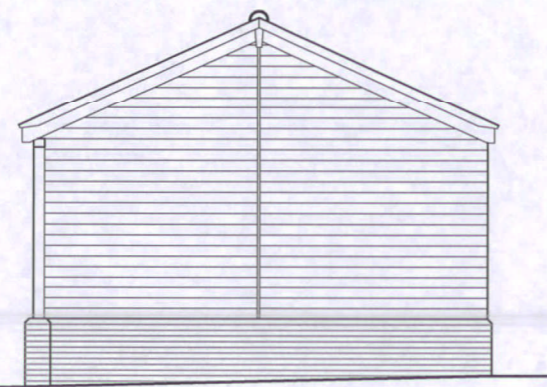

NORTH WEST ELEVATION

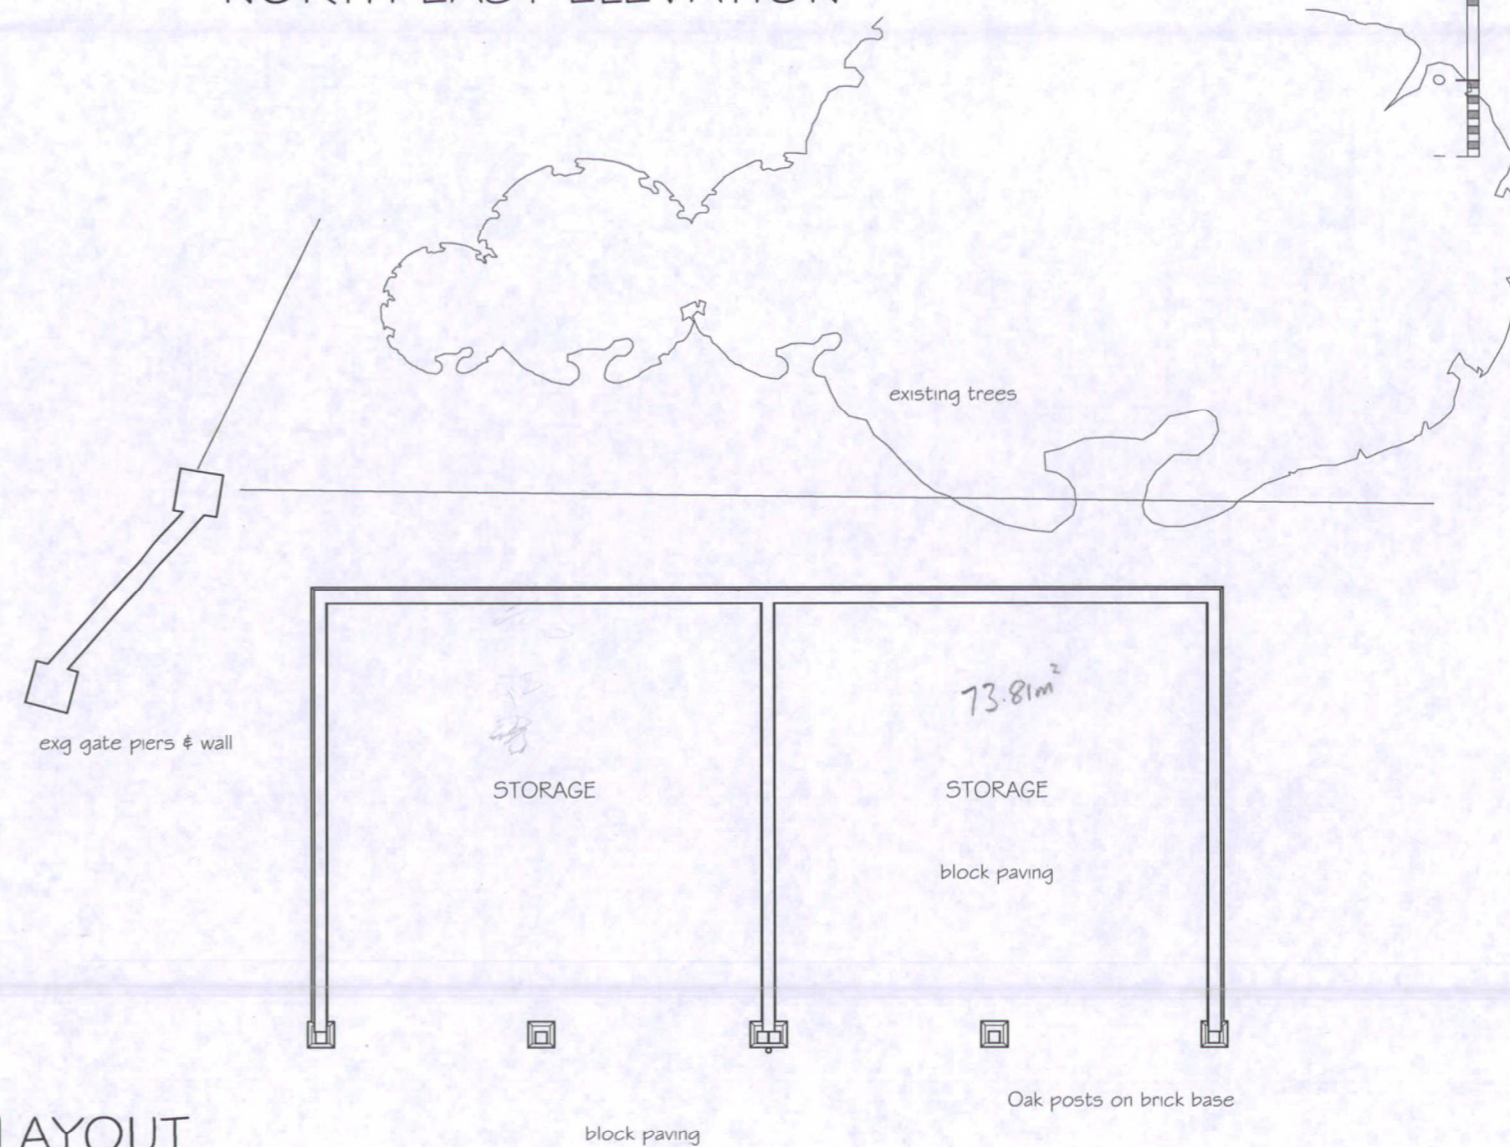

LAYOUT

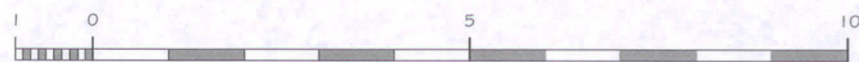

PNA

2 The Coach House, Comeybury Farm
Ermine Street, Buntingford, Herts SG9 9RS
Tel: 01763 271292 / 01707 276595
Copyright © email : info@pna.eclipse.co.uk ~~Do Not Scale~~

Warrenwood Manor
Hornbeam Lane
Essendon, Herts

Scale: 1:100
Date: May 2015

Timber Framed Storage Building
Plan and Elevations as constructed

Drg. No
703 / 201