
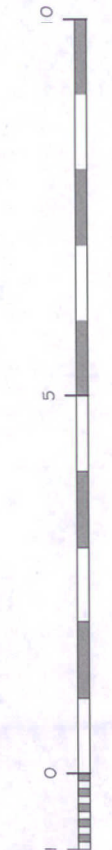


$A = \pi \times (10.2)^2 = 326.85m^2$
 + 73.81
 $400.66m^2 = 0.4h$

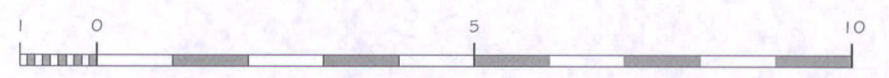

PNA

2 The Coach House, Comeybury Farm
 Ermine Street, Buntingford, Herts SG9 9RS
 Tel: 01763 271292 / 01707 276595
 Copyright © email : info@pna.eclipse.co.uk ~~Do Not Scale~~

Warrenwood Manor
 Hornbeam Lane
 Essendon, Herts

Scale: 1:100
 Date: May 2015

Horse Walker
 Plan as constructed

Drg. No
 703 / 202