




South Elevation

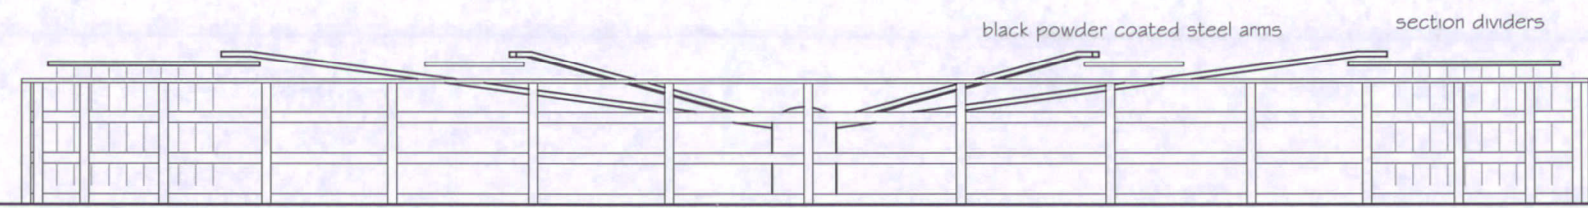


East Elevation

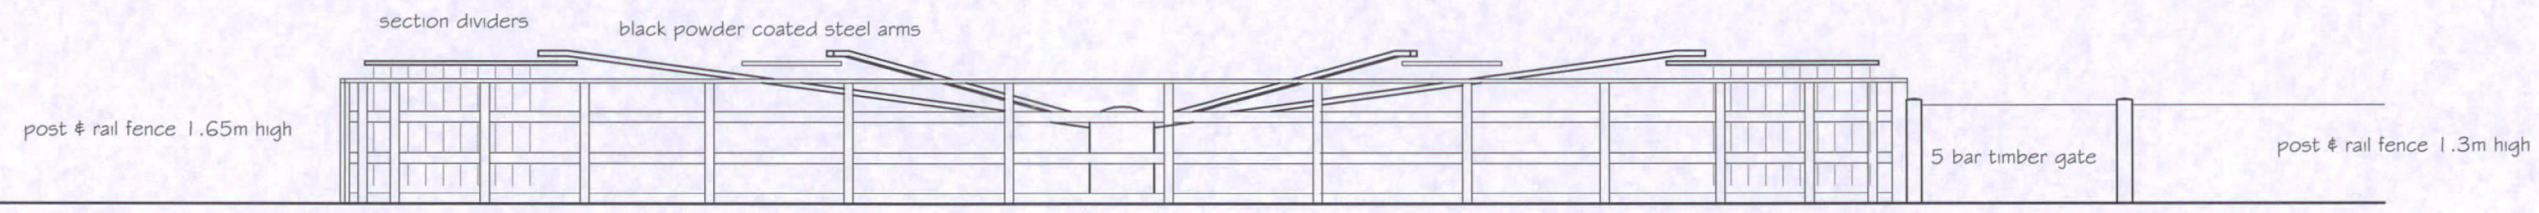

North Elevation

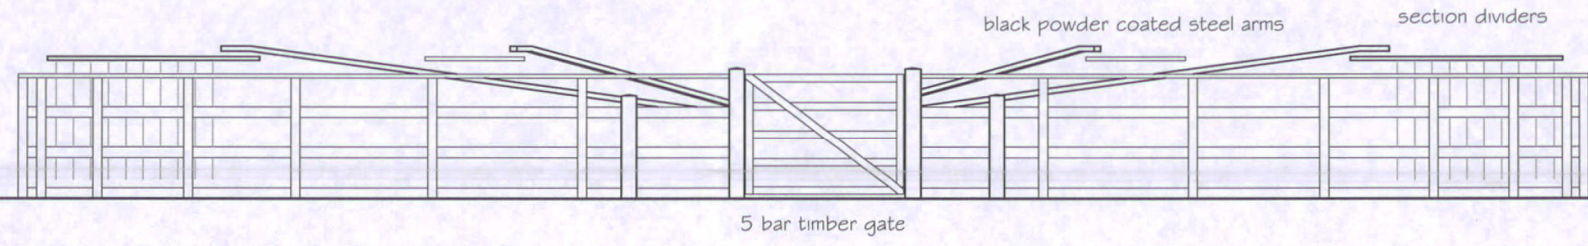

West Elevation

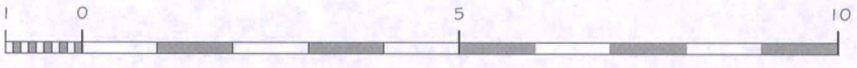

PNA

2 The Coach House, Corneybury Farm
 Ermine Street, Buntingford, Herts SG9 9RS
 Tel: 01763 271292 / 01707 276595
 Copyright © email : info@pna.eclipse.co.uk ~~Do Not Scale~~

Warrenwood Manor
 Hornbeam Lane
 Essendon, Herts

Scale: 1:100
 Date: May 2015

Horse Walker
 Elevations as constructed

Drwg. No
 703 / 203