


light stained boarding
on brick base


SOUTH EAST ELEVATION

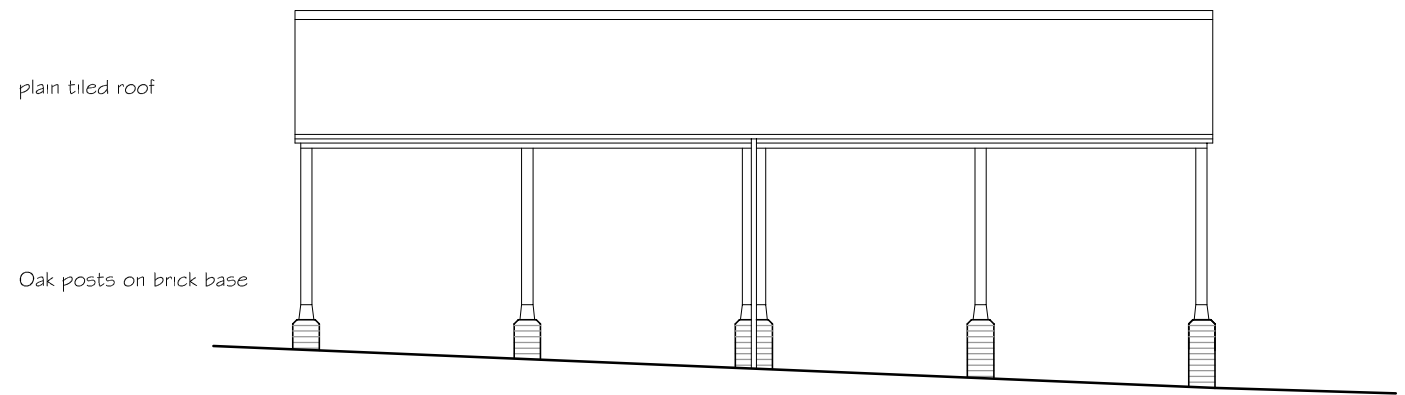

plain tiled roof

Oak posts on brick base


NORTH EAST ELEVATION

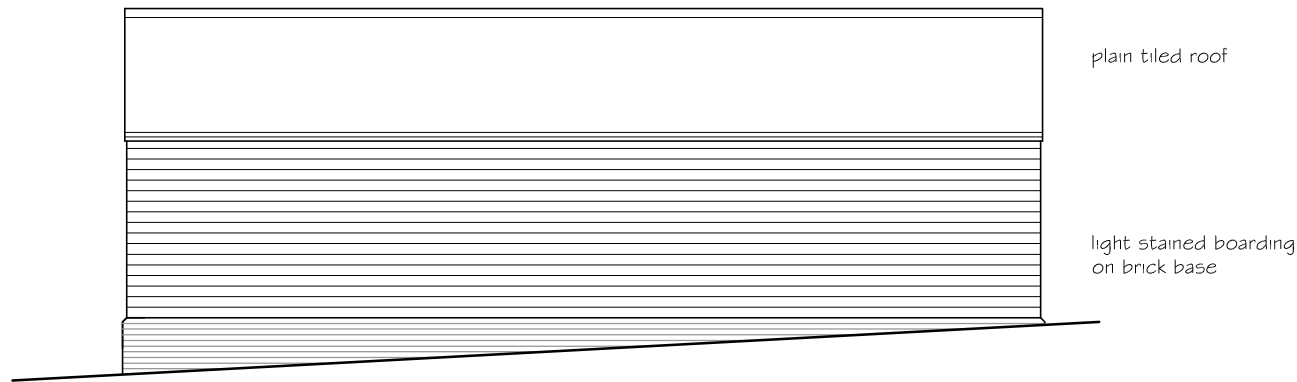



plain tiled roof

light stained boarding
on brick base


SOUTH WEST ELEVATION

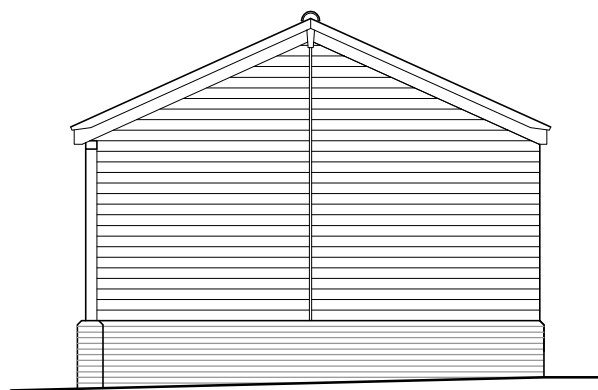

NORTH WEST ELEVATION

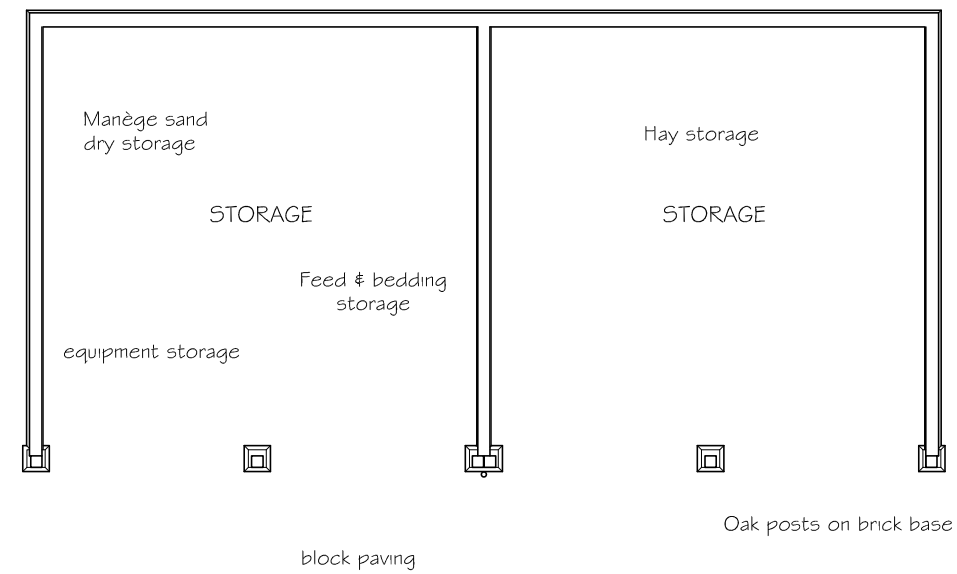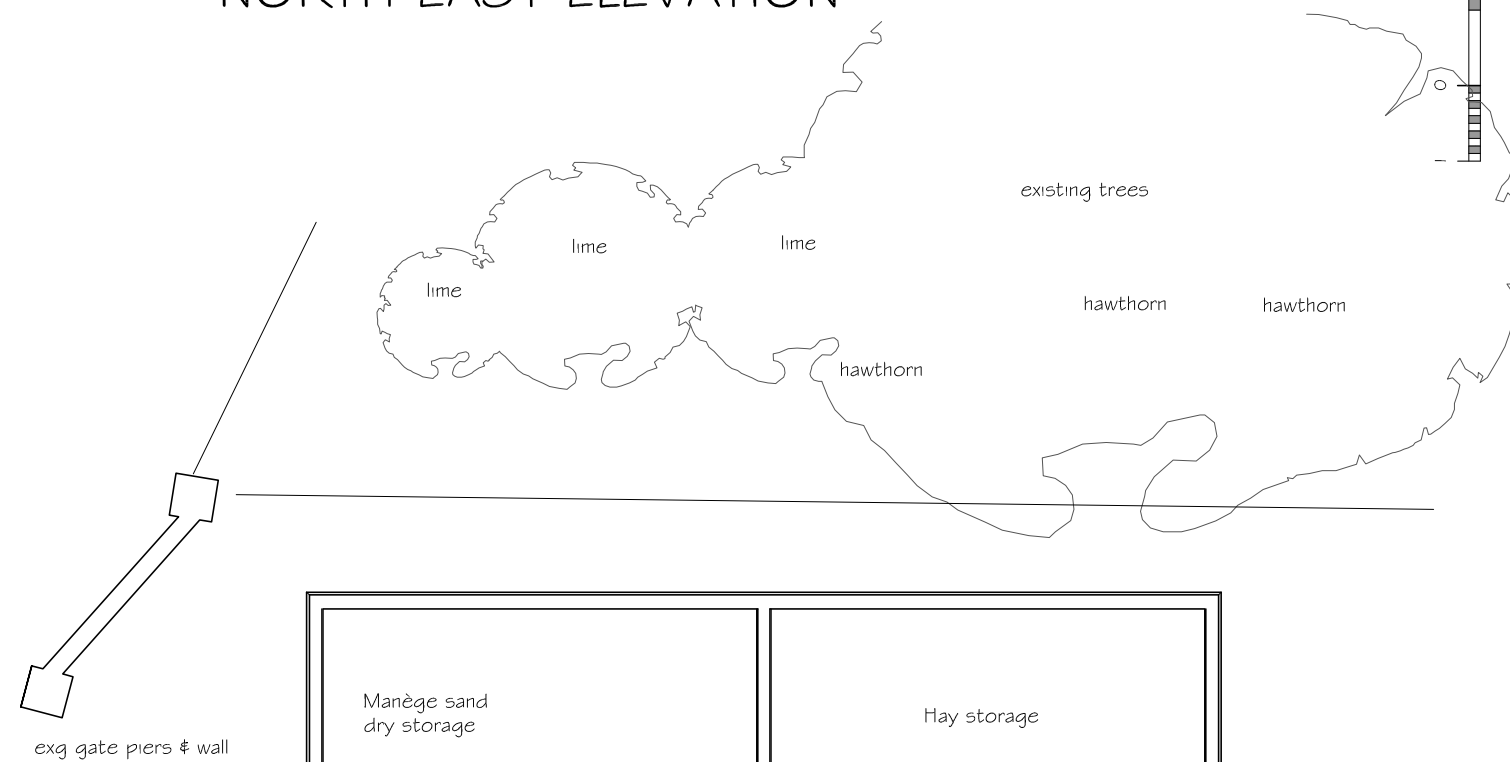

LAYOUT

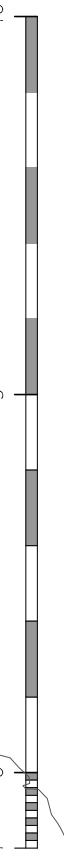

PNA

2 The Coach House, Corneybury Farm
Ermine Street, Buntingford, Herts SG9 9RS
Tel: 01763 271292 / 01707 276595
Copyright © email : info@pna.eclipse.co.uk ~~Do Not Scale~~

Warrenwood Manor
Hornbeam Lane
Essendon, Herts

Scale: 1:100
Date: May 2015

Timber Framed Storage Building
Plan and Elevations as constructed

Drg. No
703 / 201A