
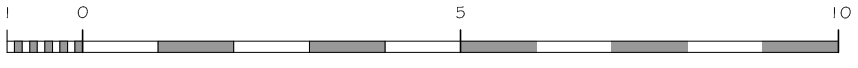


oil tank & base

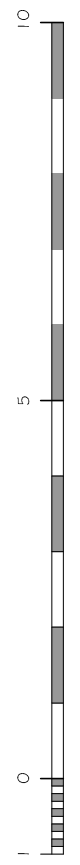

LAYOUT

Rev A: Scale Bars added

**PNA**

2 The Coach House, Corneybury Farm  
 Ermine Street, Buntingford, Herts SG9 9RS  
 Tel: 01763 271292 / 01707 276595  
 Copyright © email : info@pna.eclipse.co.uk ~~Do Not Scale~~

August 2016

WARREN WOOD MANOR  
 Hornbeam Lane  
 Essendon, Herts

Scale: 1:100

Date: November 2015

Maintenance & Groundsmans Store  
 Floor Layout as Constructed

Drg. No  
 703 / 402A