


plain clay tiled roof

plain clay tiled roof

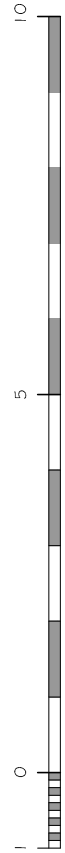

Rev A: Scale Bars added

PNA

2 The Coach House, Corneybury Farm
 Ermine Street, Buntingford, Herts SG9 9RS
 Tel: 01763 271292 / 01707 276595
 Copyright © email : info@pna.eclipse.co.uk ~~Do Not Scale~~

WARREN WOOD MANOR
 Hornbeam Lane
 Essendon, Herts

August 2016
 Scale: 1:100
 Date: November 2015

Maintenance & Groundsmans Store
 Roof Plan as Constructed

Drg. No
 703 / 403A

ROOF PLAN

