
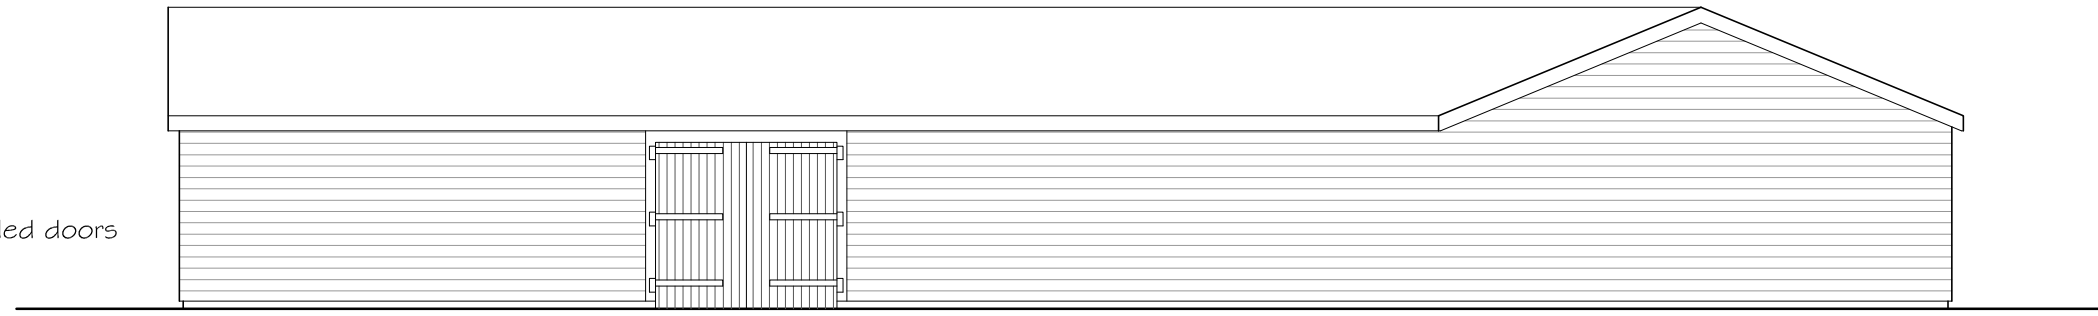


North West Elevation

timber boarded doors

plain clay tiled roof

timber weatherboarding

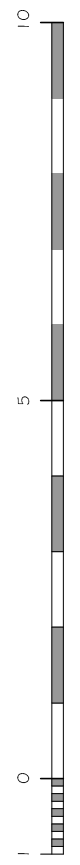 


South West Elevation

timber boarded doors

plain clay tiled roof

timber weatherboarding



South East Elevation

plain clay tiled roof

timber weatherboarding



Rev A: Scale Bars added

**PNA**

2 The Coach House, Corneybury Farm  
 Ermine Street, Buntingford, Herts SG9 9RS  
 Tel: 01763 271292 / 01707 276595  
 Copyright © email : info@pna.eclipse.co.uk ~~Do Not Scale~~

August 2016

WARREN WOOD MANOR  
 Hornbeam Lane  
 Essendon, Herts

Scale: 1:100

Date: November 2015

Maintenance & Groundsmans Store  
 Elevations as Constructed : Sheet 1

Drg. No  
 703 / 404A