
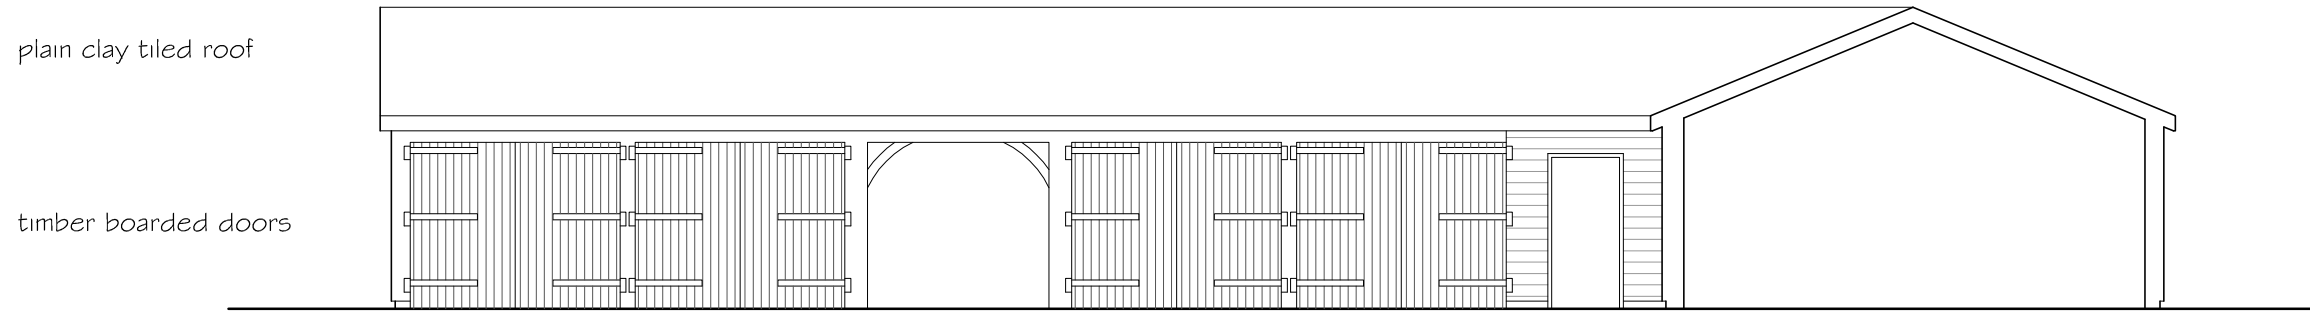


plain clay tiled roof

timber weatherboarding


North East Elevation

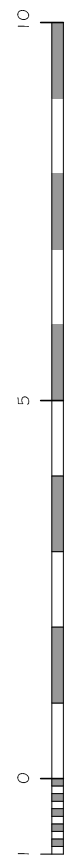

plain clay tiled roof

timber boarded doors

South West Elevation to Courtyard

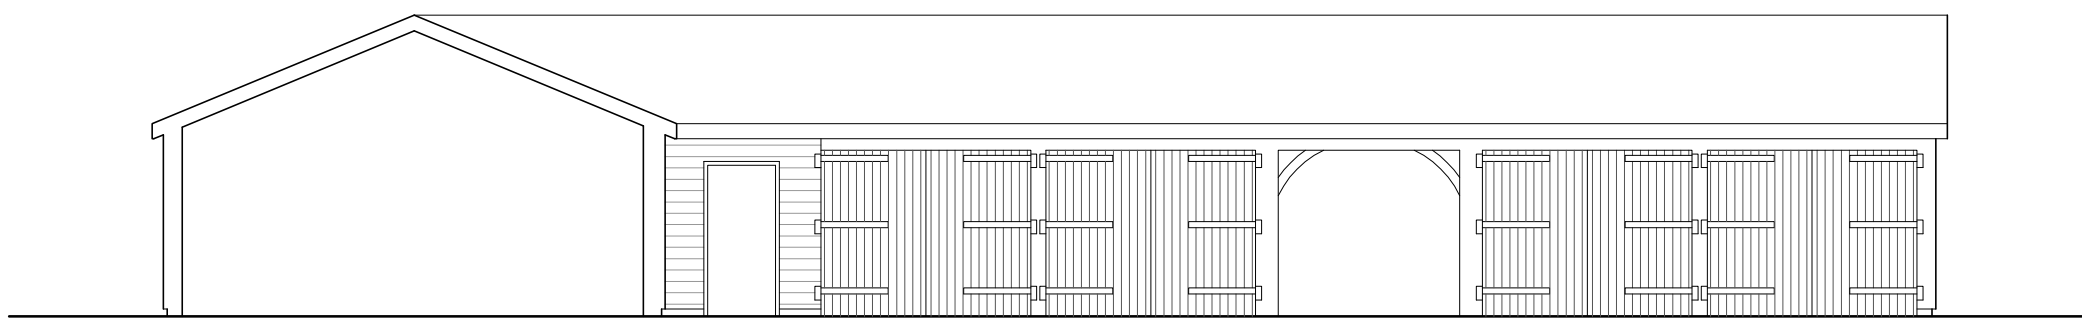


plain clay tiled roof

timber boarded doors

exposed timber framing

North East Elevation to Courtyard

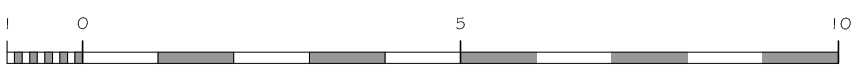

Rev A: Scale Bars added

PNA

2 The Coach House, Corneybury Farm
 Ermine Street, Buntingford, Herts SG9 9RS
 Tel: 01763 271292 / 01707 276595
 Copyright © email : info@pna.eclipse.co.uk ~~Do Not Scale~~

August 2016

WARREN WOOD MANOR
 Hornbeam Lane
 Essendon, Herts

Scale: 1:100

Date: November 2015

Maintenance & Groundsmans Store
 Elevations as Constructed : Sheet 2

Drg. No
 703 / 405A