
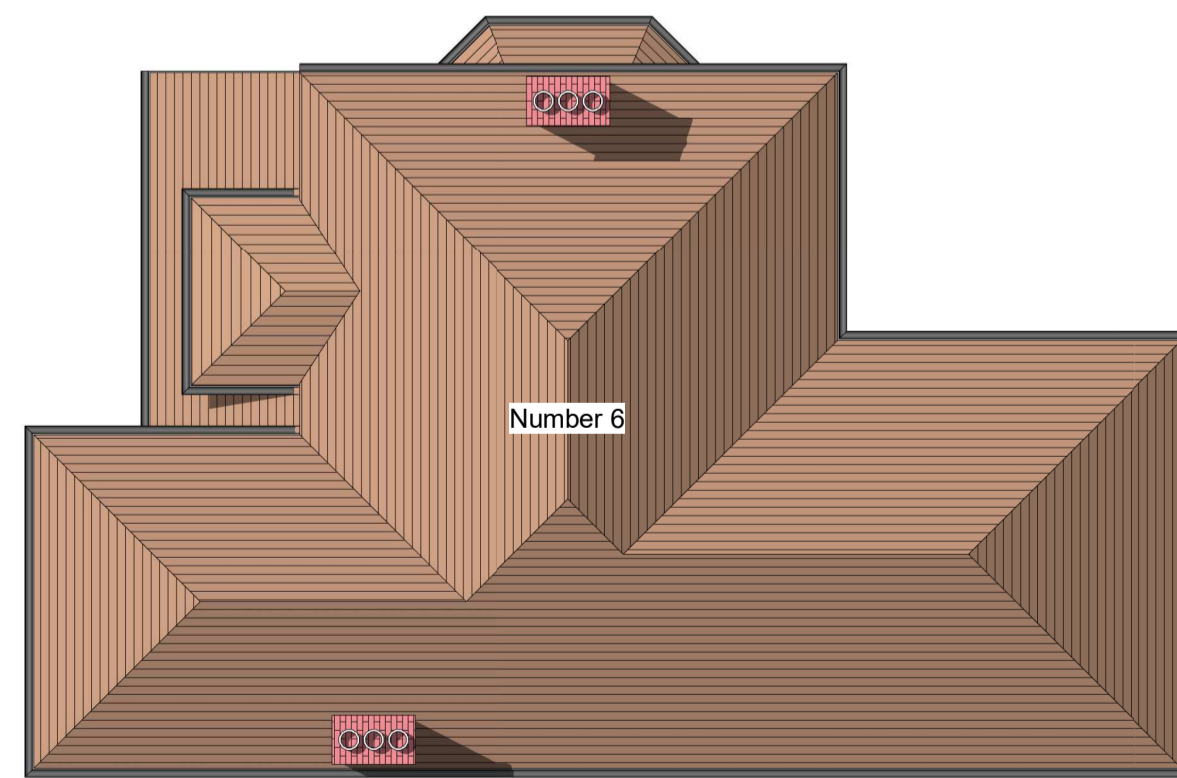
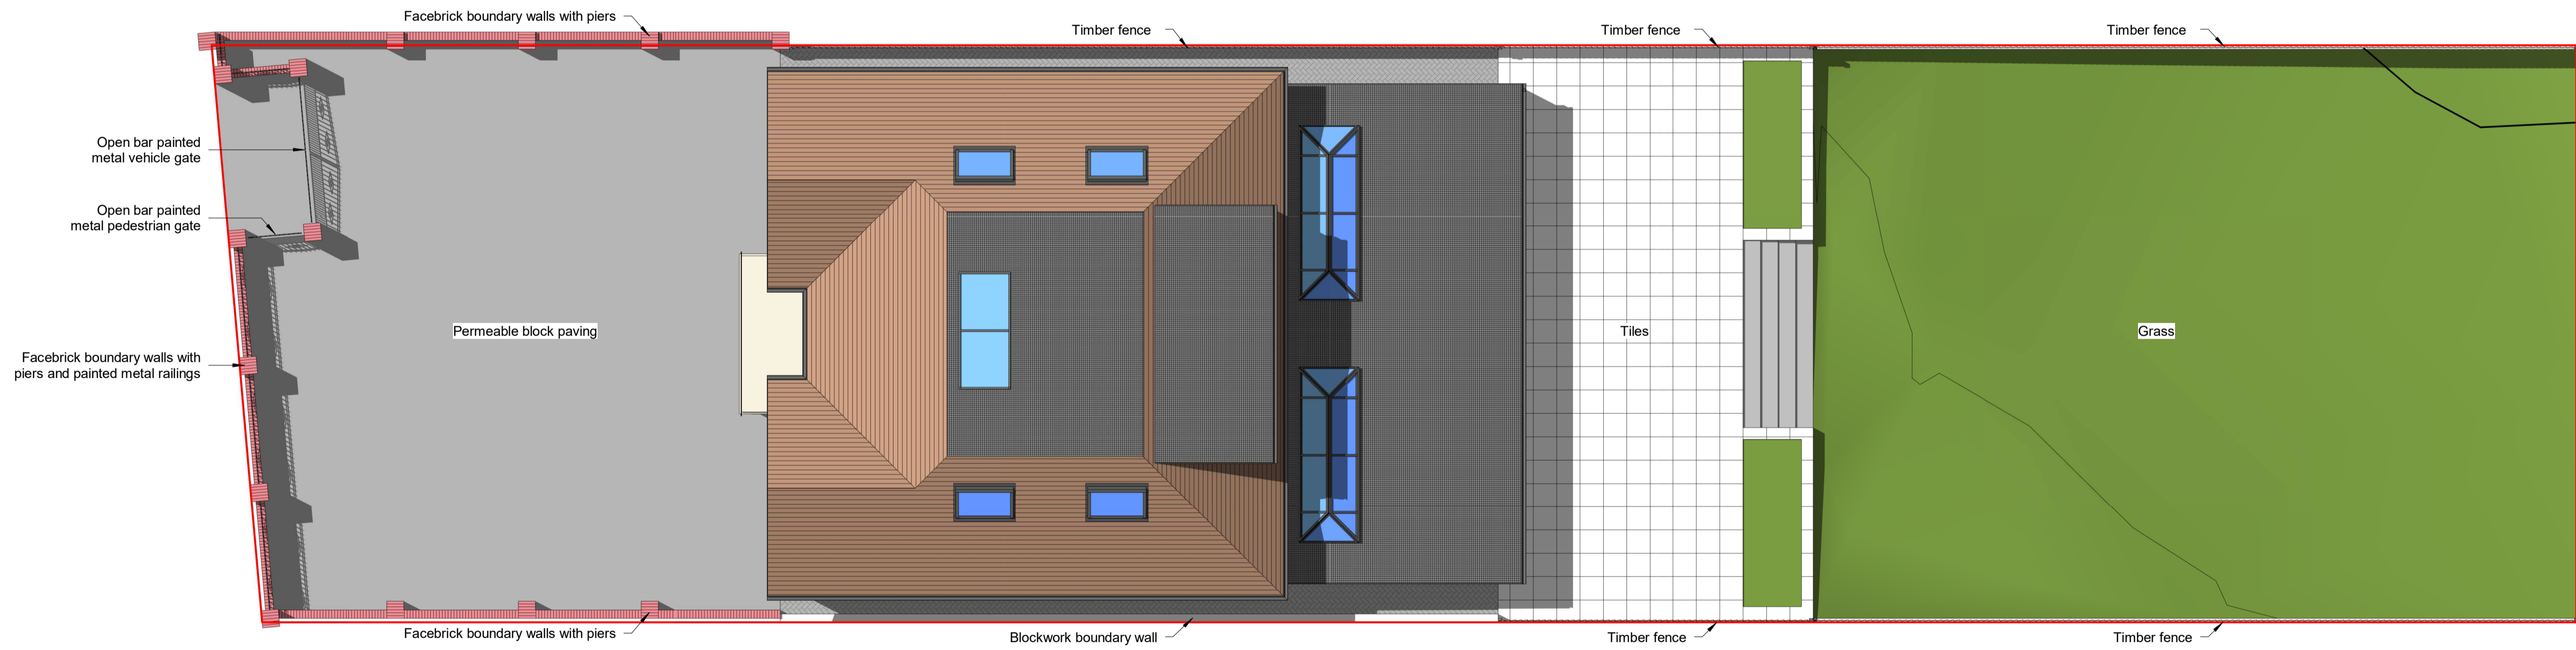
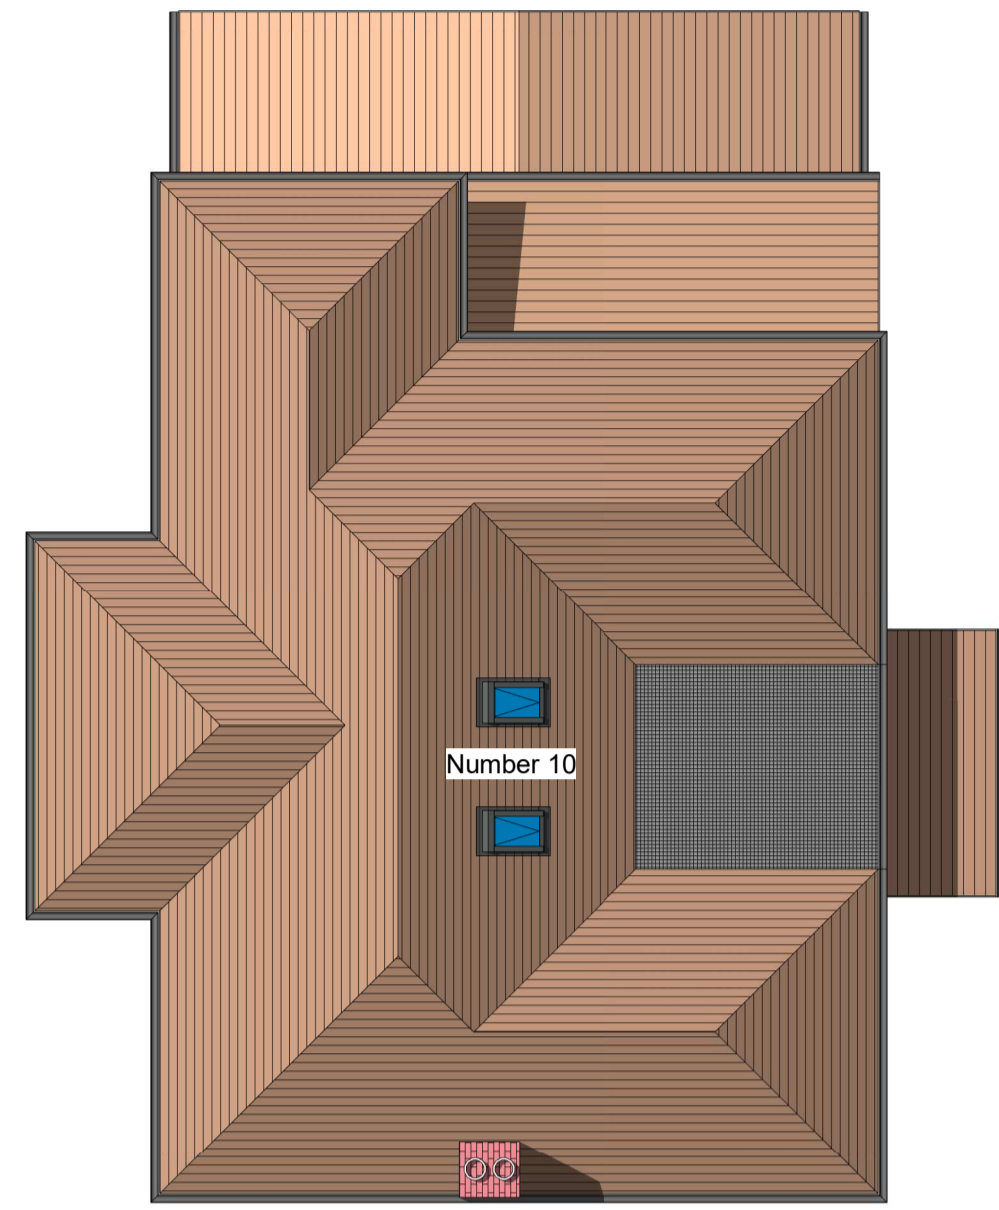


Revision Schedule		
Revision	Date	Description

1 Site Plan
1 : 100

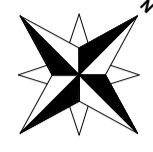

Project Address	8 Hill Rise, Potters Bar, EN6 4EE
Sheet Title	As Built Site Plan
Sheet Number	A106
Paper Size	A1
Revision	
Issue Date	01/01/2021