


Contractor to check all dimensions, drain runs and general conditions on site before commencing work. Any discrepancies to be notified to ADL before continuing work. All works to be carried out in accordance with Building Regulations, British Standards, Code of Practice, CDM Regulations and Local Authority requirements. The building owner must obtain formal agreement under the Party Wall Act 1996.


| Revision Schedule | | |
|-------------------|------------|-----------------------|
| Revision | Date | Description |
| A | 10/03/2021 | Ridge height adjusted |

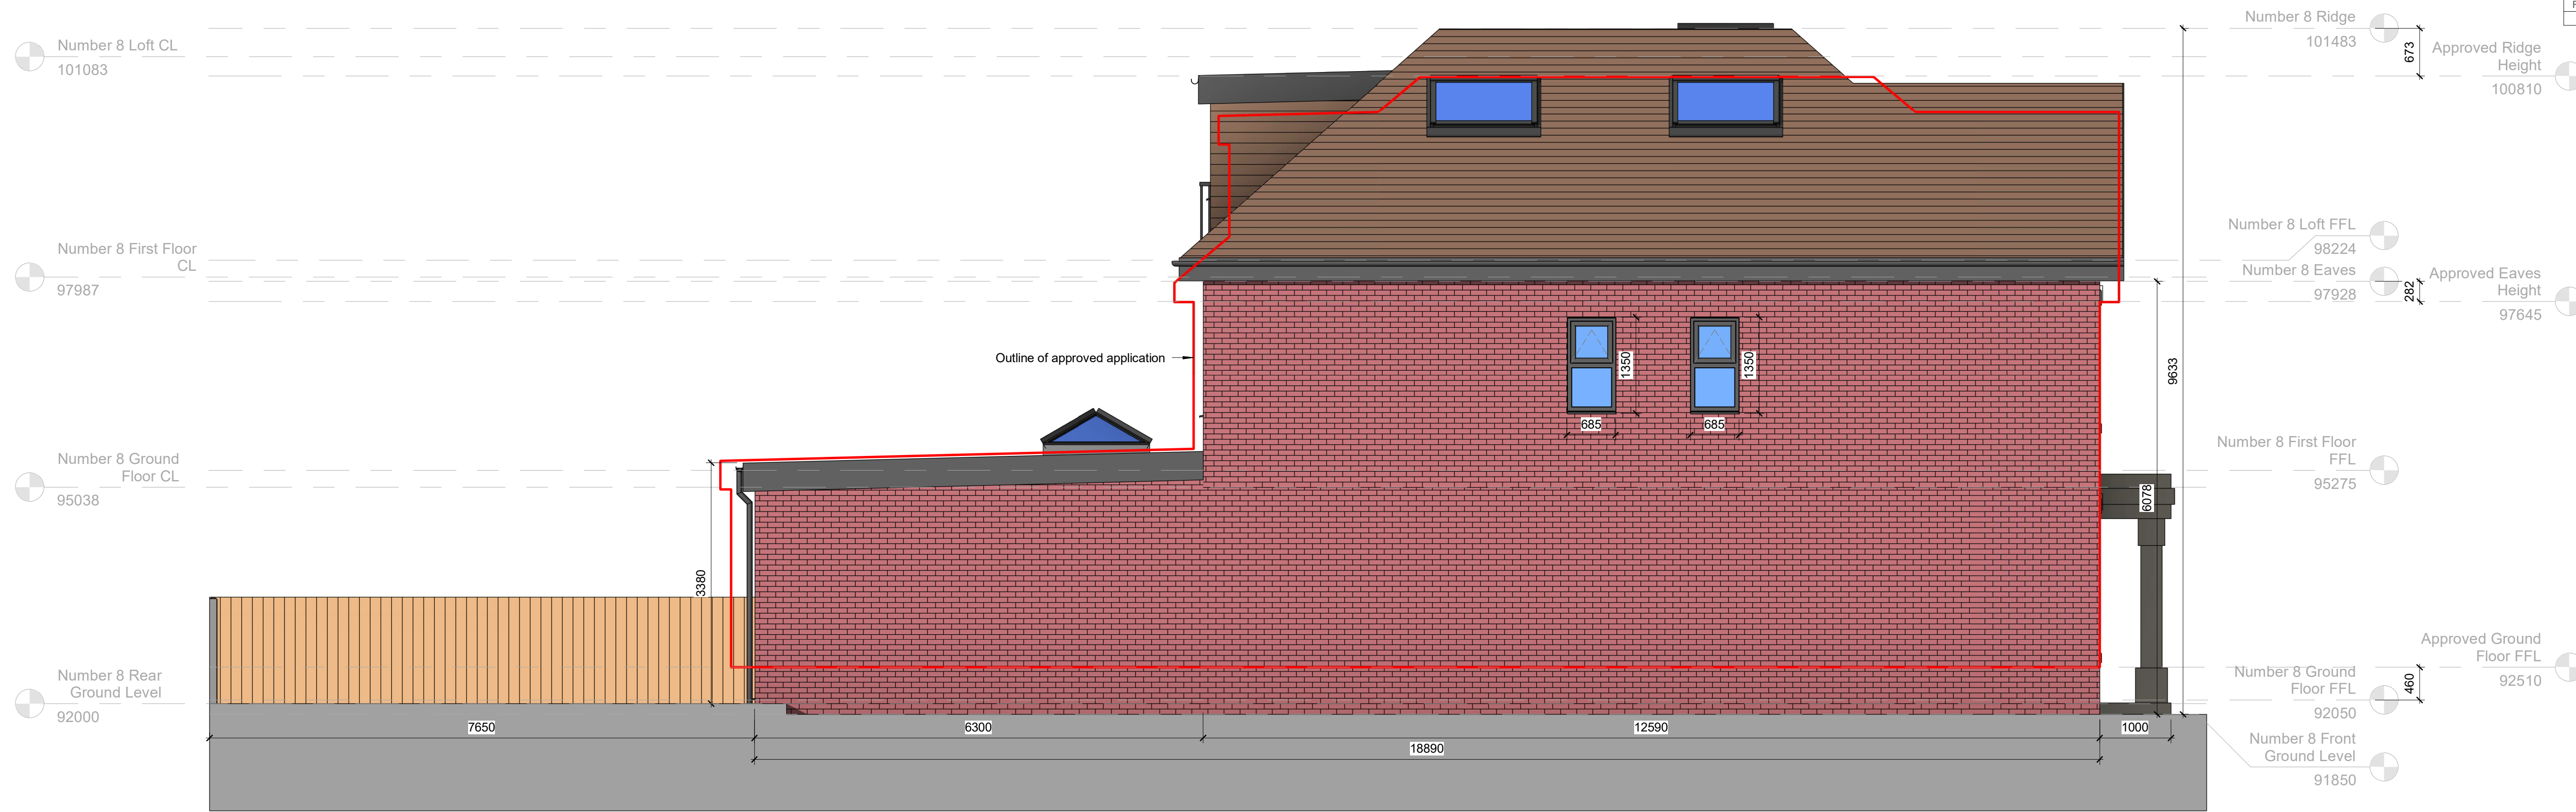


2 Left Side Elevation
1 : 50



1 Front Elevation
1 : 50

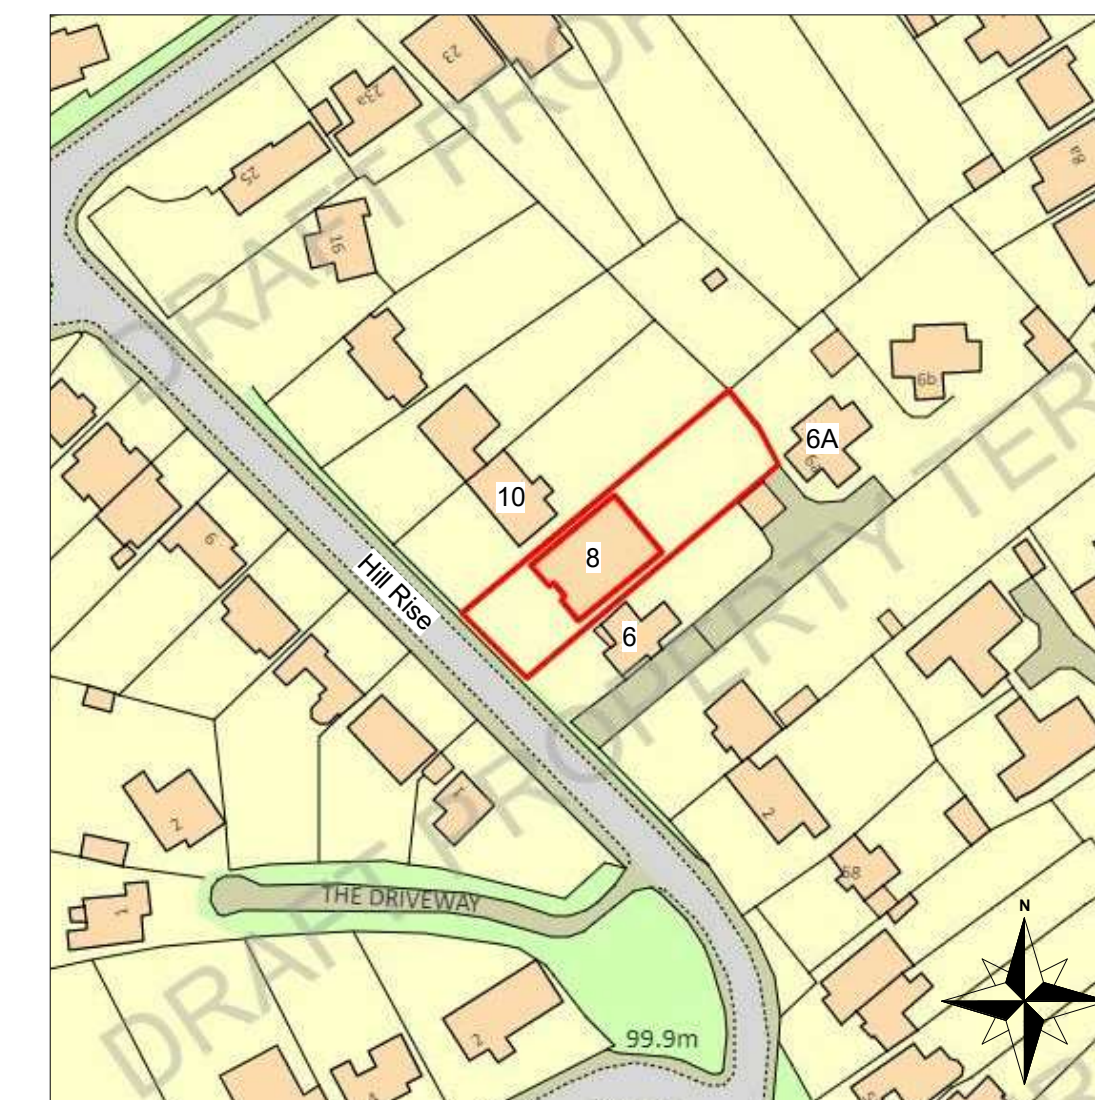

3 Location Plan
1 : 1250

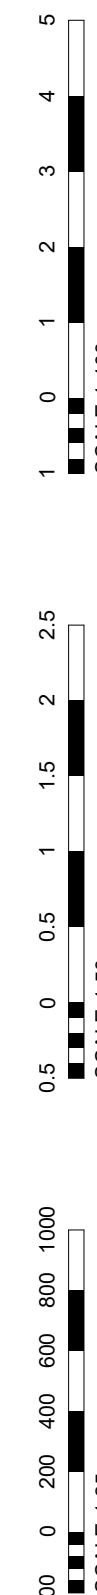

E: info@myadl.co.uk www.myadl.co.uk T: 07939 666 006

Architectural Design London
Chartered Building Engineer



| | |
|-----------------|---|
| Project Address | 8 Hill Rise, Potters Bar, EN6 4EE |
| Sheet Title | As Built Front and Left Side Elevations |
| Sheet Number | A103-A |
| Paper Size | A1 |
| Revision | A |
| Issue Date | 01/01/2021 |