


Contractor to check all dimensions, drain runs and general conditions on site before commencing work. Any discrepancies to be notified to ADL before continuing work. All works to be carried out in accordance with Building Regulations, British Standards, Code of Practice, CDM Regulations and Local Authority requirements. The building owner must obtain formal agreement under the Party Wall Act 1996.


Revision Schedule		
Revision	Date	Description
A	10/03/2021	Ridge height adjusted

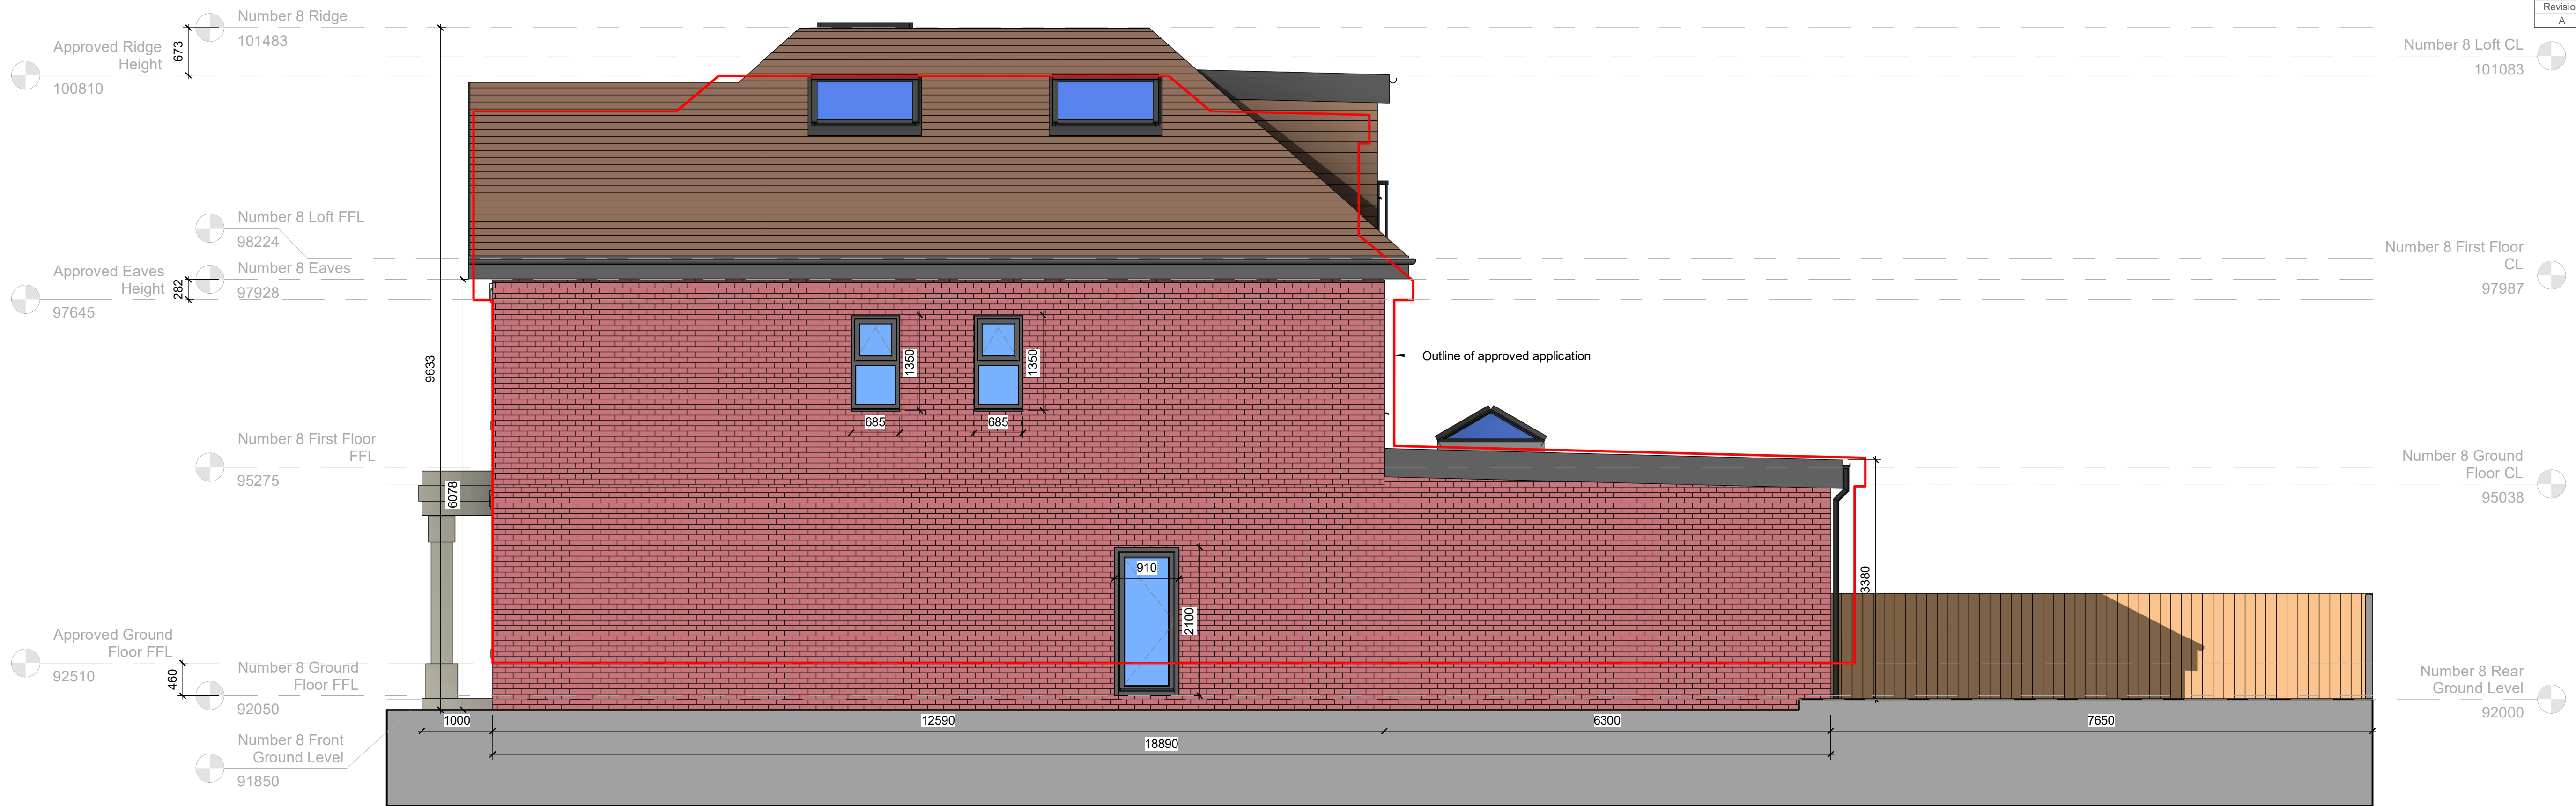


1 Right Side Elevation
1 : 50



2 Rear Elevation
1 : 50

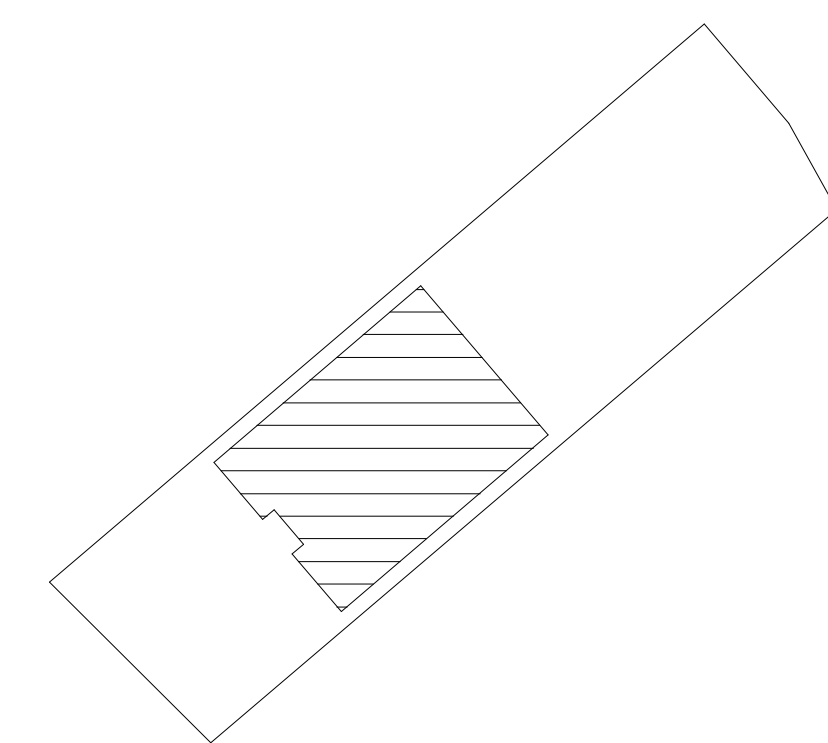

3 Block Plan
1 : 500

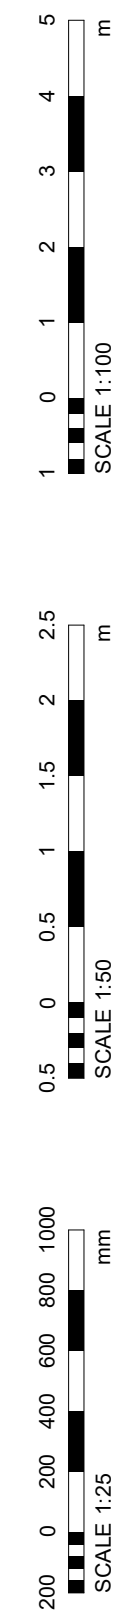

E: info@myadl.co.uk www.myadl.co.uk T: 07939 666 006

Architectural Design London
Chartered Building Engineer



Project Address	8 Hill Rise, Potters Bar, EN6 4EE
Sheet Title	As Built Rear and Right Side Elevations
Sheet Number	A104-A
Paper Size	A1
Revision	A
Issue Date	01/01/2021