



Block plan:
1:500

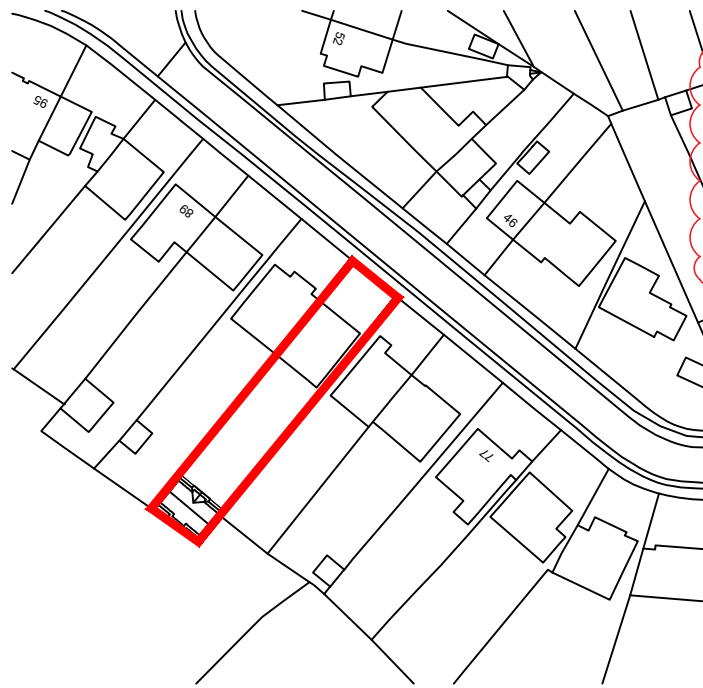

Ordnance Survey, (c) Crown Copyright 2020. All rights reserved. Licence number 100022432

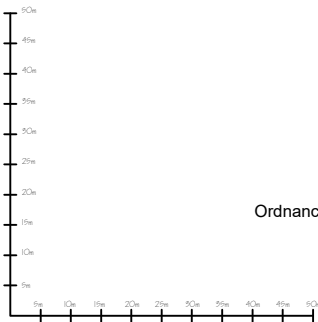

Location plan:
1:1250

Rev	Amendment	Date
A	Planning amendments.	05 / 06 / 20
title Single storey garden outbuilding		
drawing AS BUILT Location Plan.		
job 65 Bramble road		client Mr & Mrs Lane
date May 2020	scale 1:100@A3	dra.no PD 04.05.20
		rev. A
drawn by  asq developments - herts 14 Old rectory drive, Hatfield, Herts, AL10 8AF T: 01707 261927 M: 07894 761012		