




As built Front Elevation




As built Side Elevation

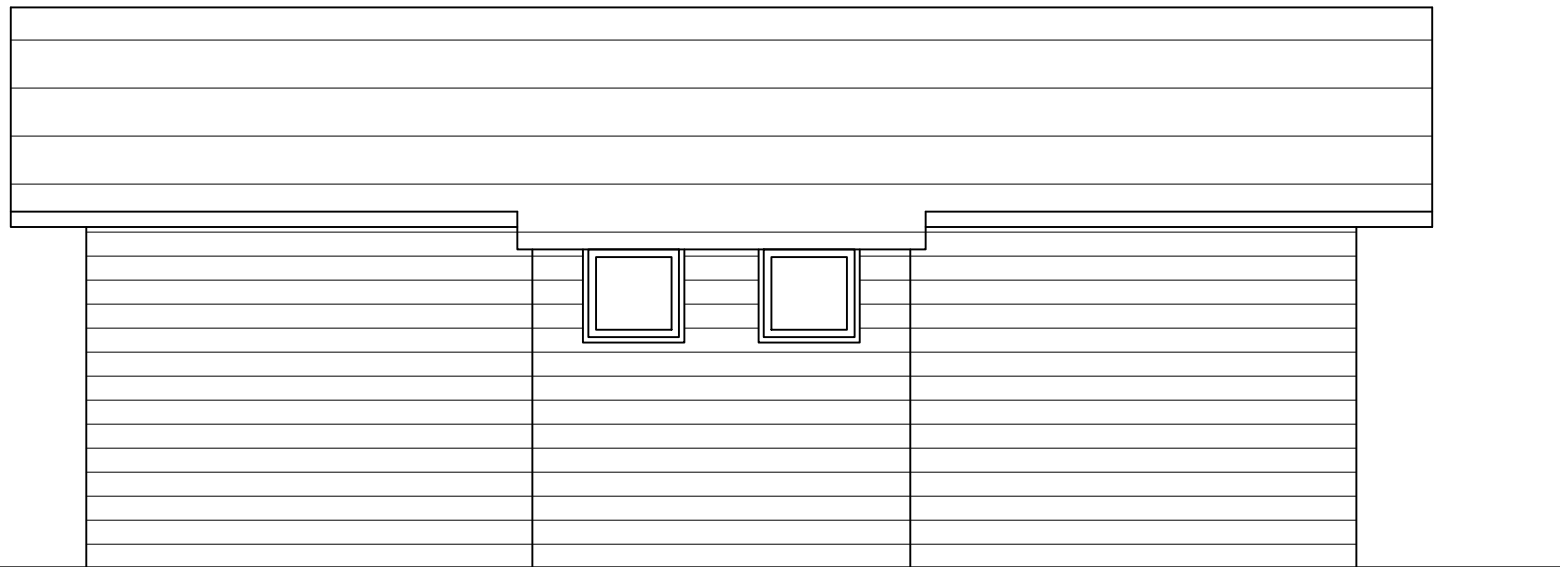

As built Rear Elevation



As built Side Elevation

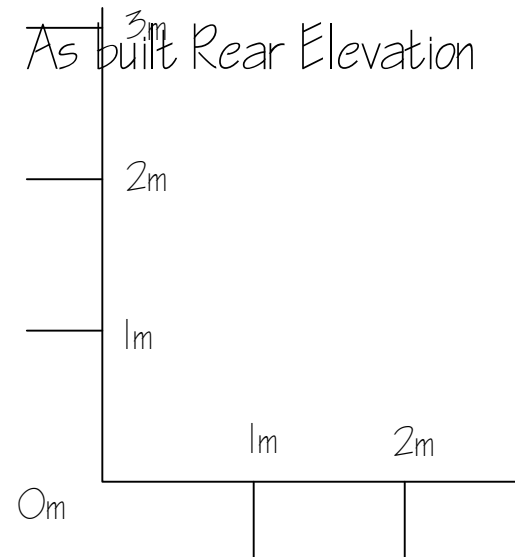

Rev.	Amendment	Date
title Single storey garden outbuilding		
drawing AS BUILT Elevations		
job 85 Bramble road		client Mr & Mrs Lane
date May 2020	scale 1:100@A3	drawn by PP 03.05.20
drawn by  asq developments - herts 14 Old rectory drive, Hatfield, Herts, AL10 8AF T: 01707 261927 M: 07894 761012		