



As built Plans

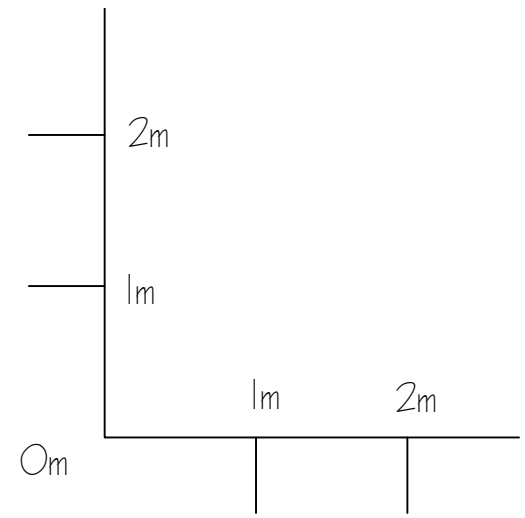

Rev.	Amendment	Date
title Single storey garden outbuilding		
drafter AS BUILT Floor Plan		
job 85 Bramble road		client Mr & Mrs Lane
date May 2020	scale 1:100@A3	drafter PP 01.05.20
drawn by  asg developments - herts 14 Old rectory drive, Hatfield, Herts, AL10 8AF T: 01707 261927 M: 07894 761012		