
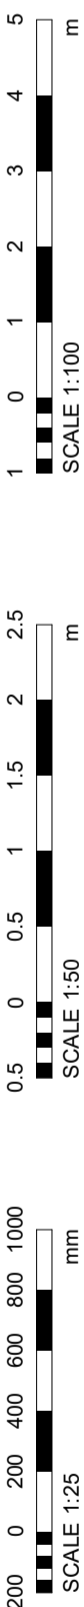
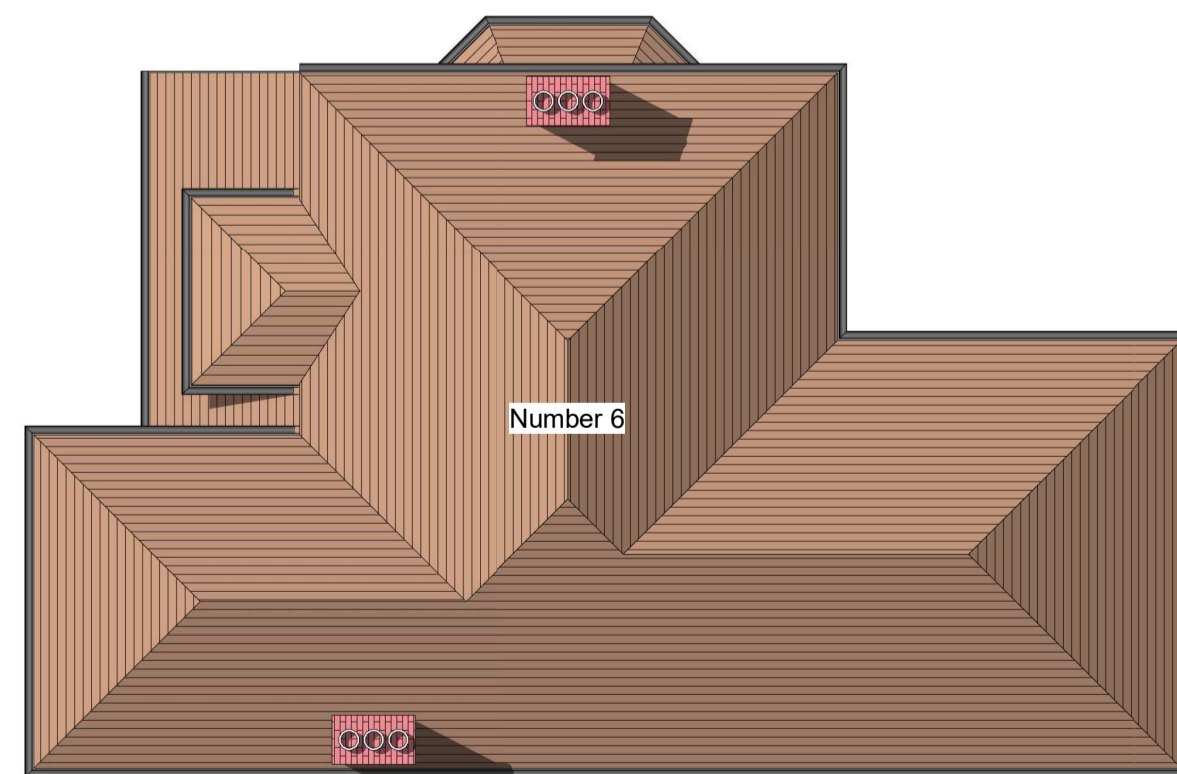
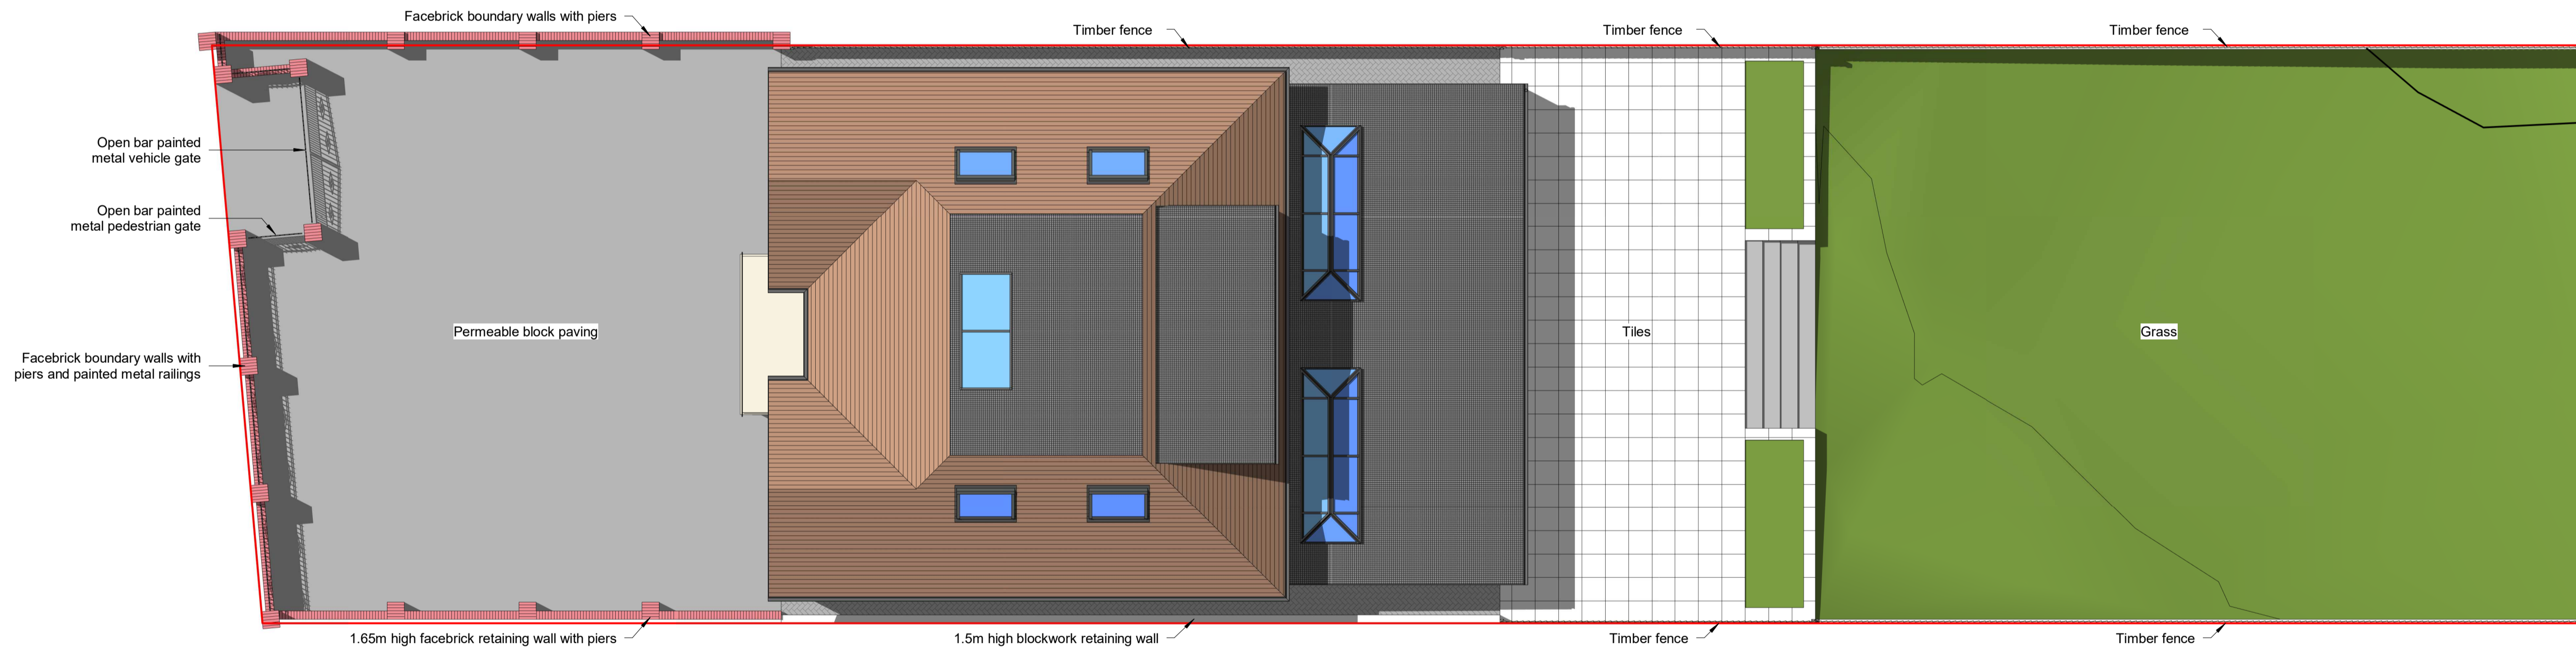
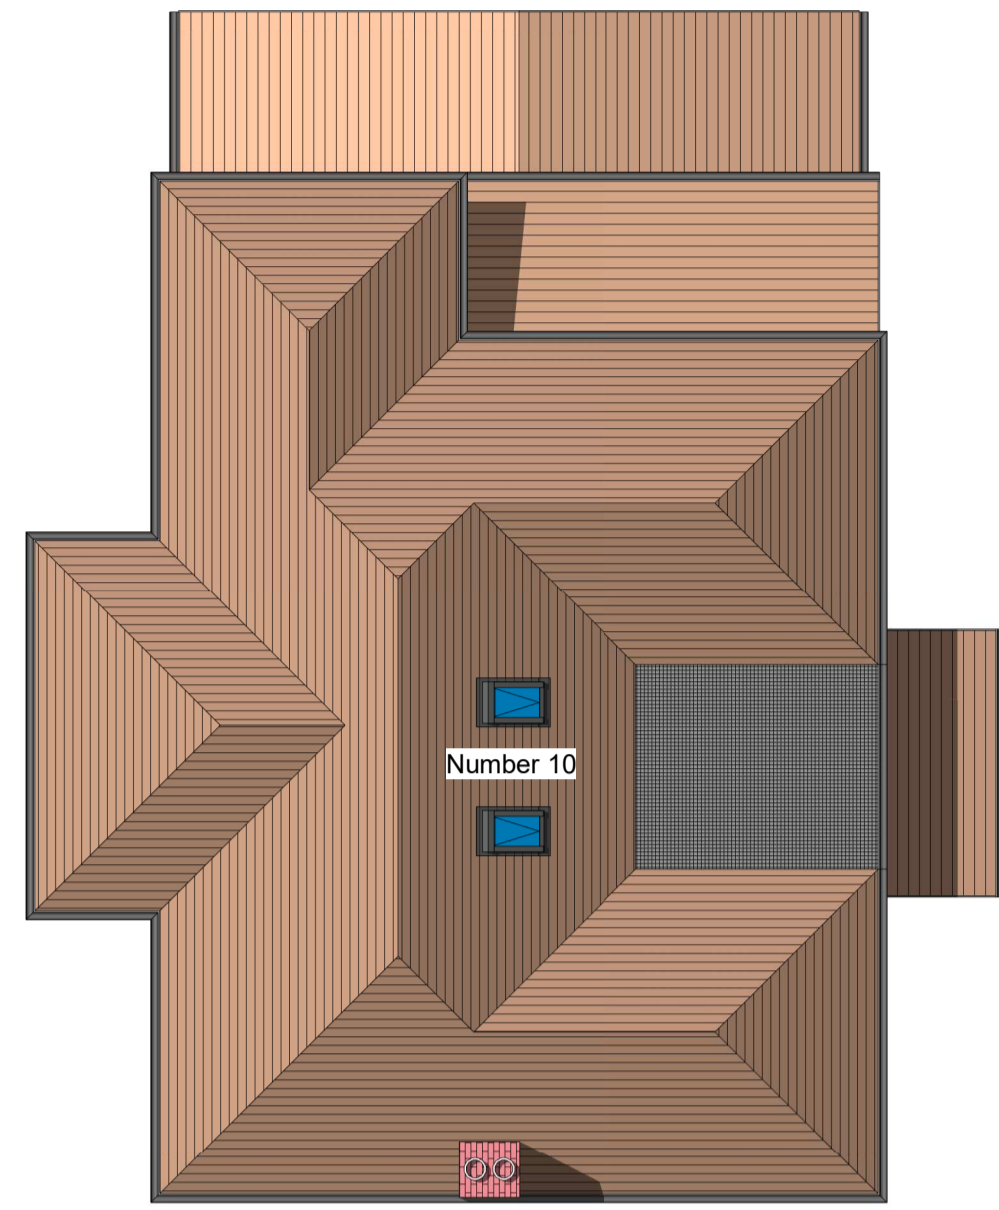


Revision Schedule		
Revision	Date	Description
A	10/03/2021	Ridge height adjusted
B	09/02/2022	Retaining wall adjacent to 6 Hill Rise added

1 Site Plan
1 : 100

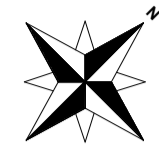

Project Address	8 Hill Rise, Potters Bar, EN6 4EE
Sheet Title	As Built Site Plan
Sheet Number	A106-B
Paper Size	A1
Revision	B
Issue Date	01/01/2021