



PLEASE NOTE: SCALE 1:150

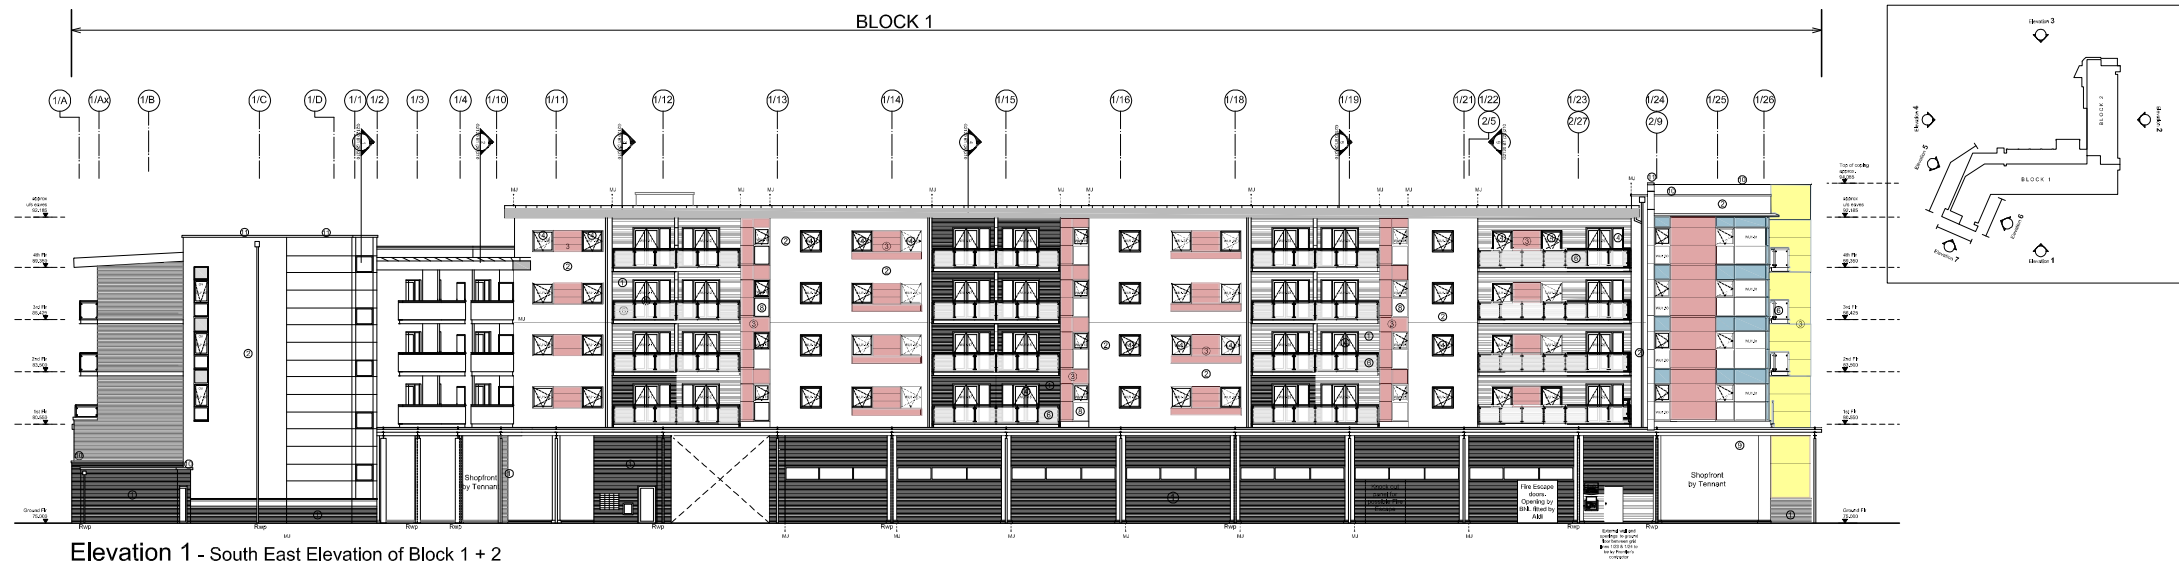

Elevation 1 - South East Elevation of Block 1 + 2

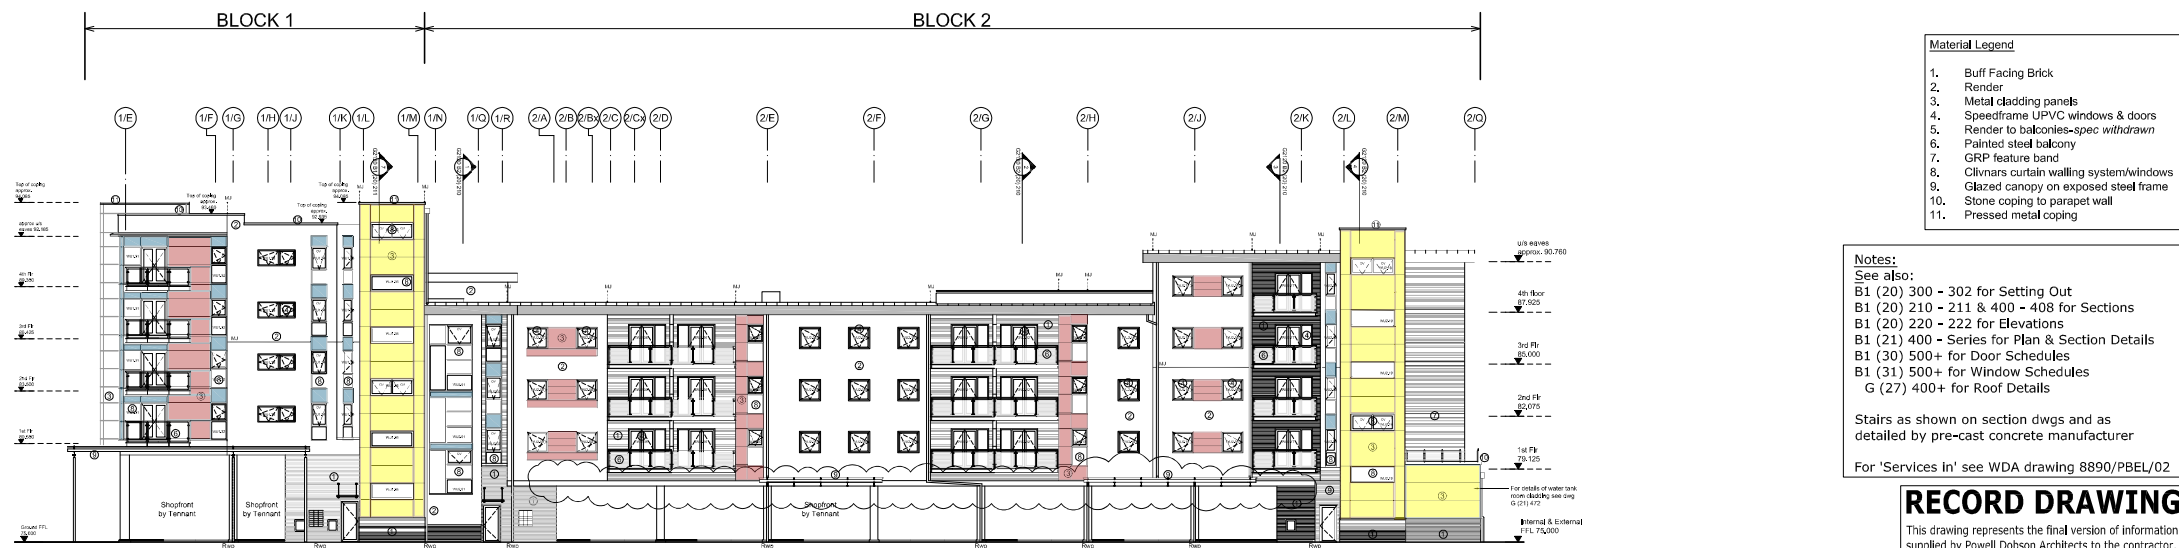

Elevation 2: North East Elevation of Block 1 + 2

- Material Legend**
1. Buff Facing Brick
  2. Render
  3. Metal cladding panels
  4. Speedframe UPVC windows & doors
  5. Render to balconies-spec withdrawn
  6. Painted steel balcony
  7. GRP feature band
  8. Clivnars curtain walling system/windows
  9. Glazed canopy on exposed steel frame
  10. Stone coping to parapet wall
  11. Pressed metal coping

**Notes:**  
See also:  
B1 (20) 300 - 302 for Setting Out  
B1 (20) 210 - 211 & 400 - 408 for Sections  
B1 (20) 220 - 222 for Elevations  
B1 (21) 400 - Series for Plan & Section Details  
B1 (30) 500+ for Door Schedules  
B1 (31) 500+ for Window Schedules  
G (27) 400+ for Roof Details

Stairs as shown on section dwgs and as detailed by pre-cast concrete manufacturer

For 'Services in' see WDA drawing 8890/PBEL/02

**RECORD DRAWING**

This drawing represents the final version of information supplied by Powell Dobson Architects to the contractor, plus any site changes advised by the contractor.

**BLOCK 1 & 2**

This drawing must not be scaled. Figured dimensions and levels to be used. Any inaccuracies must be notified to the architect. Detail drawings and large scale drawings take precedence over smaller drawings.

THIS DRAWINGS IS COPYRIGHT

Revisions:		
A	08.01.06 af	Balcony design changed to pre-fabricated metal units, render panels behind balconies changed to brickwork. Adjacent panels changed as appropriate (see minutes of meeting on 15.12.05). Generally updated.
B	27.01.06 af	Rainwater pipe locations revised.
C	16.02.06 cht	Privacy wall revised to show metal cladding. + Issued to planning (see letter of 16th Feb 2006).
D	28.02.06 cht	Movement joints and window numbers added.
E	24.07.06 cht	Cladding joints & cladding joints between windows revised. Fin wall and window width amended. Top of coping level added. Canopies added to core 1C & 2 entrances. Canopy omitted to Core 2B entrance. RVP added. Fixed pane to Window type WU1.33 replaced to show lift & turn. Louvre position & sizes revised to suit brick coursing and cladding panel setting out. Detail reference notes added.
F	26.02.07 AF	Cladding joints revised to suit construction detailing as instructed by BNL.
G	11.06.07 CKC	Record Drawing Issue.
H	06.08.06 AF	Unit 4 shop front amended.
J	19.11.07 AF	Extents of shopfront canopies revised to suit proposed shopfront layouts provided by tenants

PRELIMINARY	
DESIGN	
TENDER	
CONSTRUCTION	Approved

**powelldobson**  
ARCHITECTS

Cardiff Office: Charterhouse, Links Business Park, St Mellons, Cardiff, CF3 0LT.  
Tel: +44 (0) 29 2079 9699 Fax: +44 (0) 29 2079 1212, email: cardiff@powelldobson.com

Contract: Barratt North London  
Comet Square Phase II, Hatfield

Title: Block 1 & 2 Elevations

Drawing No. Rev.  
G2120 B1 (20) 220 J

Scale: 1:150 @ A1  
Date: August '05  
Drawn: ge  
Checked:

ACAD Ref: