


WELWYN HATFIELD
 PLANNING
 OFFICE COPY
 - 3 JAN 2007
 No: 56/2007/0006/FP

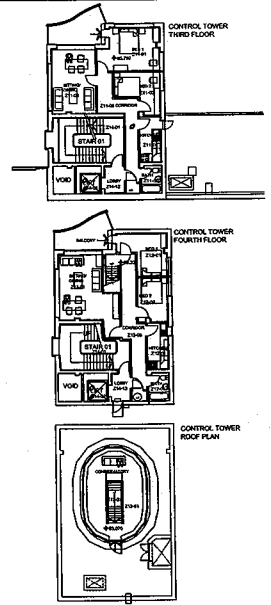

Rev	Details	Date
Q	AS BUILT	11.11.04
P	CAT AND SHIPS LADDER ADDED, TERRACE SHOWINGS DRAWING UPDATED	04.11.04
N	TWO SUITES LAYOUTS REORGANISED AS APPROVED (WHS) COURSE OMITTED TO TRAINING RGS 3 & 5.	19.04.04
M	CORRIDOR DOOR MOVED, TRAINING ROOM 2 SPLIT CORRIDOR DOORS REORGANISED ROOM NUMBERS AMENDED/OMITTED	03.03.04
L	TWO SUITES SHOWN IN SERVICE	19.02.04
K	TRAINING ROOMS AMENDED SMALL STITCHES REMOVED	16.02.04
J	REAR HALL TO STAIRS AMENDED LOBBY TO MEETING ROOM ON SECOND FLOOR AMENDED	30.02.04
H	ALL GRID LINES INDICATED, STAIRS 03 REWORKED (WHS) STEELWORK LOCATIONS AMENDED	15.10.03
G	SOUTHERN WINDOW DOORS REORGANISED SOUTHERN CORRIDOR WALL PLACING AMENDED	08.08.03
F	STAIRCASE NO. 4 ADDED LINDS INDICATED	12.12.02
E	PLAN AMENDED AT LEFT SHAFIT TO ADD EXTRA CROSS BRACING	26.11.02
D	PLAN UPDATED AND CROSS REFERENCED	16.11.02
C	ROOM No. 4 ADDED	07.11.02
B	ROOM No. 4 ADDED	28.10.02
A	LEFT SHAFIT REWORKED TO CONTROL TOWER ROOF LEVEL	03.10.02

© No. Drawing is copyright and must not be reproduced without the written consent of the architect.
 All written instructions should be checked on site. Do not scale from this drawing.
 Limbrick Limited is a member of the Building Services Association (BSA) and is registered with the Building Services Association (BSA) under the Building Services Association (BSA) Act 1999.

**NEXT GENERATIONS CLUB
 TENNIS AND RAQUET CENTRE
 HATFIELD**

**PROPOSED
 SECOND FLOOR PLAN
 & UPPER FLOORS
 AS BUILT**

Scale 1:200	Proj. No. 664	Rev. Q
Date 25.09.02	Dep. No. L(0)003	
Drawn MDS	Checked	







LIMBRICK LIMITED
 CHEDWORTH HOUSE - FALCON CLOSE - BRISTOL ROAD
 QUEDDELEY - GLOUCESTER - GL2 4LY
 TEL: 01452 880200 - FAX: 01452 880201

SECOND FLOOR PLAN

KEY TO ZONES
 (1) TRAINING ROOM
 (2) L116 ACCOMMODATION FLOOR PLANS
 (3) L116 ACCOMMODATION FOURTH FLOOR
 (4) COMMERCIAL ROOF
 (5) STAIRS & LIFT

WELWYN HATFIELD
 PLANNING
 OFFICE COPY
 - 3 JAN 2007
 No: 56/2007/0006/FP

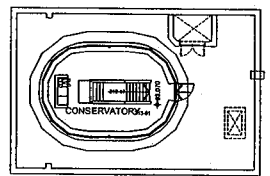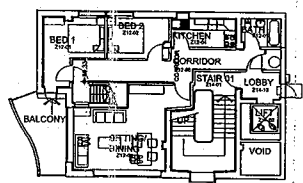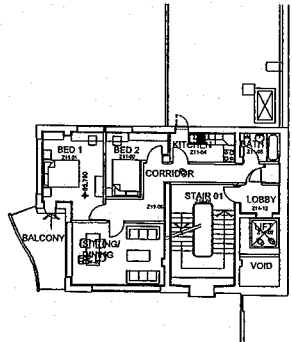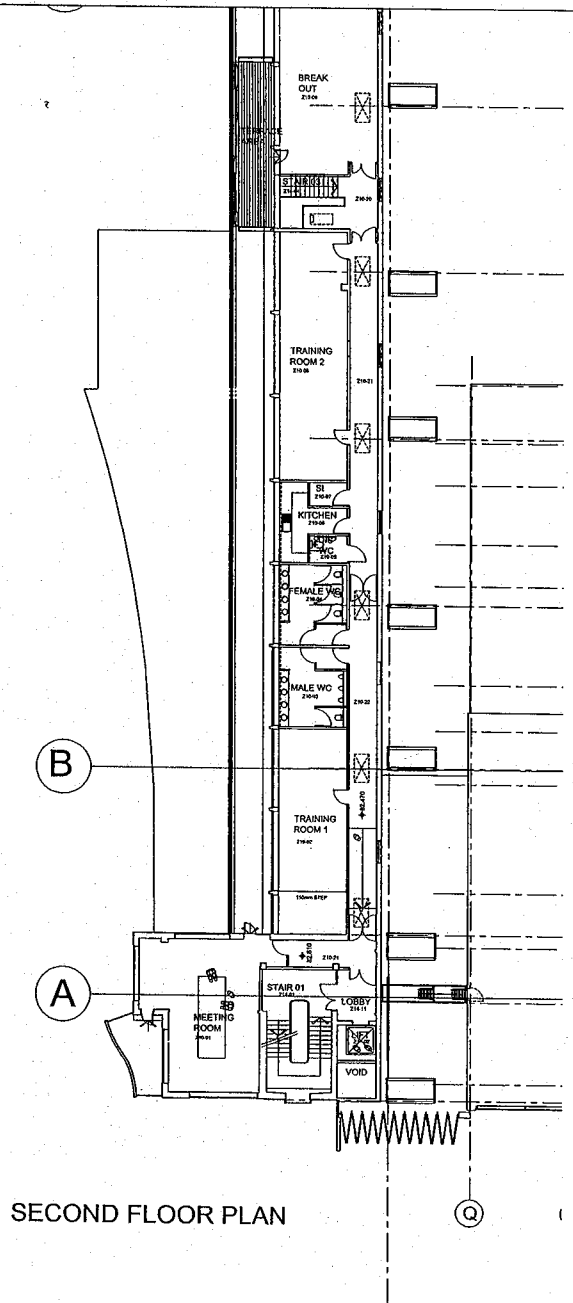

1	THIRD FLOOR	1:100	01.01.01
2	FOURTH FLOOR	1:100	01.01.02
3	ROOF PLAN	1:100	01.01.03
4	MEETING ROOM	1:100	01.01.04
5	TRAINING ROOM 1	1:100	01.01.05
6	TRAINING ROOM 2	1:100	01.01.06
7	KITCHEN	1:100	01.01.07
8	MALE WC	1:100	01.01.08
9	FEMALE WC	1:100	01.01.09
10	BED 1	1:100	01.01.10
11	BED 2	1:100	01.01.11
12	LOBBY	1:100	01.01.12
13	VOID	1:100	01.01.13
14	STAIR 01	1:100	01.01.14
15	CORRIDOR	1:100	01.01.15
16	BALCONY	1:100	01.01.16
17	CONSERVATORY	1:100	01.01.17

NEXT GENERATION CLUB
 TENNIS AND RAQUET CENTRE
 HATFIELD

SECOND FLOOR PLAN @ 1:100
 SHEET TWO OF TWO
 CONSTRUCTION

SCALE	1:100	PROJ. NO.	006	REV.	C
DATE	18.12.02	ISS. NO.	1(0)135		
BY	DRG				


LIMBRICK
 ARCHITECTS

LIMBRICK LIMITED
 CHEWORTH HOUSE - FALCON CLOSE - BRISTOL ROAD
 CHEWORTH - WILMINGTON - B15 4JY
 TEL: 01453 880200 • FAX: 01453 880201

WELWYN HATFIELD
PLANNING
OFFICE COPY

- 3 JAN 2007


No: S6/2007/0006/FP

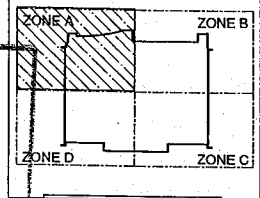

Legend

Type 1A	30 mins FR	---
Type 2A	0 mins FR	---
Type 3A	60 mins FR	---
Type 4A	60 mins FR	---
Type 4	60 mins FR	---
Type 5A	60 mins FR	---
New		---
Blockwork		---
Plinth		---

NOTE:
Refer to dwg no:
A(2) 15 Partition Type Details

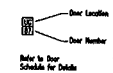

NOTES

This drawing indicatively shows different new build wall types and thicknesses of partitions. Actual partition and blockwork thicknesses to be agreed

- E AMENDED TO SUIT NEW LAYOUT 01/01 21.09.04
- D ISSUED FOR CONSTRUCTION 01/01 11.08.04
- C LAYOUT REVISION AS APPROVED BY BCO 01/01 19-04-04
- B AREA IN REVISION 01/01 02-03-04
- A ROOM NUMBERS ADDED IMPROVED LAYOUT 01/01 24-11-03

Rev	Details	Author	Checked	Date
A	Revisions			

© This drawing is copyright and may not be reproduced without the written consent of the architect. All written descriptions should be checked on site. Do not make from this drawing. Under-ink limited liability as stipulated in the Architects' Association of the United Kingdom (UK) 1 May 2003



NEXT GENERATIONS CLUB
TENNIS AND RAQUET CENTRE
HATFIELD

UPPER FLOORS
SETTING OUT PLAN
ZONE A
CONSTRUCTION

Scale	1:50	Proj. No.	664	Rev.	E
Date	24-10-03	Dwg. No.	L(0)096		
Drawn	DHAB	Checked			



LIMBRICK LIMITED
CHEDWORTH HOUSE - FALCON CLOSE - BRISTOL ROAD
QUEDDELEY - GLOUCESTER - GL2 4LY
TEL: 01452 860200 - FAX: 01452 860201

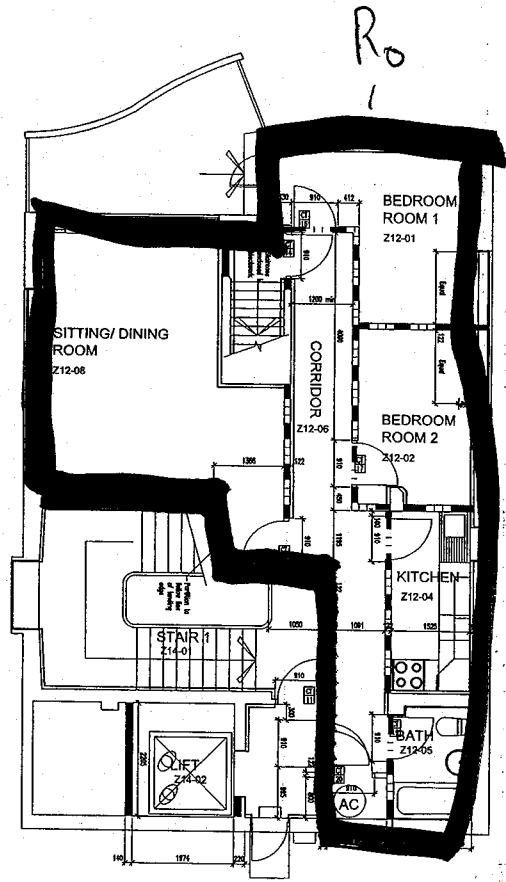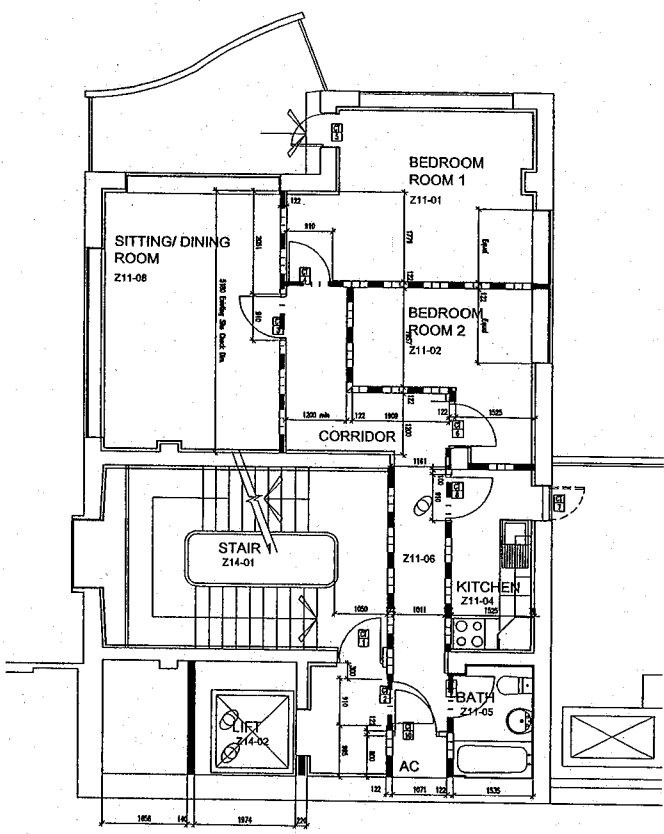

2nd Floor

