


EXISTING




west elevation

south elevation


east elevation

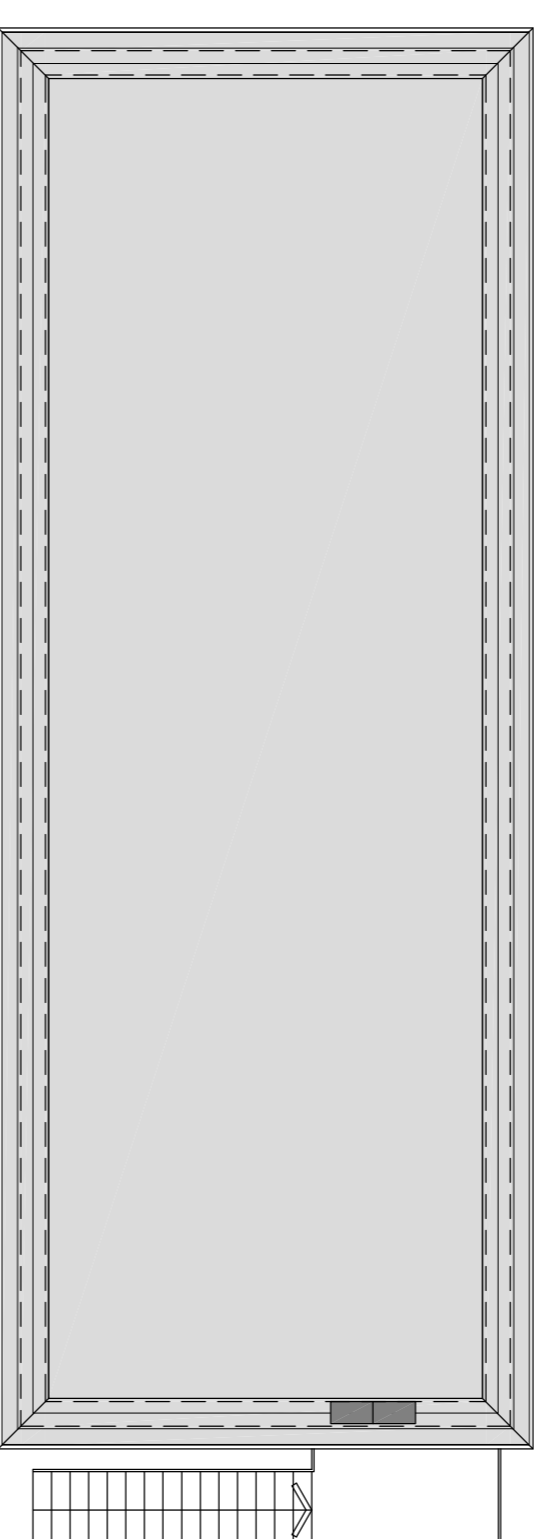


roof plan

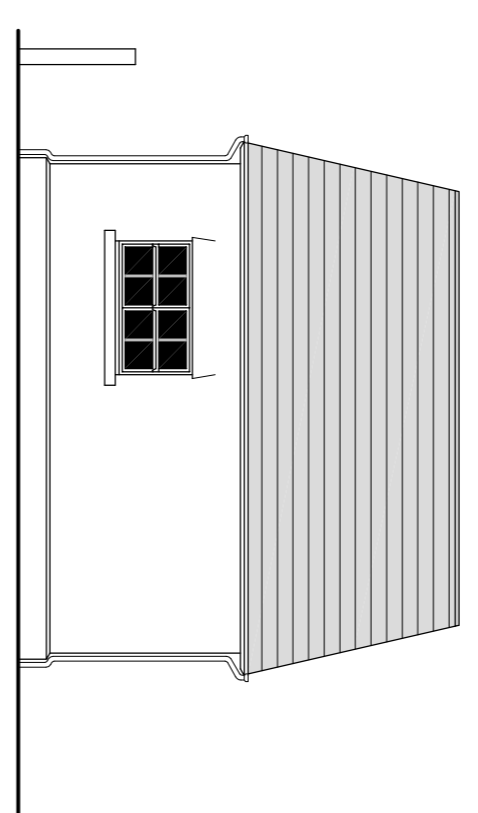

north elevation

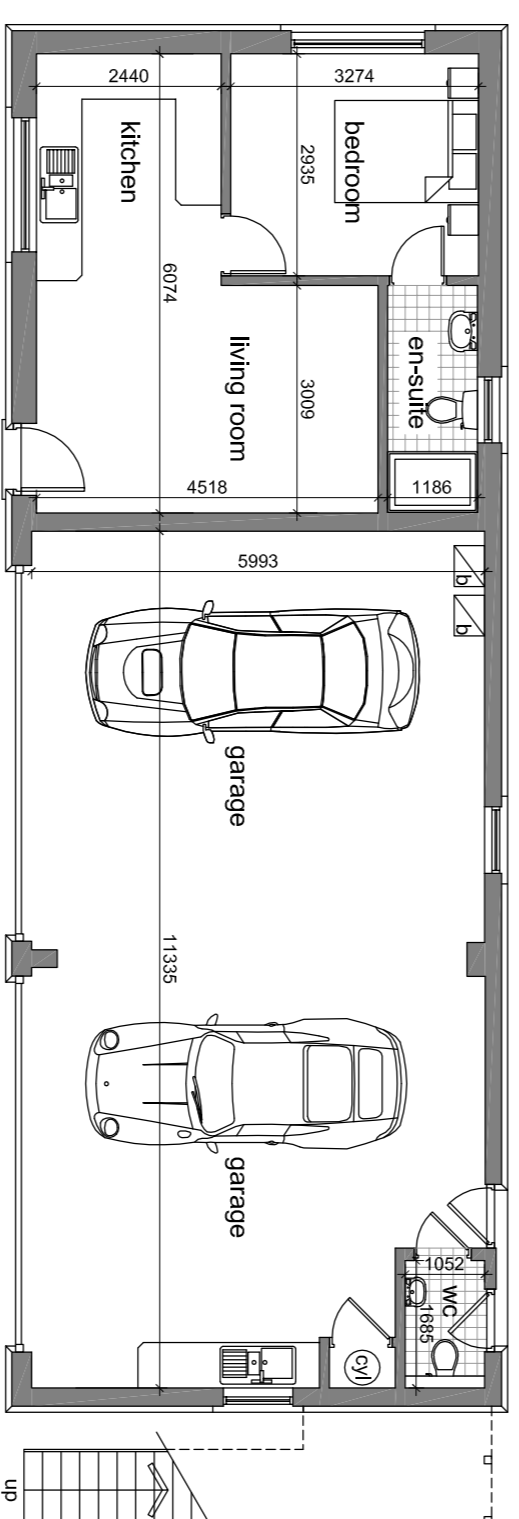


ground floor plan - as built

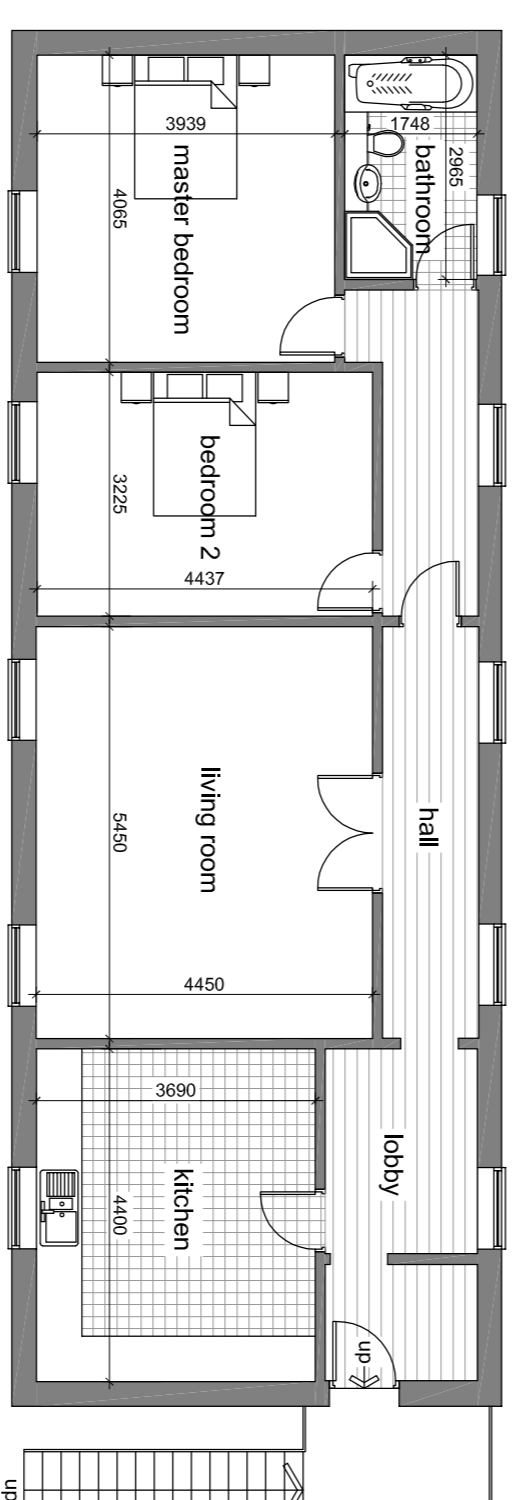


first floor plan - as built


PROPOSED

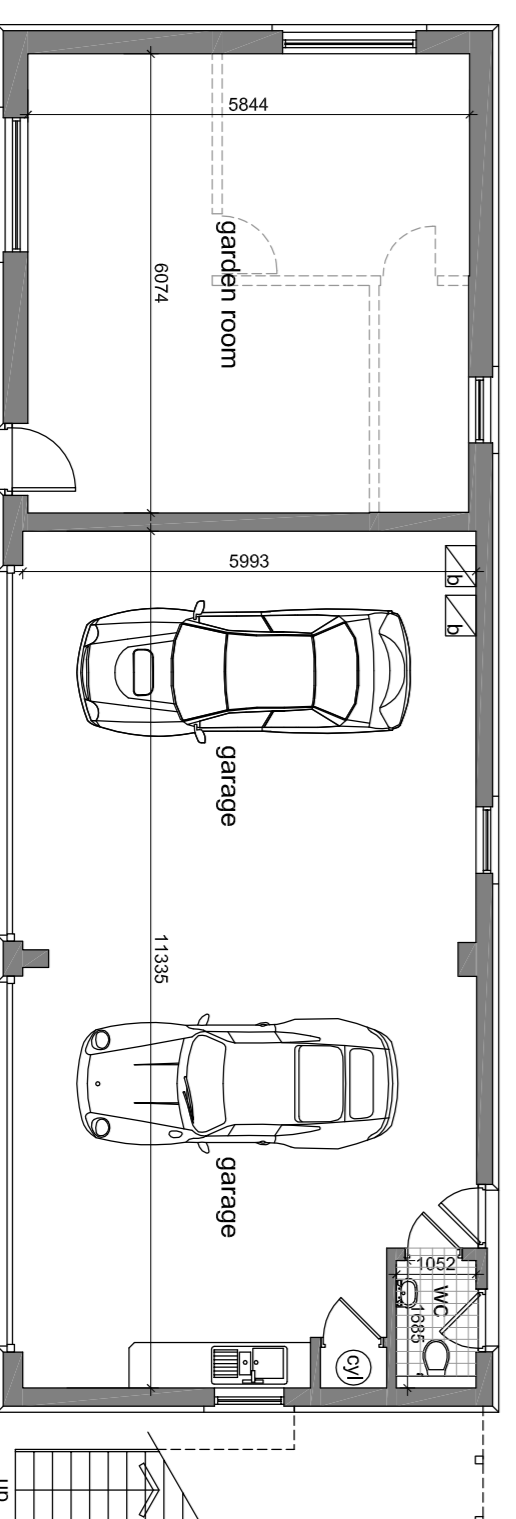

ground floor plan

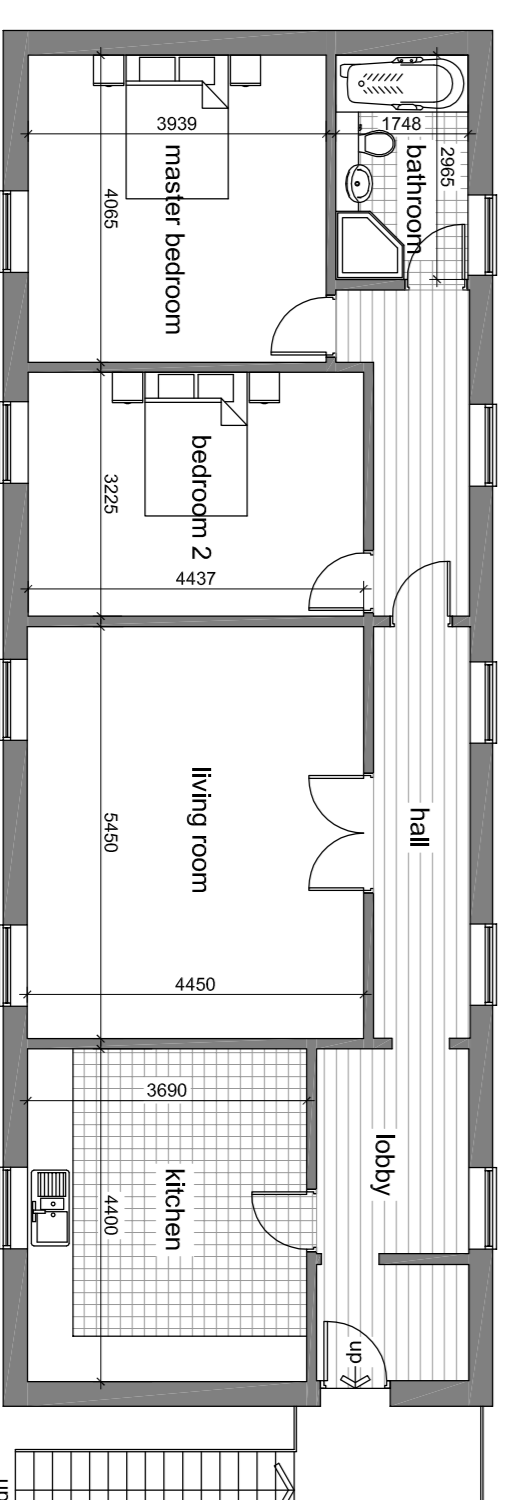

first floor plan - as existing

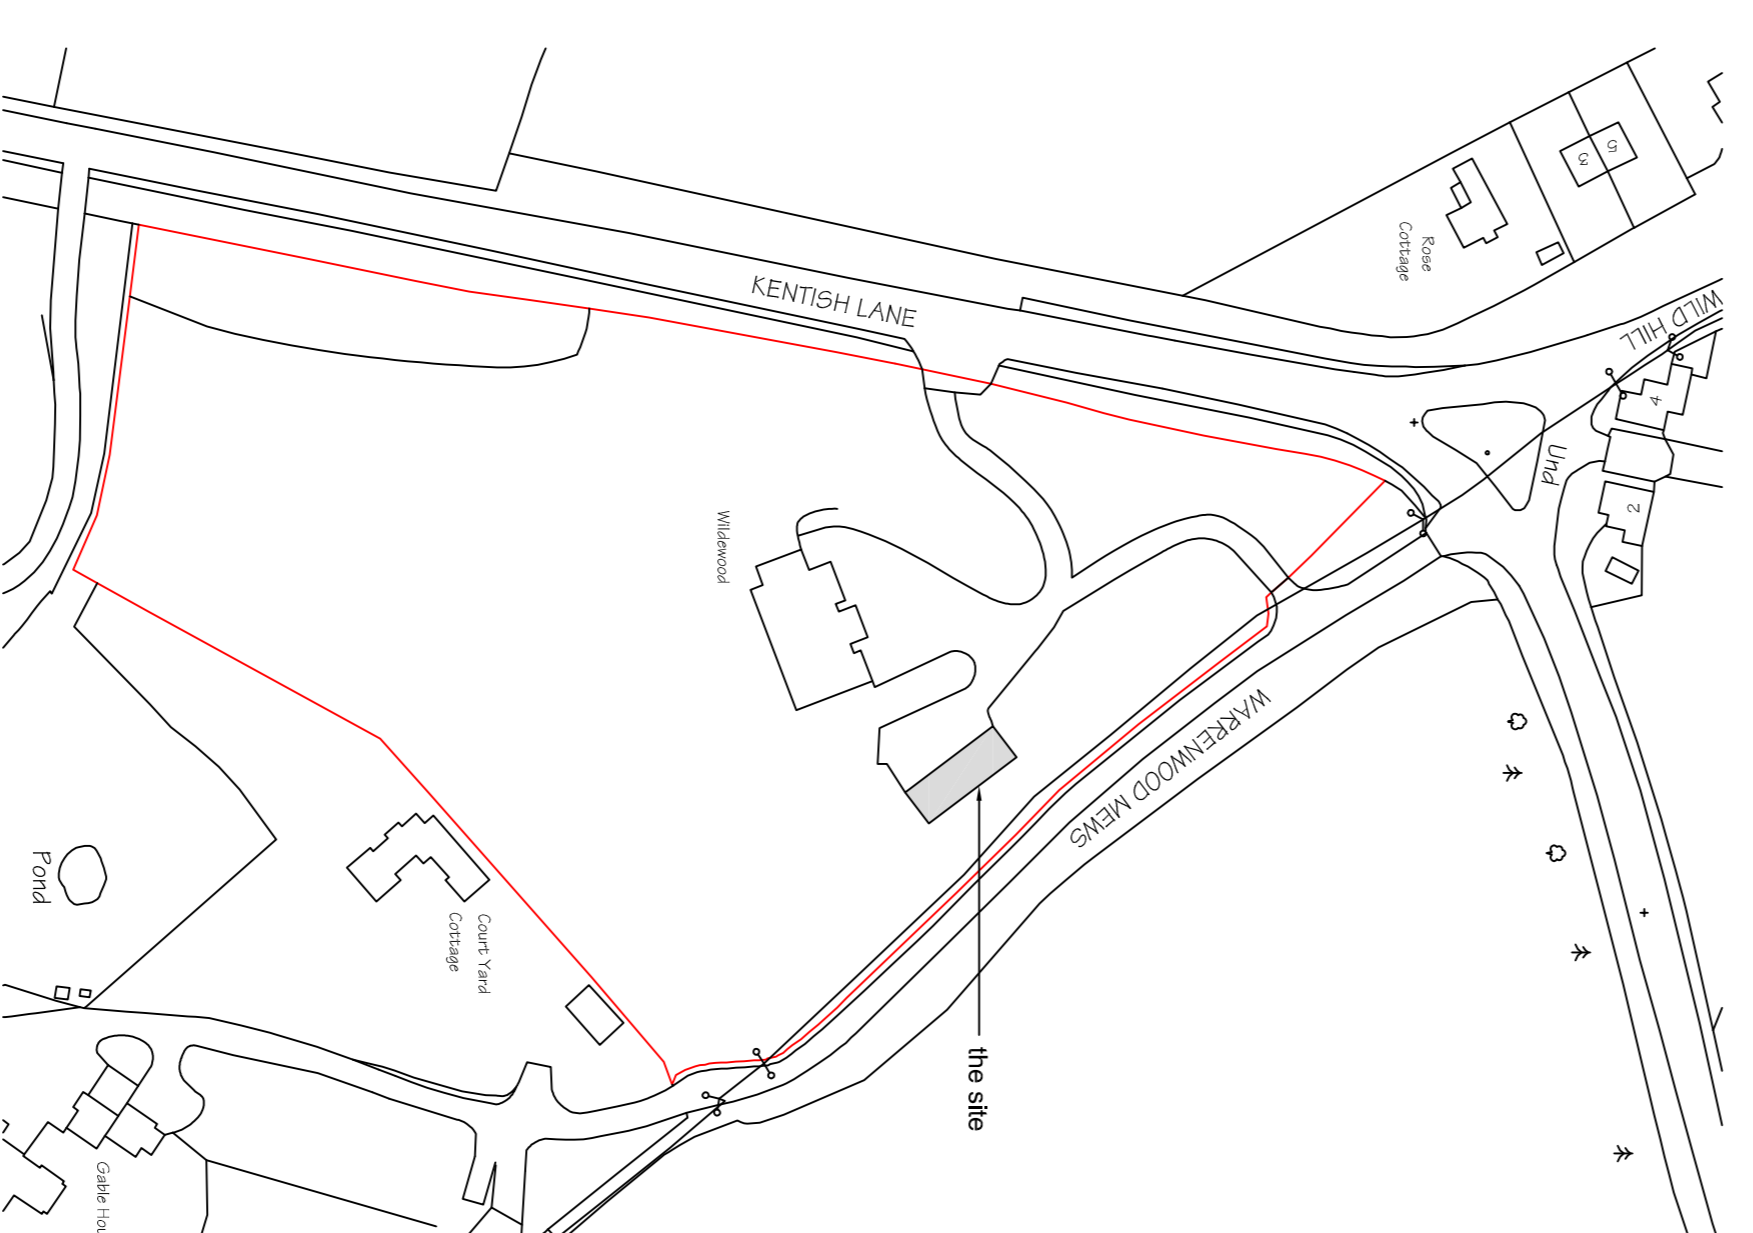

location plan 1:1250



notes:
any discrepancies should be reported immediately
all dimensions should be checked on site prior to commencement of work
site survey based on Ordnance Survey information provided by product systems plc. (www.promap.co.uk). Product does not guarantee that all past or current uses or features will be identified in this product.
The product does not give details about the actual state or condition of the site nor should it be used or taken to indicate or exclude actual suitability or unsuitability of the site for any particular purpose, or relied upon for determining suitability or value, or used as a substitute for any physical investigation or inspection.
drawings to be read in accordance with the dwelling emission rate (gerbil) calculation. The building must be built, as designed meeting the criteria set for air permeability.
© HERTFORD PLANNING SERVICE

note
when printing off pdf's, it is the responsibility of the user to verify that the resulting prints are to scale on the appropriate sized sheet.
appropriate sized sheet.
also that the scale bars on the plan measure correctly.

| | |
|--------|---|
| 1:2500 | 0 |
| 1:1250 | 0 |
| 1:500 | 0 |
| 1:200 | 0 |
| 1:100 | 0 |
| 1:50 | 0 |
| 1:25 | 0 |
| 1:10 | 0 |
| 1:5 | 0 |
| 1:2 | 0 |
| 1:1 | 0 |
| 0.5m | 0 |
| 1m | 0 |
| 2m | 0 |
| 4m | 0 |
| 8m | 0 |
| 12m | 0 |
| 15m | 0 |
| 20m | 0 |
| 25m | 0 |
| 30m | 0 |
| 40m | 0 |
| 50m | 0 |
| 100m | 0 |
| 150m | 0 |
| 200m | 0 |

Westgate House, 37-41 Castle Street,
Hertford, Herts SG1 4 1HH
Tel: 01992 552173 Fax: 01992 587643
Email: contact@herfordplanning.co.uk
www.herfordplanning.co.uk

hps
Hertford Planning Service
Architecture & Planning

Client: Mr B & Mrs C Bealer
Description: GARAGE/STAFF ACCOMMODATION
Project: Widdowood, Kentish Lane, Essendon
Drawing: PLANS & ELEVATIONS

Date: December '10
Scale: 1:100, 1:1250
Sheet size: A1
Drawn: JDB

10424/S/001