







FRONT ELEVATION

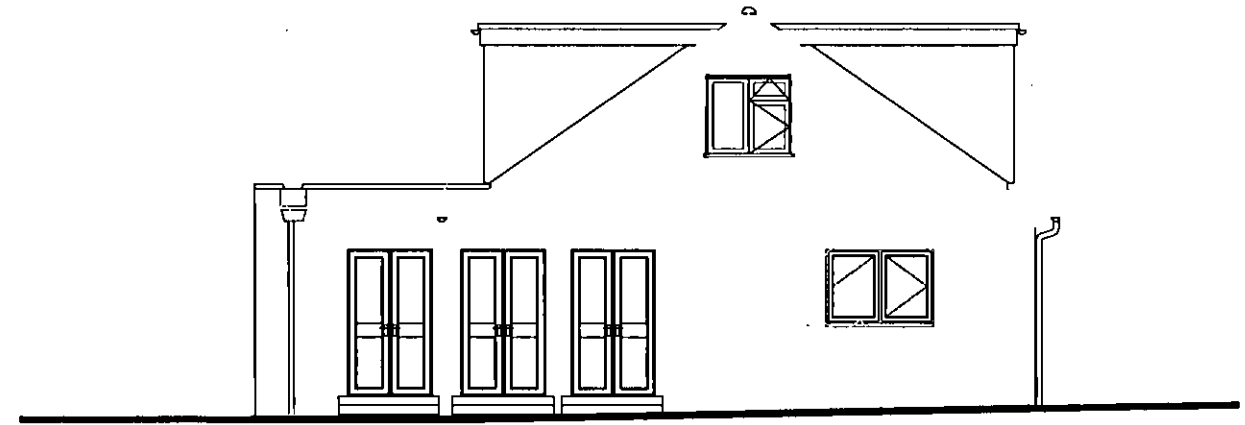

REAR ELEVATION

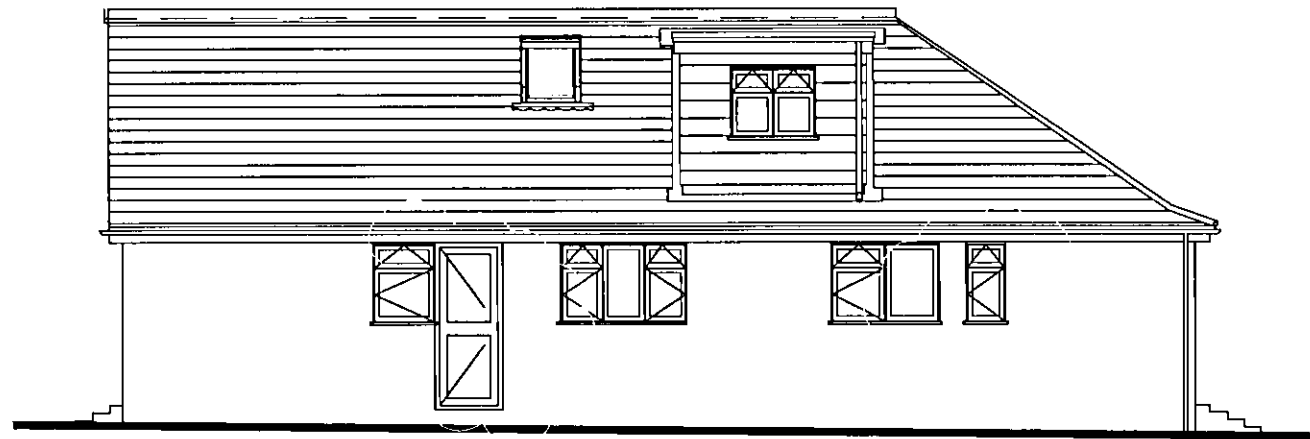

FLANK (SOUTH)
ELEVATION

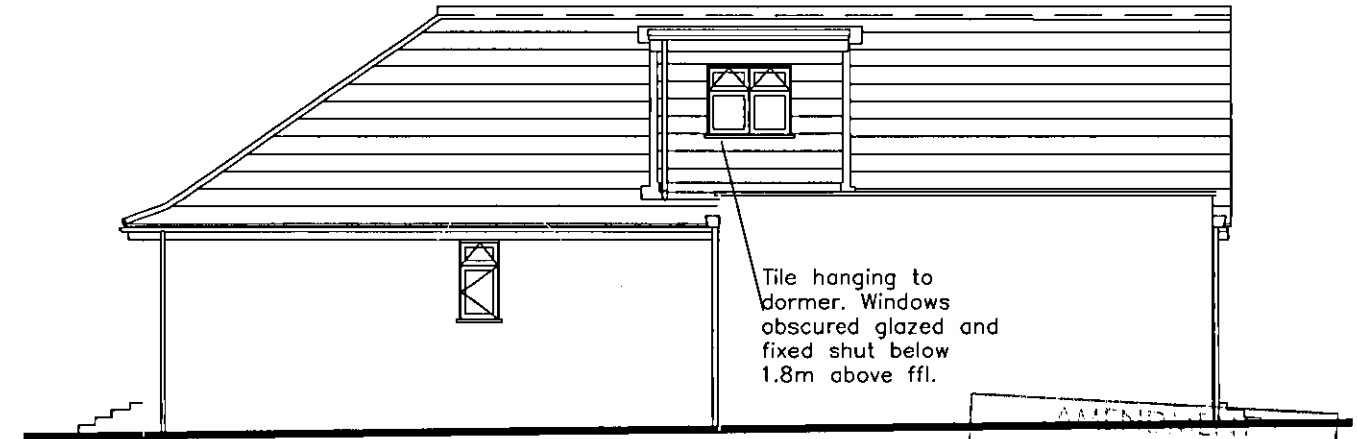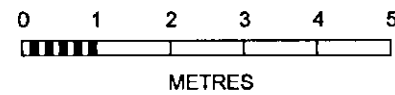

FLANK (NORTH)
ELEVATION

25 NOV 2009
NO: 62051/210/08

Revisions:

Suffix	Date	Drawn/	Description
A	Dec 07	PB	Planning Amendments
B	April 09	PB	Roof ht. & first floor
C	April 09	BPS	Amended notation for planning
D	Jul 09	PB	Lowered roof & reduced dormer
E	Sep 09	BPS	Amended to incorporate Planning comments issued for
planning			
F	Nov09	BPS	Minor amendments for planning

GENERAL
Do not scale drawings. Report any dimensional discrepancies.

©This drawing is the property of Philip Bailey Architects and must not be copied or reproduced in full or in part without express written permission

- Approval
- Preliminary
- Information
- Tender
- Construction
- As Built

Project 36 Theobolds Road Cuffley

Drawing Proposed Elevations

Format A3

Client Mr & Mrs Leake

Scale 1:100@A3

Date July07

Project 409
Ref.

Drawing No. 08

Revision F

philip bailey
architects

11 Beaumont Gate
Shenley Hill
Radlett
Herts WD7 7AR
Tel: 01923 289960
Fax: 01923 289961