


NOTATION AND SPECIFICATION :

- MH = Manhole
- MW = Monitoring well
- SU = Drainage channel sump
- G = Gully
- CV = Closure valve
- SW — Storm Water Sewer (Blue)
- CSW — Storm Water Sewer (Brown)
- FW — Foul Water Sewer (Red)
- CWS — Combined Water Sewer (Green)

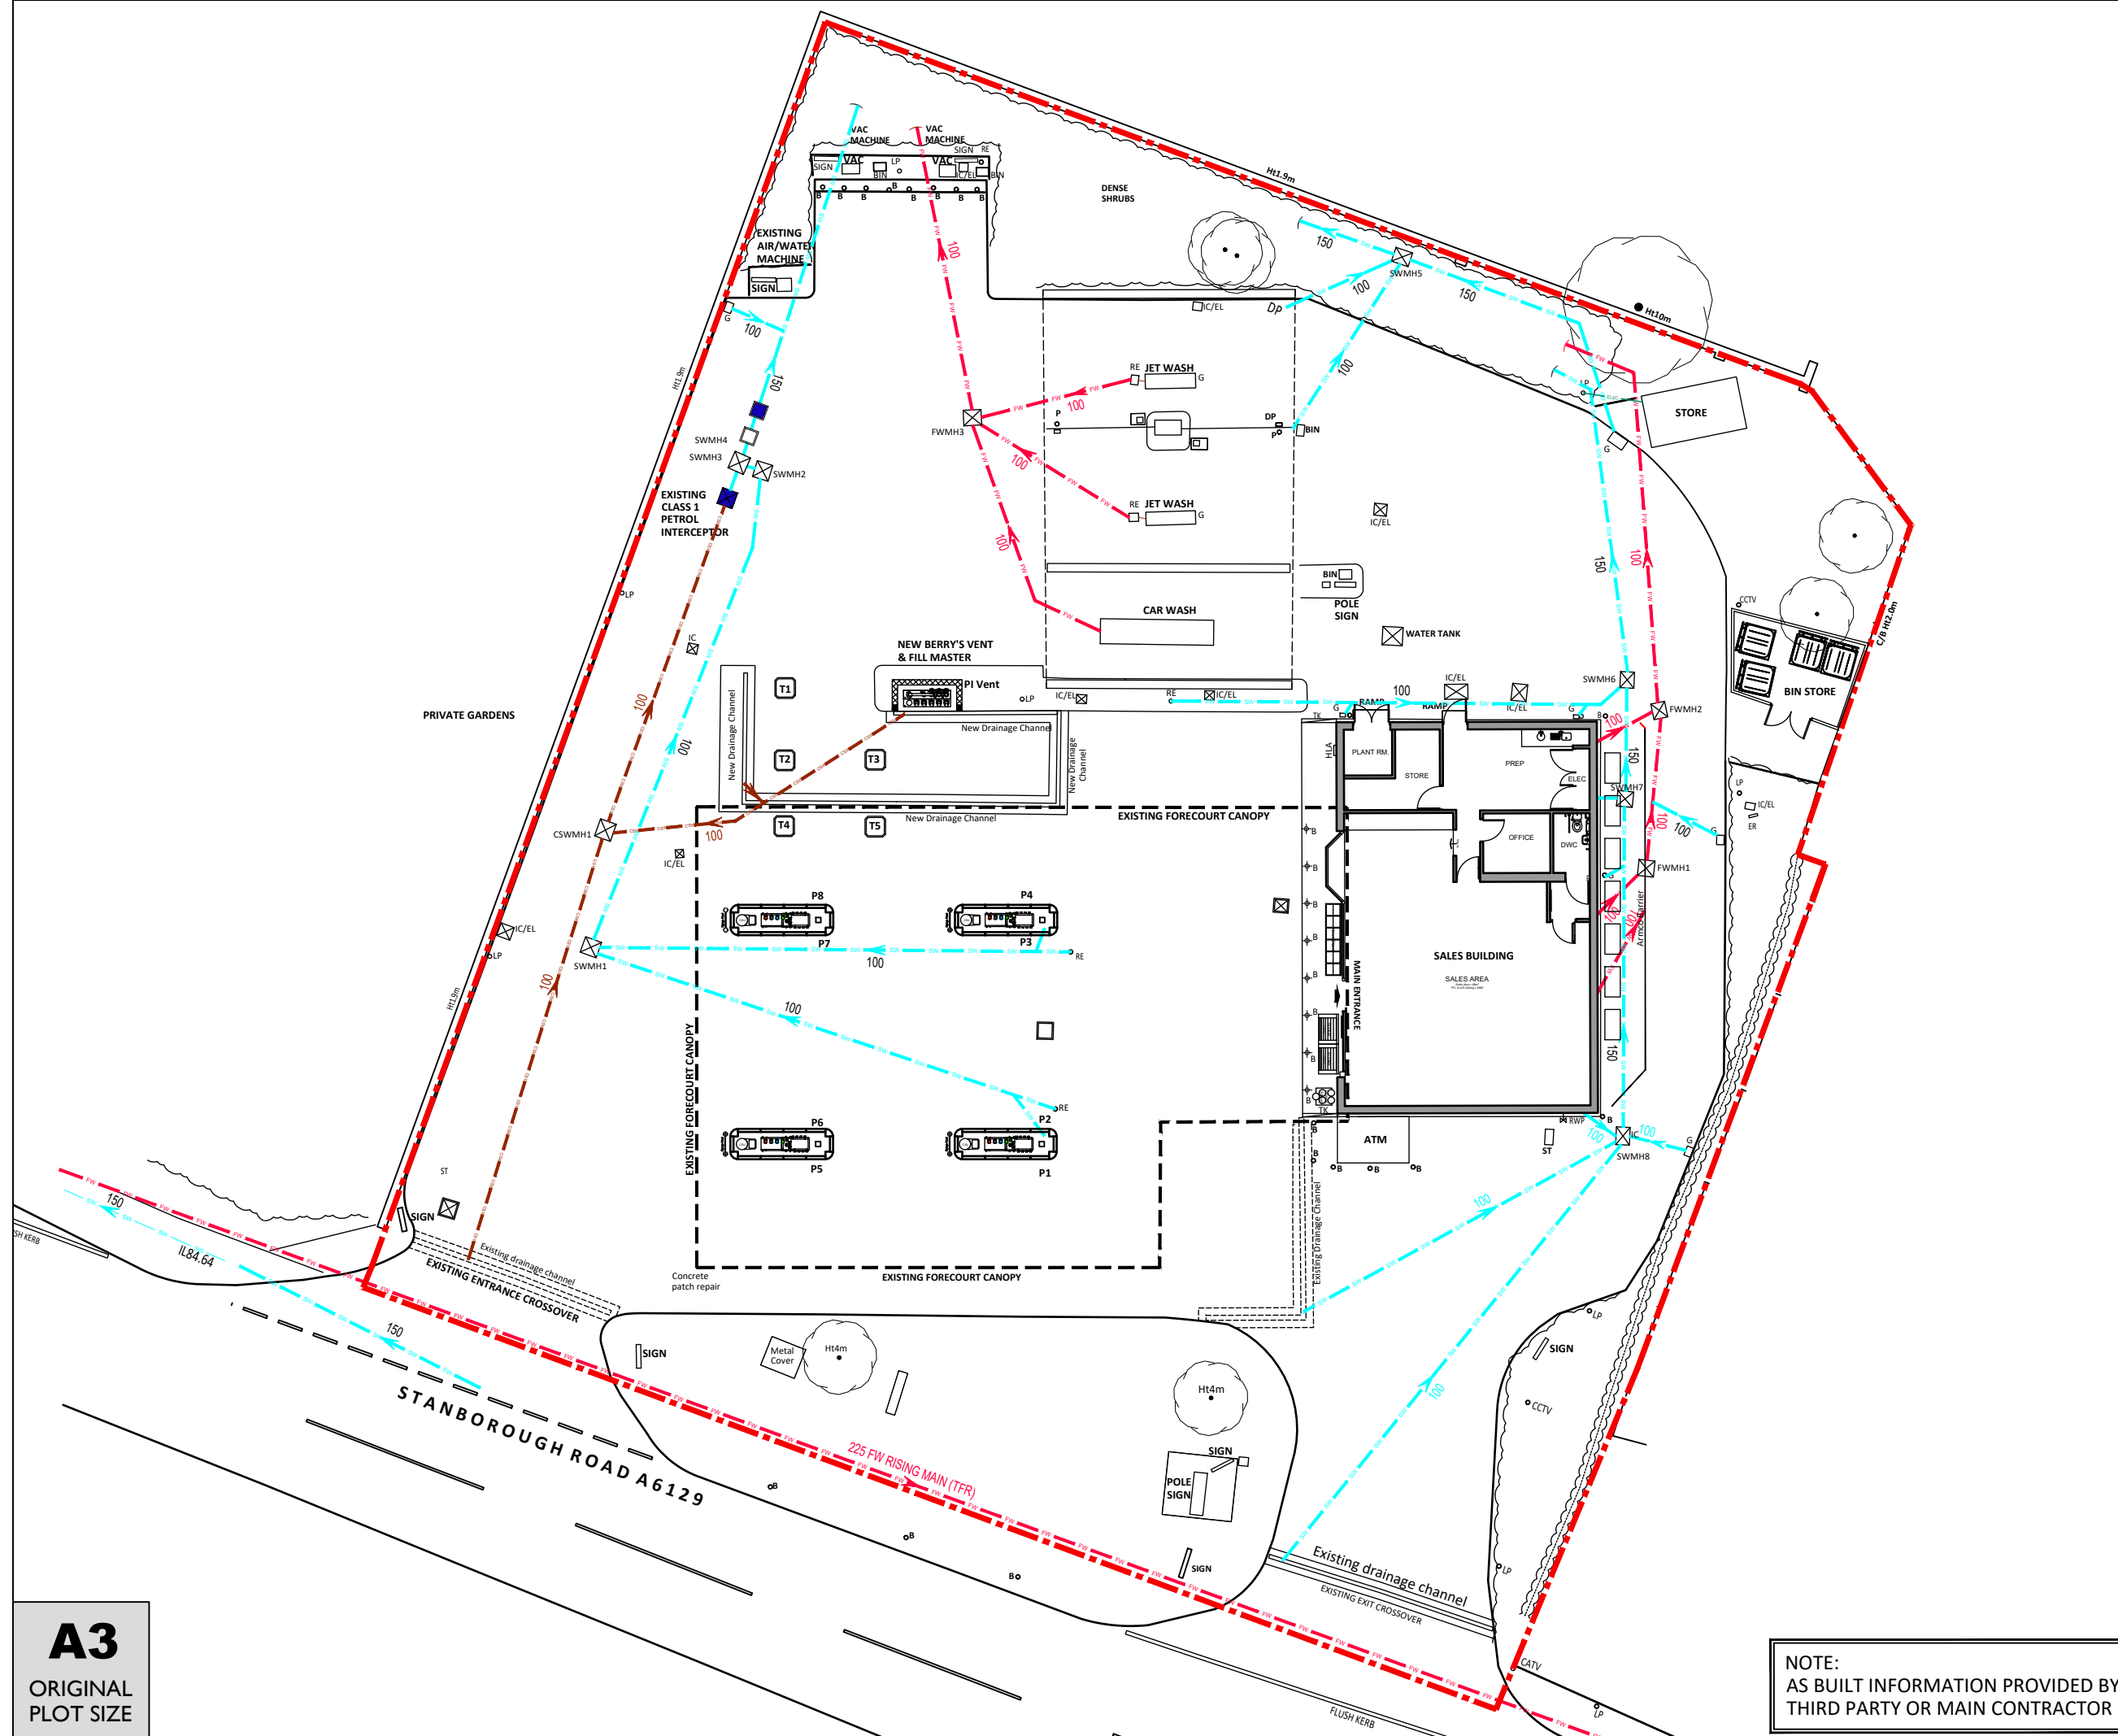

PROJECT MANAGERS:

DESIGNERS:

MBH Design Studio Ltd.
Rosemount House, Rosemount Avenue, West Byfleet, Surrey, KT14 6LB
www.mbh Ltd.com t: 01932 352 727 f: 01932 351 545

PHASE: RECORD DRAWING

REV	DATE	BY

PROJECT: **WELWYN GARDEN SERVICE STATION**
STANBOROUGH ROAD,
WELWYN GARDEN CITY AL8 6XA

TITLE: **PPG21 DRAINAGE DRAWING**

SHELL UK RETAIL
SHELL CENTRE
YORK ROAD, LONDON
SE1 7NA
UNITED KINGDOM

DRAWN BY: BKV	SCALE: NTS@A3
DATE: 05.10.17	PLOT DATE: 05.10.17
CAD FILE: E:\ARCHIVE\13140\DRAWINGS\WELWYN 12038629-ASB-MDR17	
DWG No: 12038629	PPG21 17 ASB

NOTE:
AS BUILT INFORMATION PROVIDED BY
THIRD PARTY OR MAIN CONTRACTOR

A3
ORIGINAL
PLOT SIZE