

- Legend**
- 2008 Re-Installed Vertase FLI Borehole Locations
 - Re-Installed Vertase FLI Borehole Locations
 - 2008 Re-Installed STATS Borehole Locations

Rev.	Description	Revised By	Date
A	As-Built B/H's Added	MRG	16-10-08
	FIRST ISSUE		29-09-04



- Bristol Head Office: Tel: 01275 397600 Fax: 01275 397601
 - Sheffield Office: Tel: 01246 813289 Fax: 01246 812963
 - Hertford Office: Tel: 01992 535757 Fax: 01992 535858
 - Manchester Office: Tel: 01614 372708 Fax: 01614 376300
- email: info@vertasefl.co.uk
www.vertasefl.com

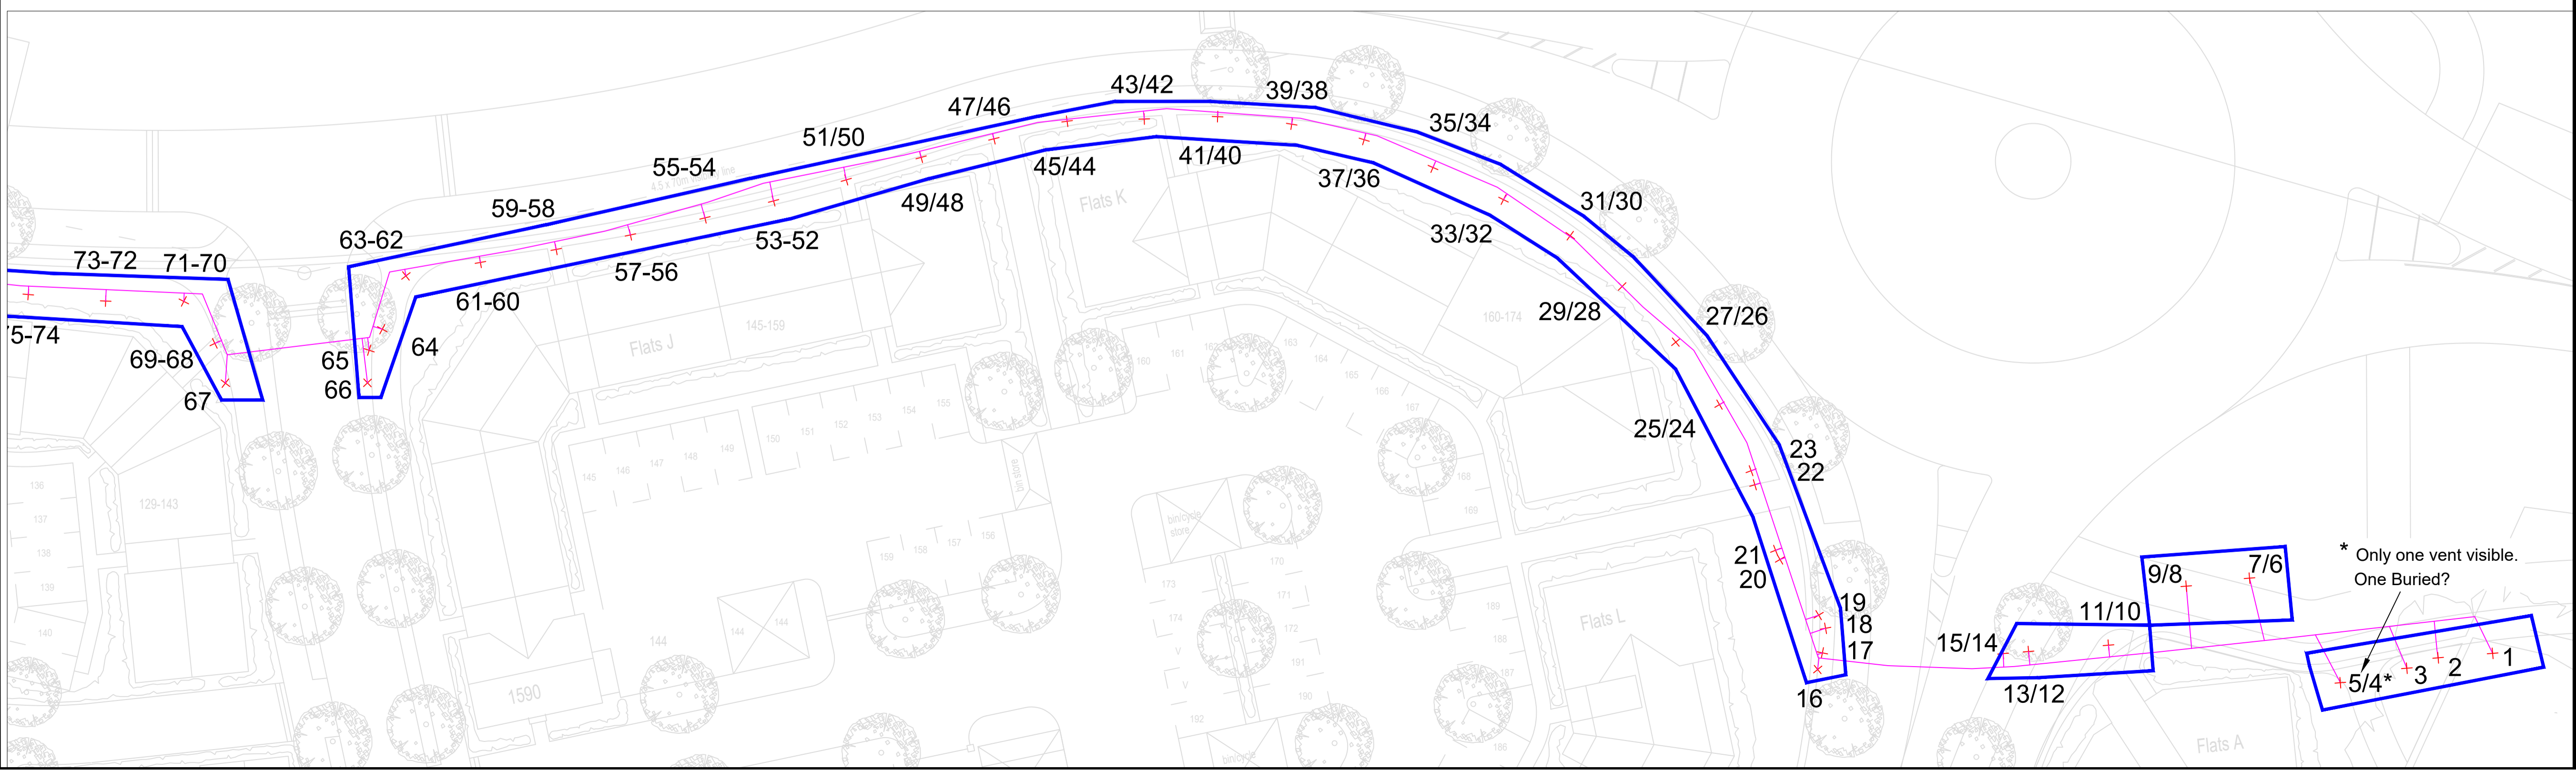
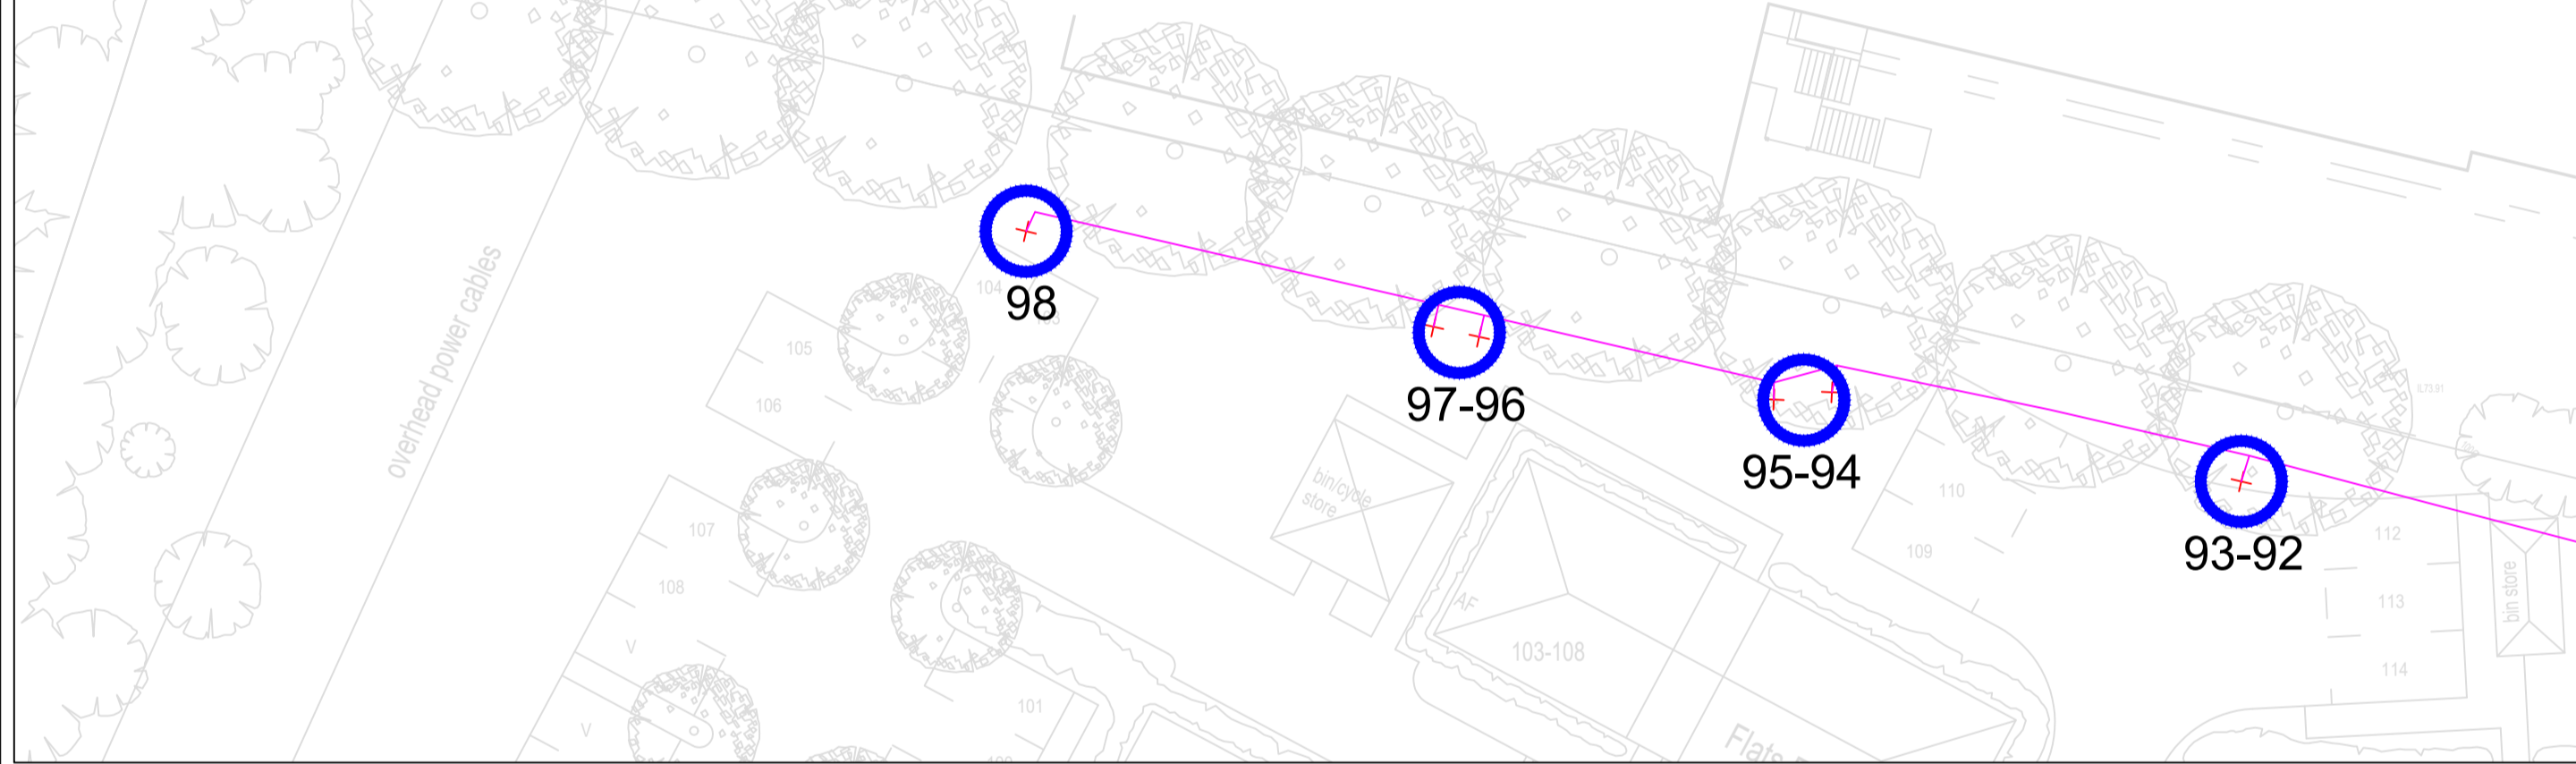
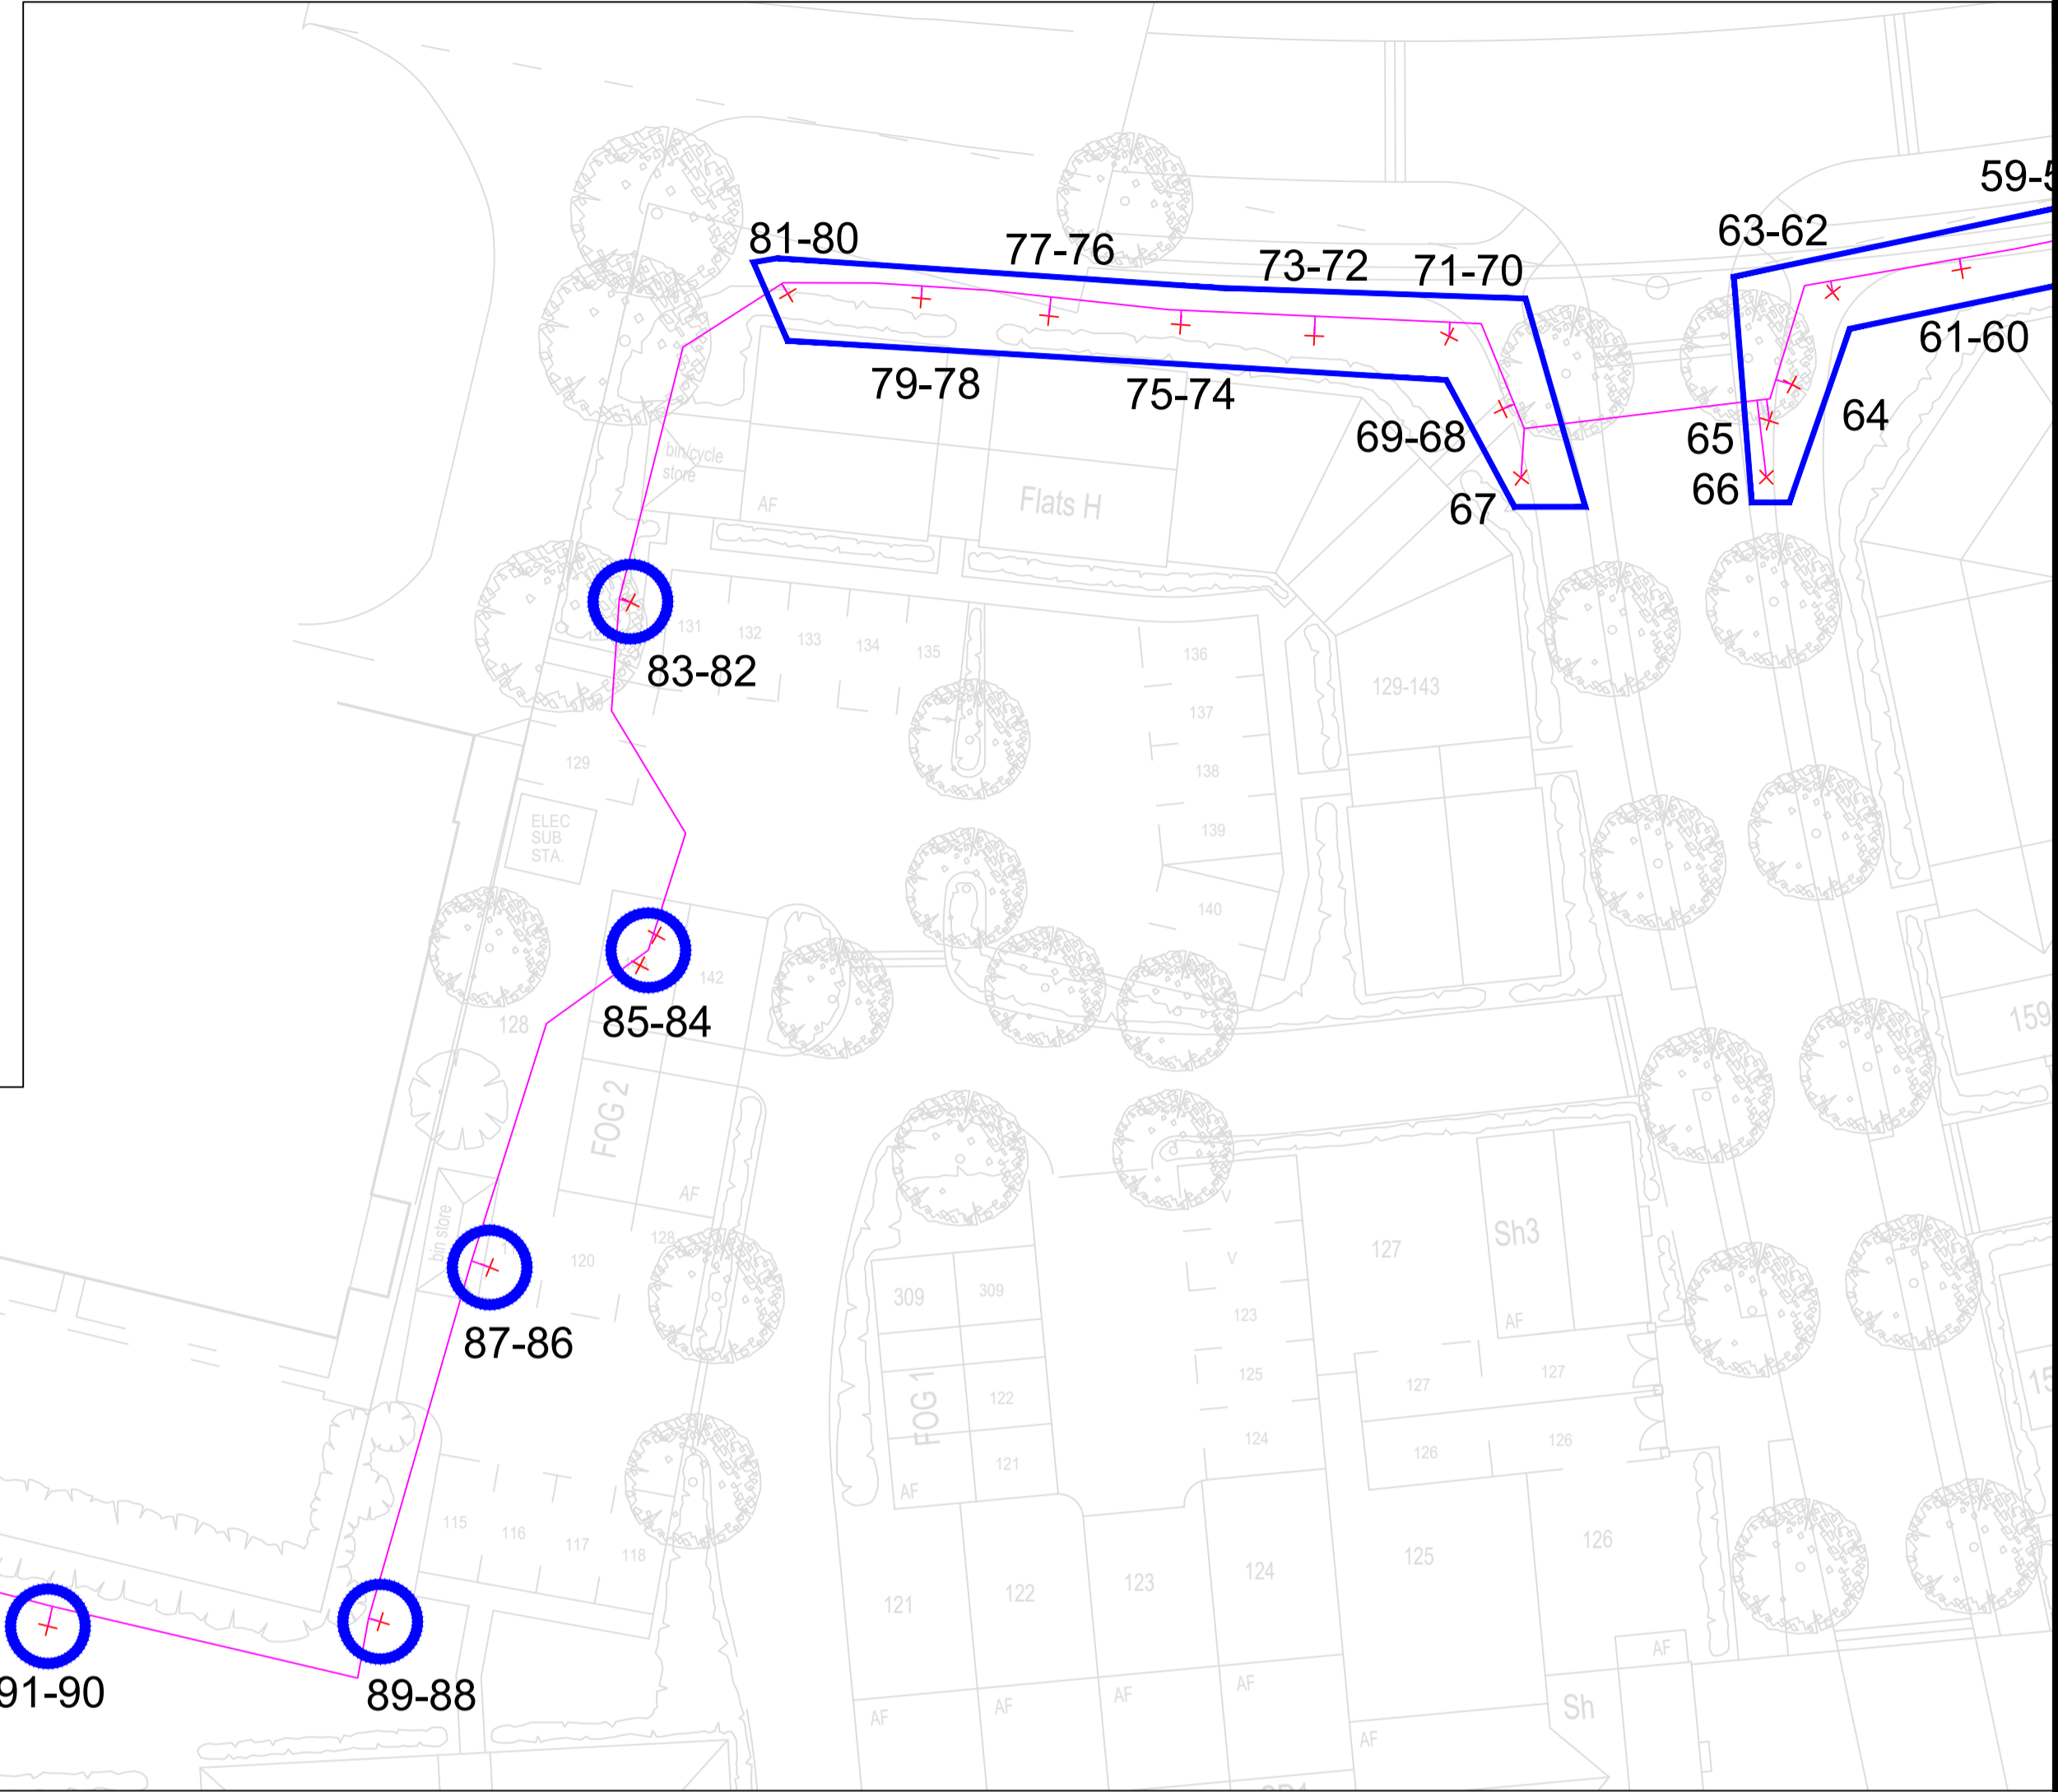
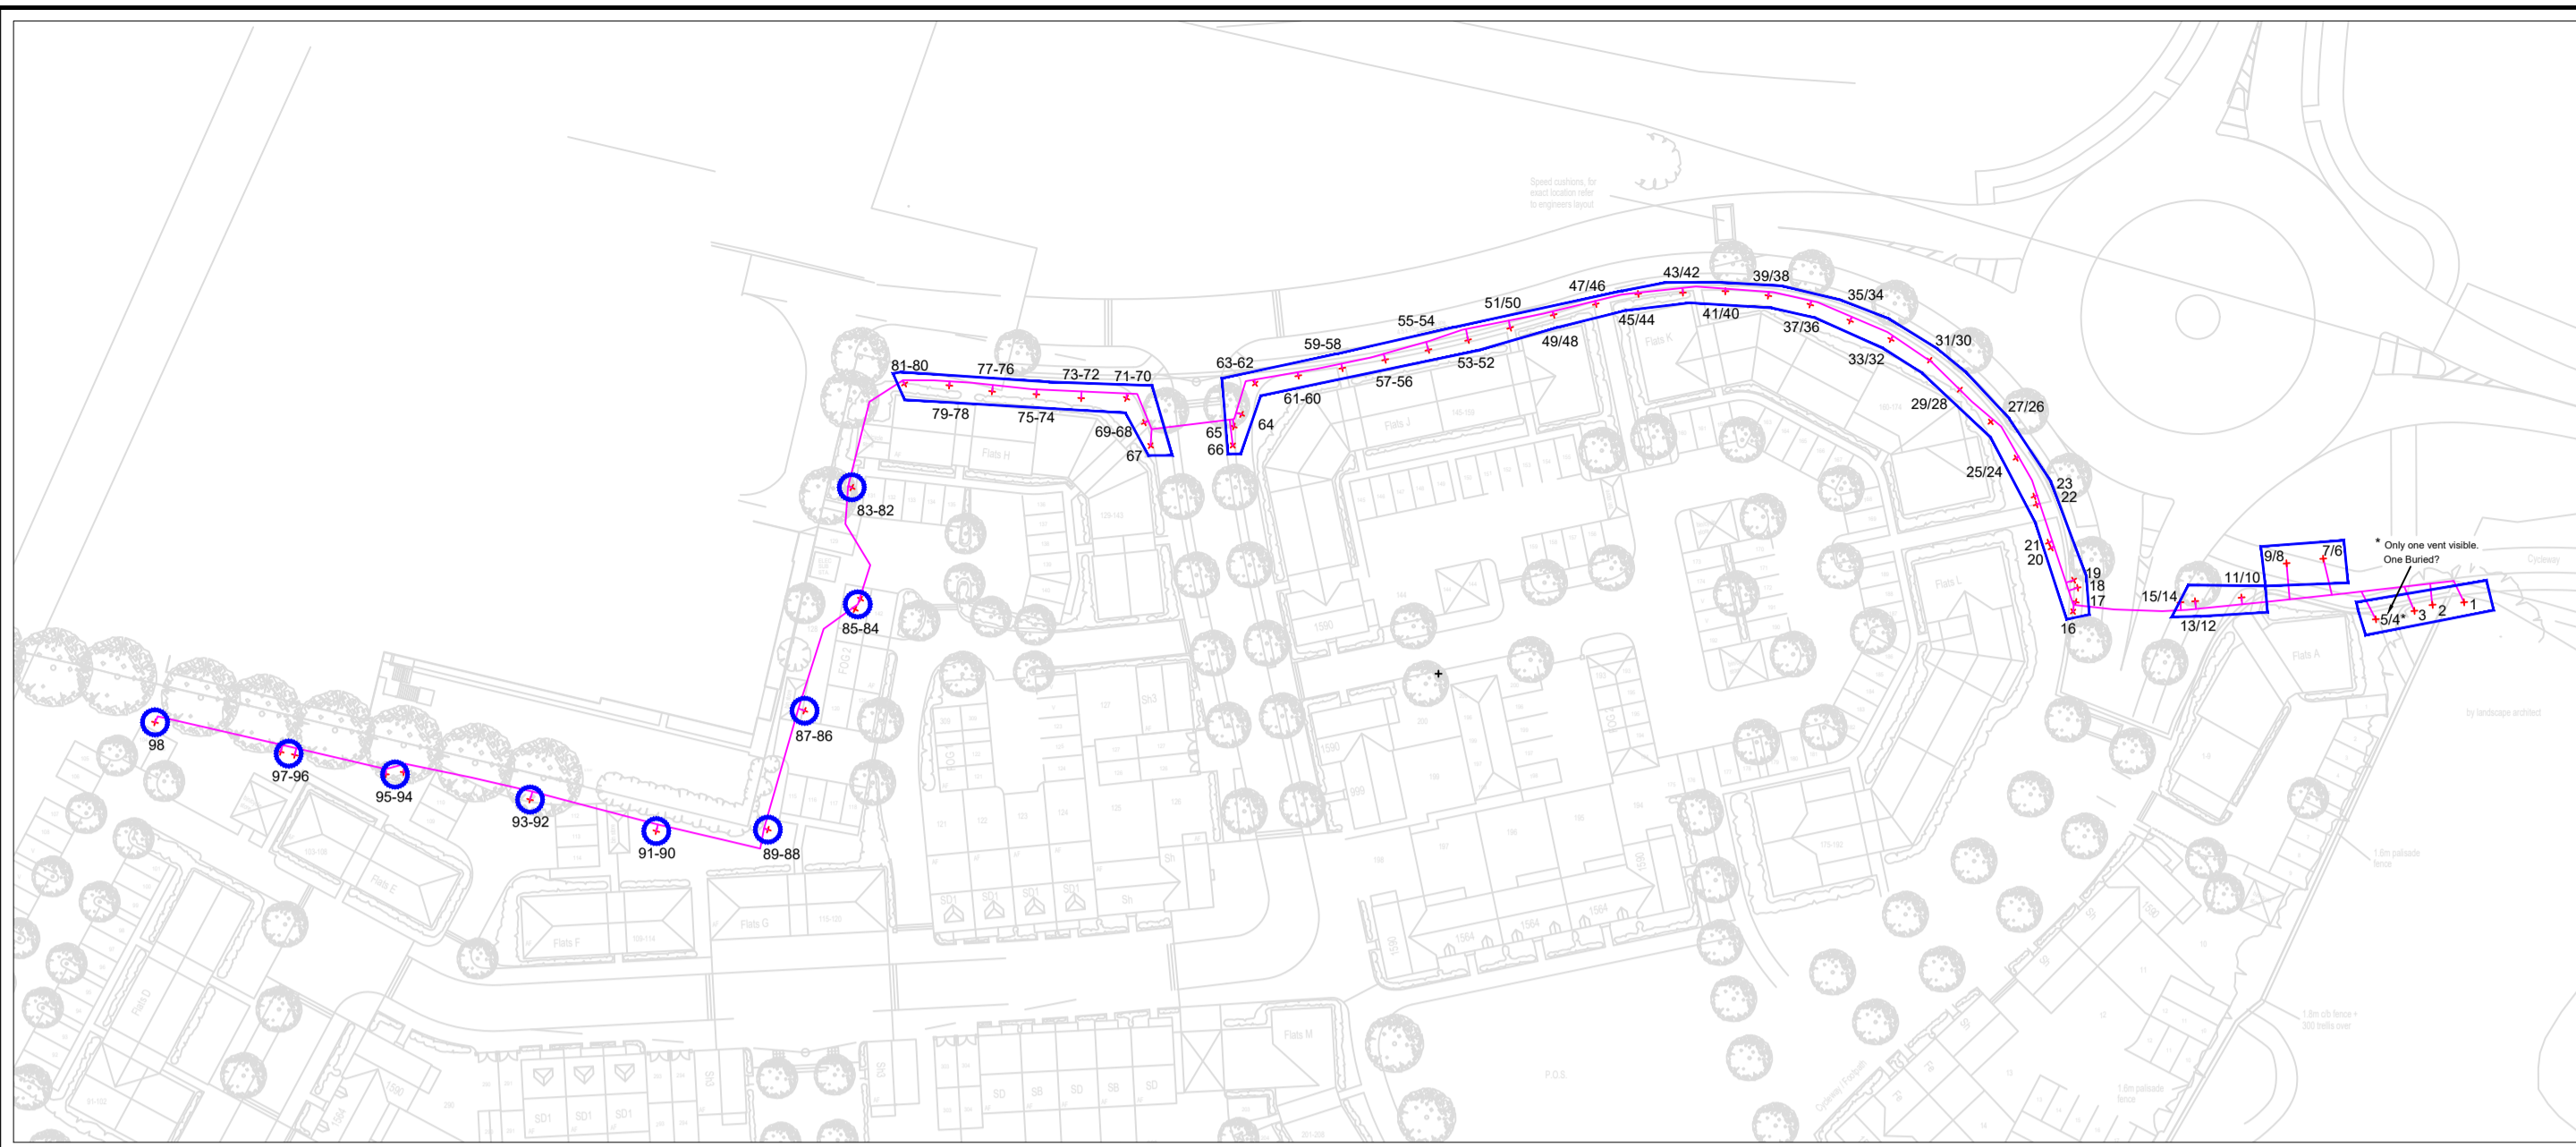
Site Address:
Chequersfield
Welwyn Garden City
Hertfordshire







Rev:
A

Title: Section 106 Gas Monitoring Locations		
Client: George Wimpey (North)		
Drawn: MRG	Checked: LH	Approved: LH
Dwg: D430/N	Contract: 958 GWN	Scale: 1:750

Appendix C

Vertase FLI design information for Virtual Curtain



- Legend**
-  Vent Headworks Installation Areas
 -  Vent Headworks Installation Areas
 -  As-built Virtual Curtain Wall
 -  Current Positions of Vents
 -  Southern Extent of Full Turnover to 2.80m Within Reworked Area
 -  Area to be Reworked

Notes:

1. Base layout information supplied by Wormold Burrows Partnership.

B	Vent Numbers Dotted	30 May 2006
A	VALIDATION ADDED	23 Jun 2005
	FIRST ISSUE	May 2005

Vertase F.L.I.

- Bristol Head Office: Tel: 0117 974 9180 Fax: 0117 947 0880
- Sheffield Office: Tel: 01246 813289 Fax: 01246 812963
- Hertford Office: Tel: 01992 535757 Fax: 01992 535858

email: info@vertasefli.co.uk
www.vertasefli.com

Site Address:
Chequersfield
Welwyn Garden City
Hertfordshire

Title: VGC Vent Installations (as installed) Positions

Client: George Wimpey North London

Scale: NTS	Drawn By: AN
Drawing No: D430R	Contract No: 430 GWN