



NOTES

55.390

SURVEYED POINT

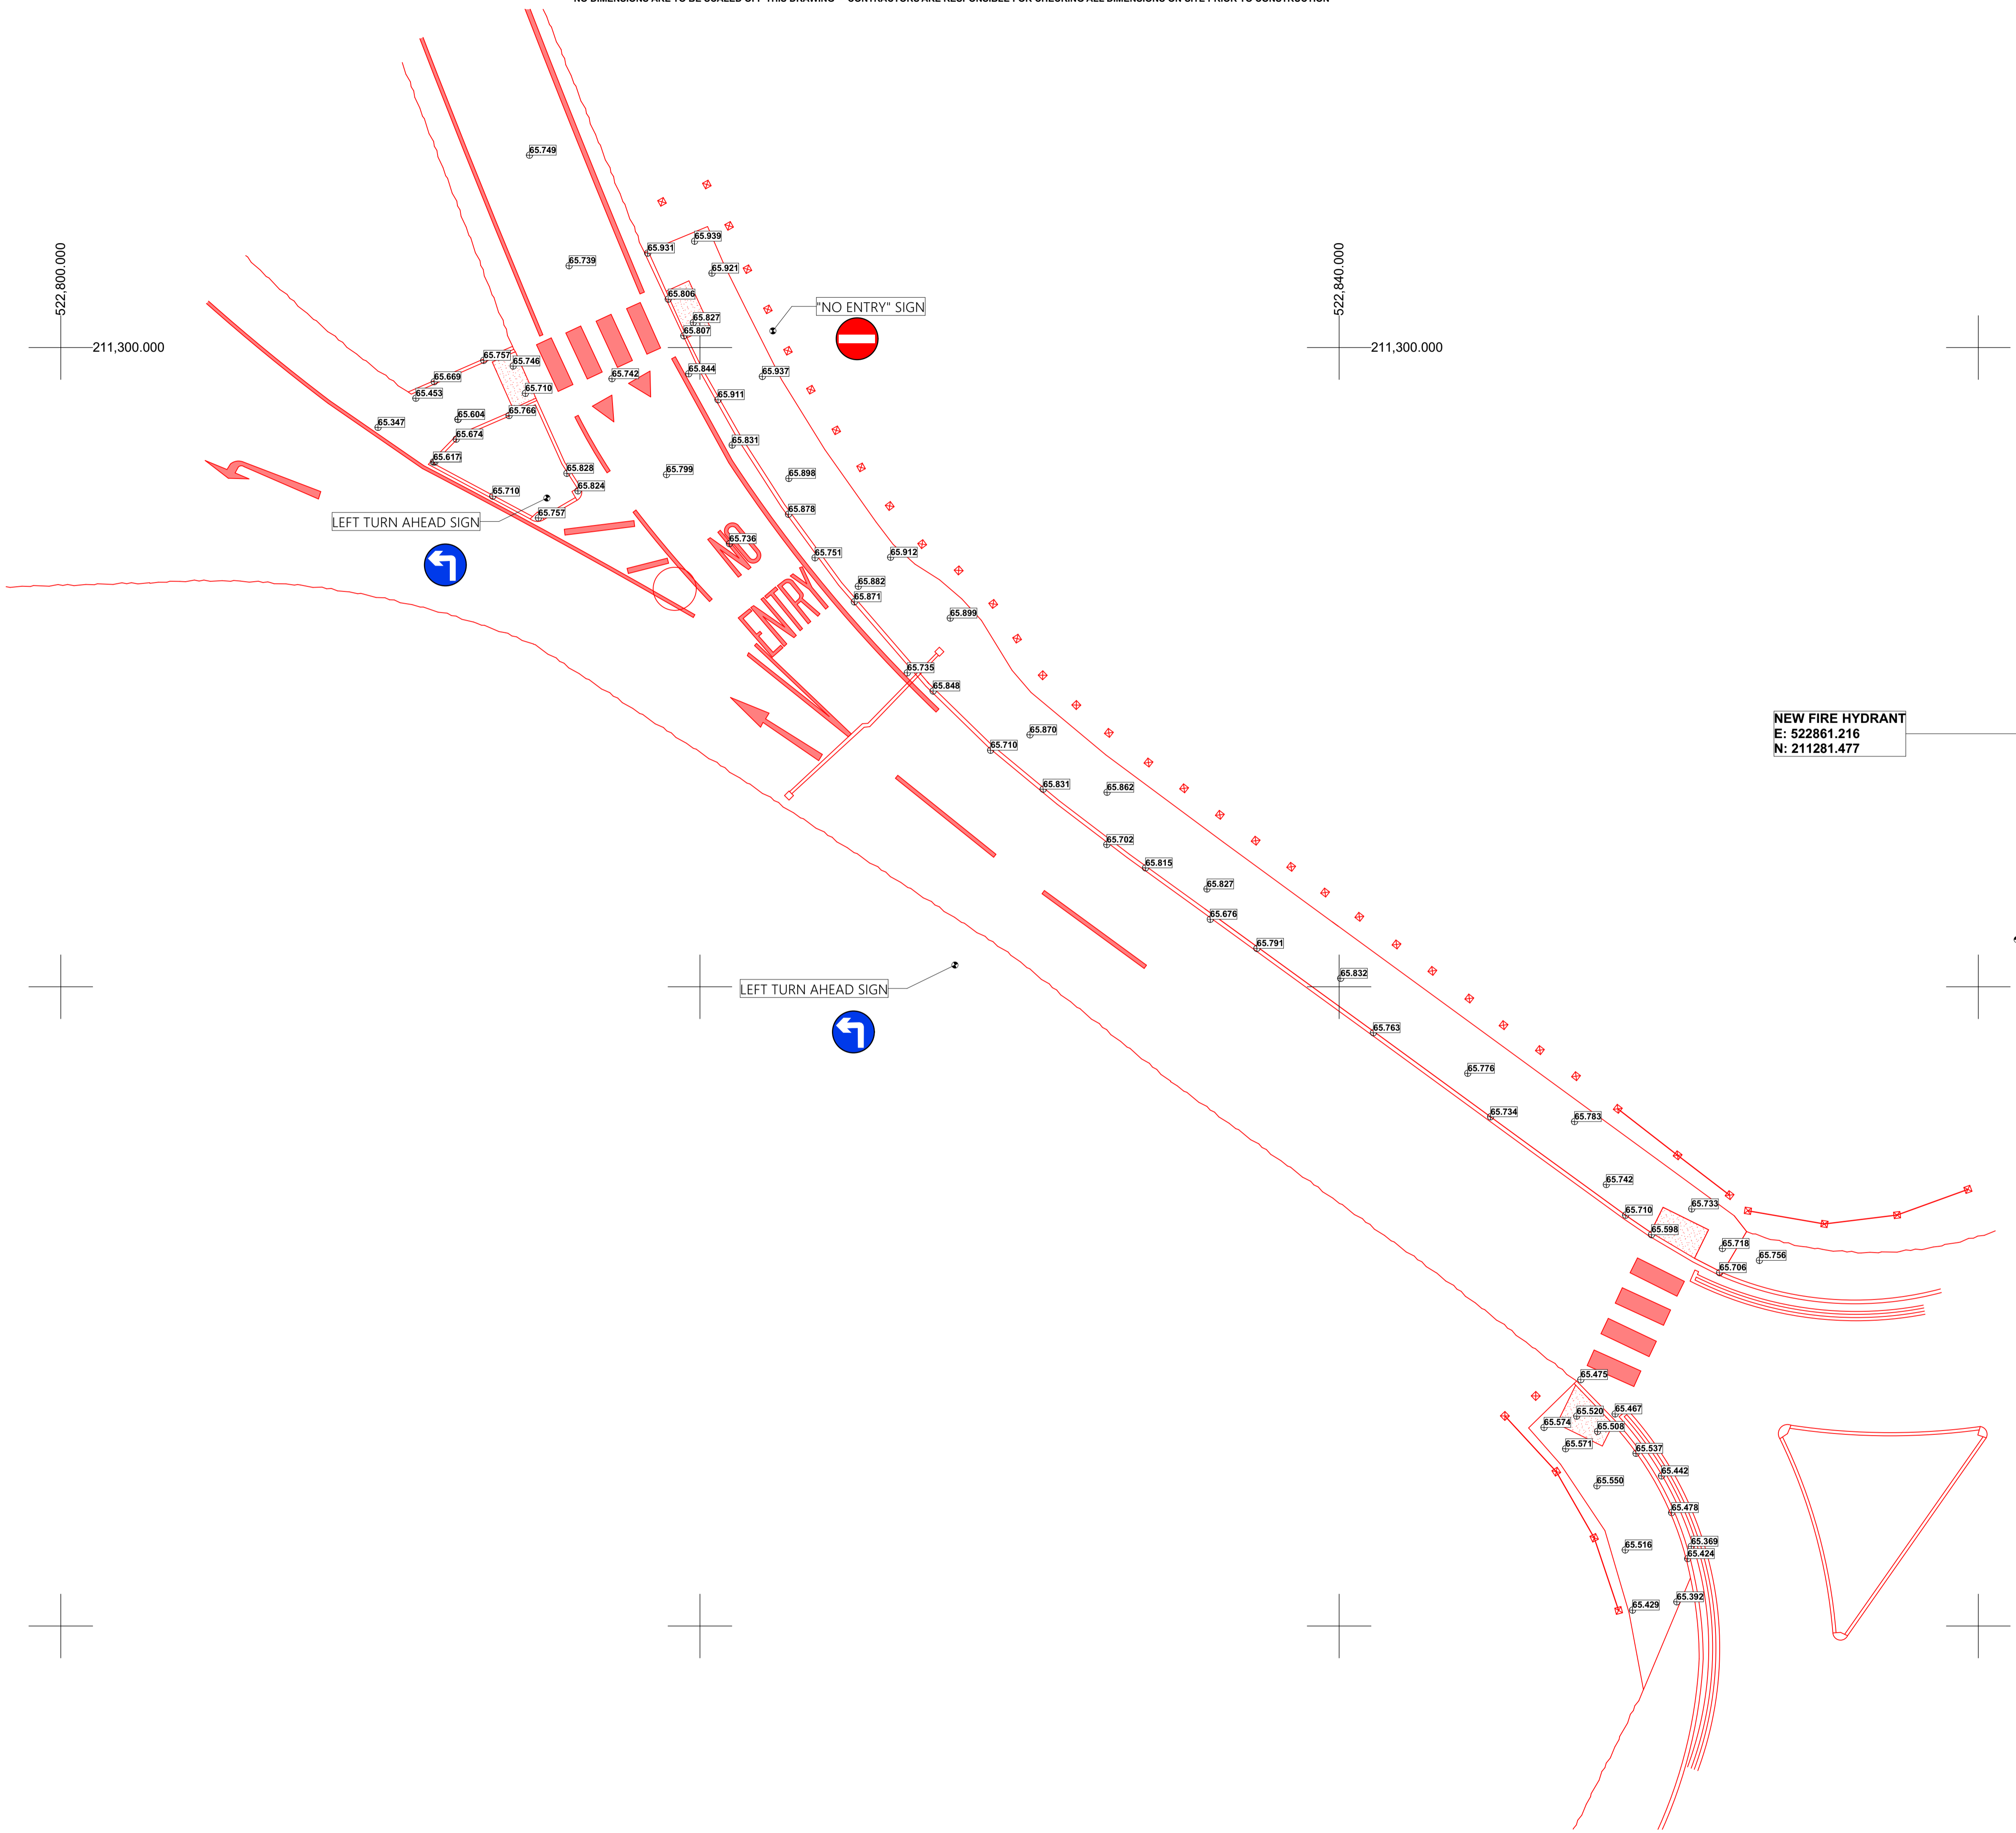

rev	date	by	chk	description
A	11/08/2020	Z.T.	I.C.	Entrance Road As-Built Survey

 SouthEast	
CSI SouthEast Ltd. P.O. Box 3661, Wokingham Berkshire, RG40 9NX Tel: +44 (0) 744 971 5827 www.csi-southeast.co.uk	
Client:	GROUND CONTROL
Project:	STANBOROUGH PARK WELWYN GARDEN CITY, AL8 6DF
Drawing title:	ENTRANCE AS-BUILT SURVEY
Scale:	1:100@A1
Date:	11/08/2020
Drawn:	I. Cs.
Drawing status:	SURVEY DRAWING
Drawing No.:	CS1228-S-E04
Sheet:	1/1
Revision:	A