




REAR ELEVATION

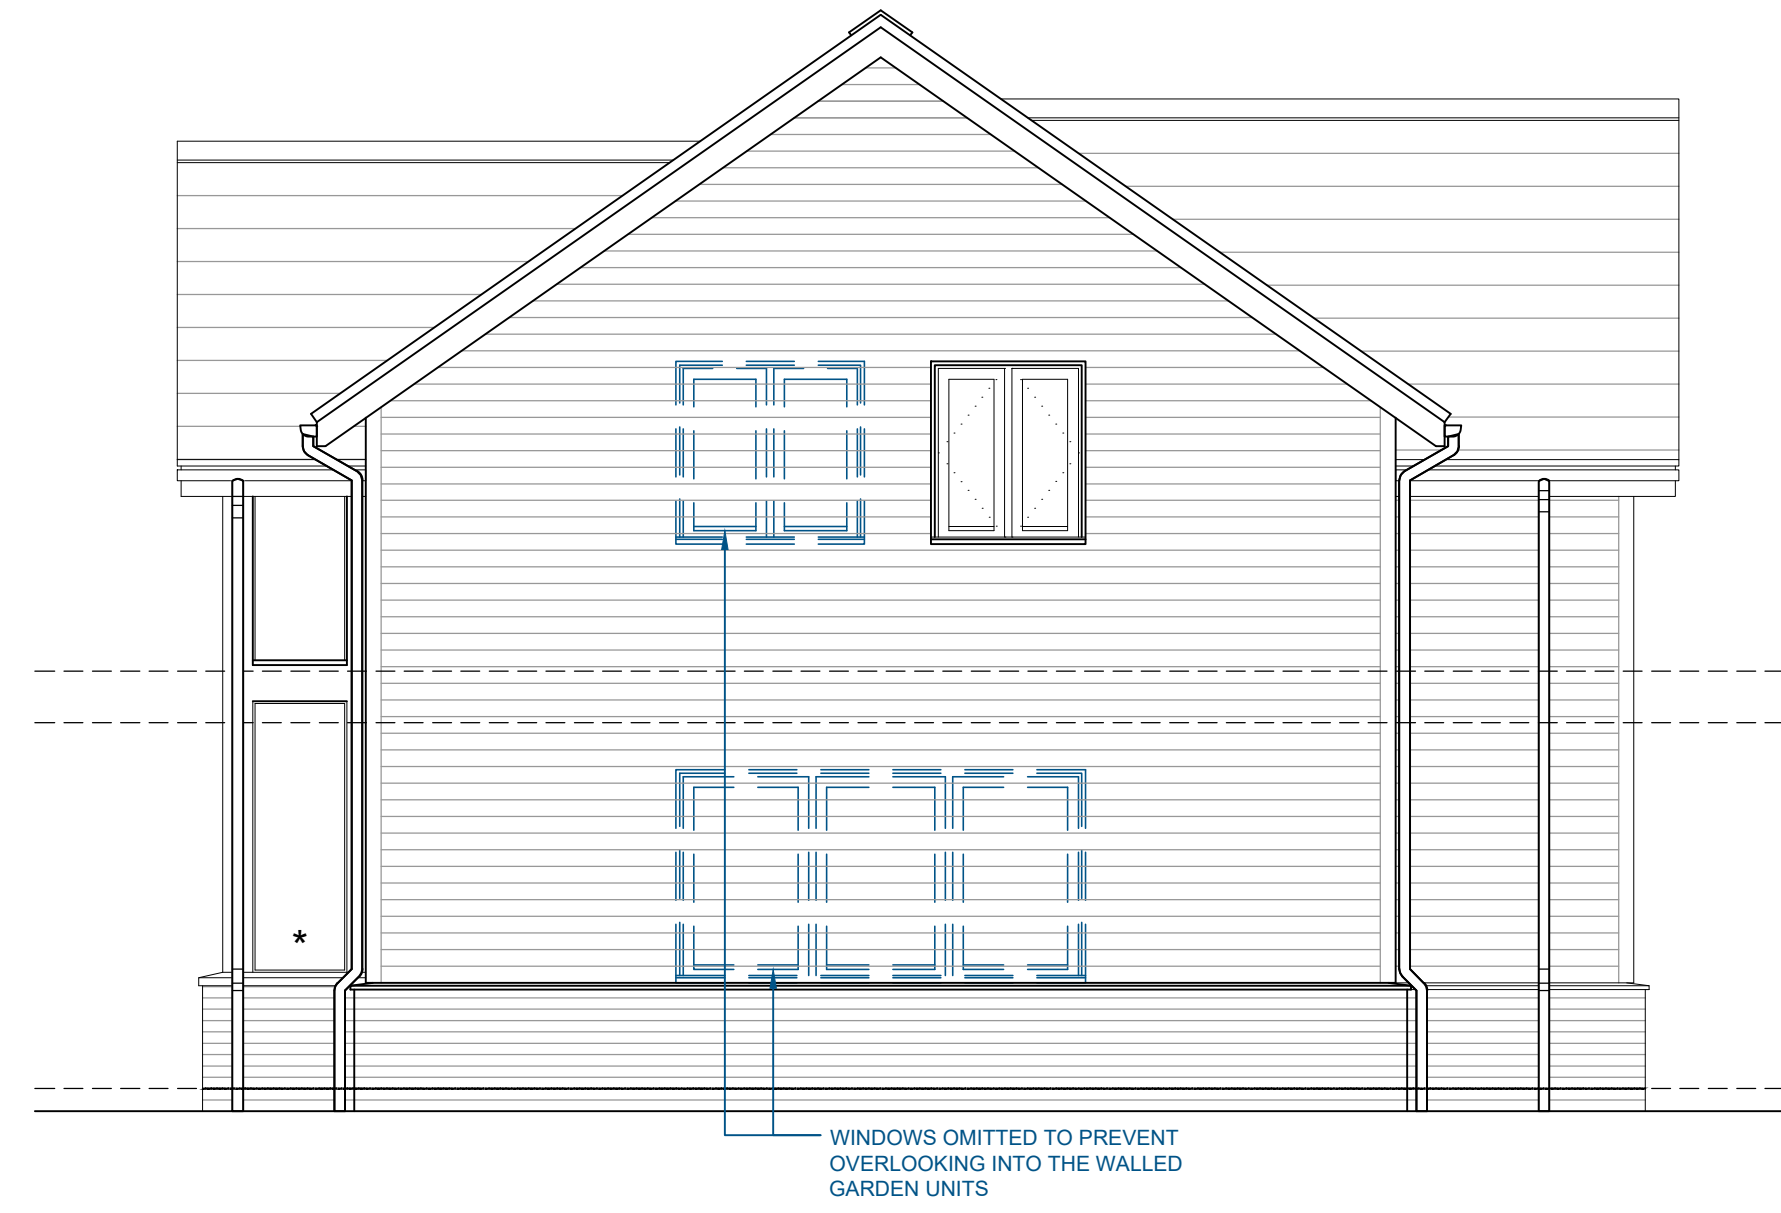

SIDE ELEVATION

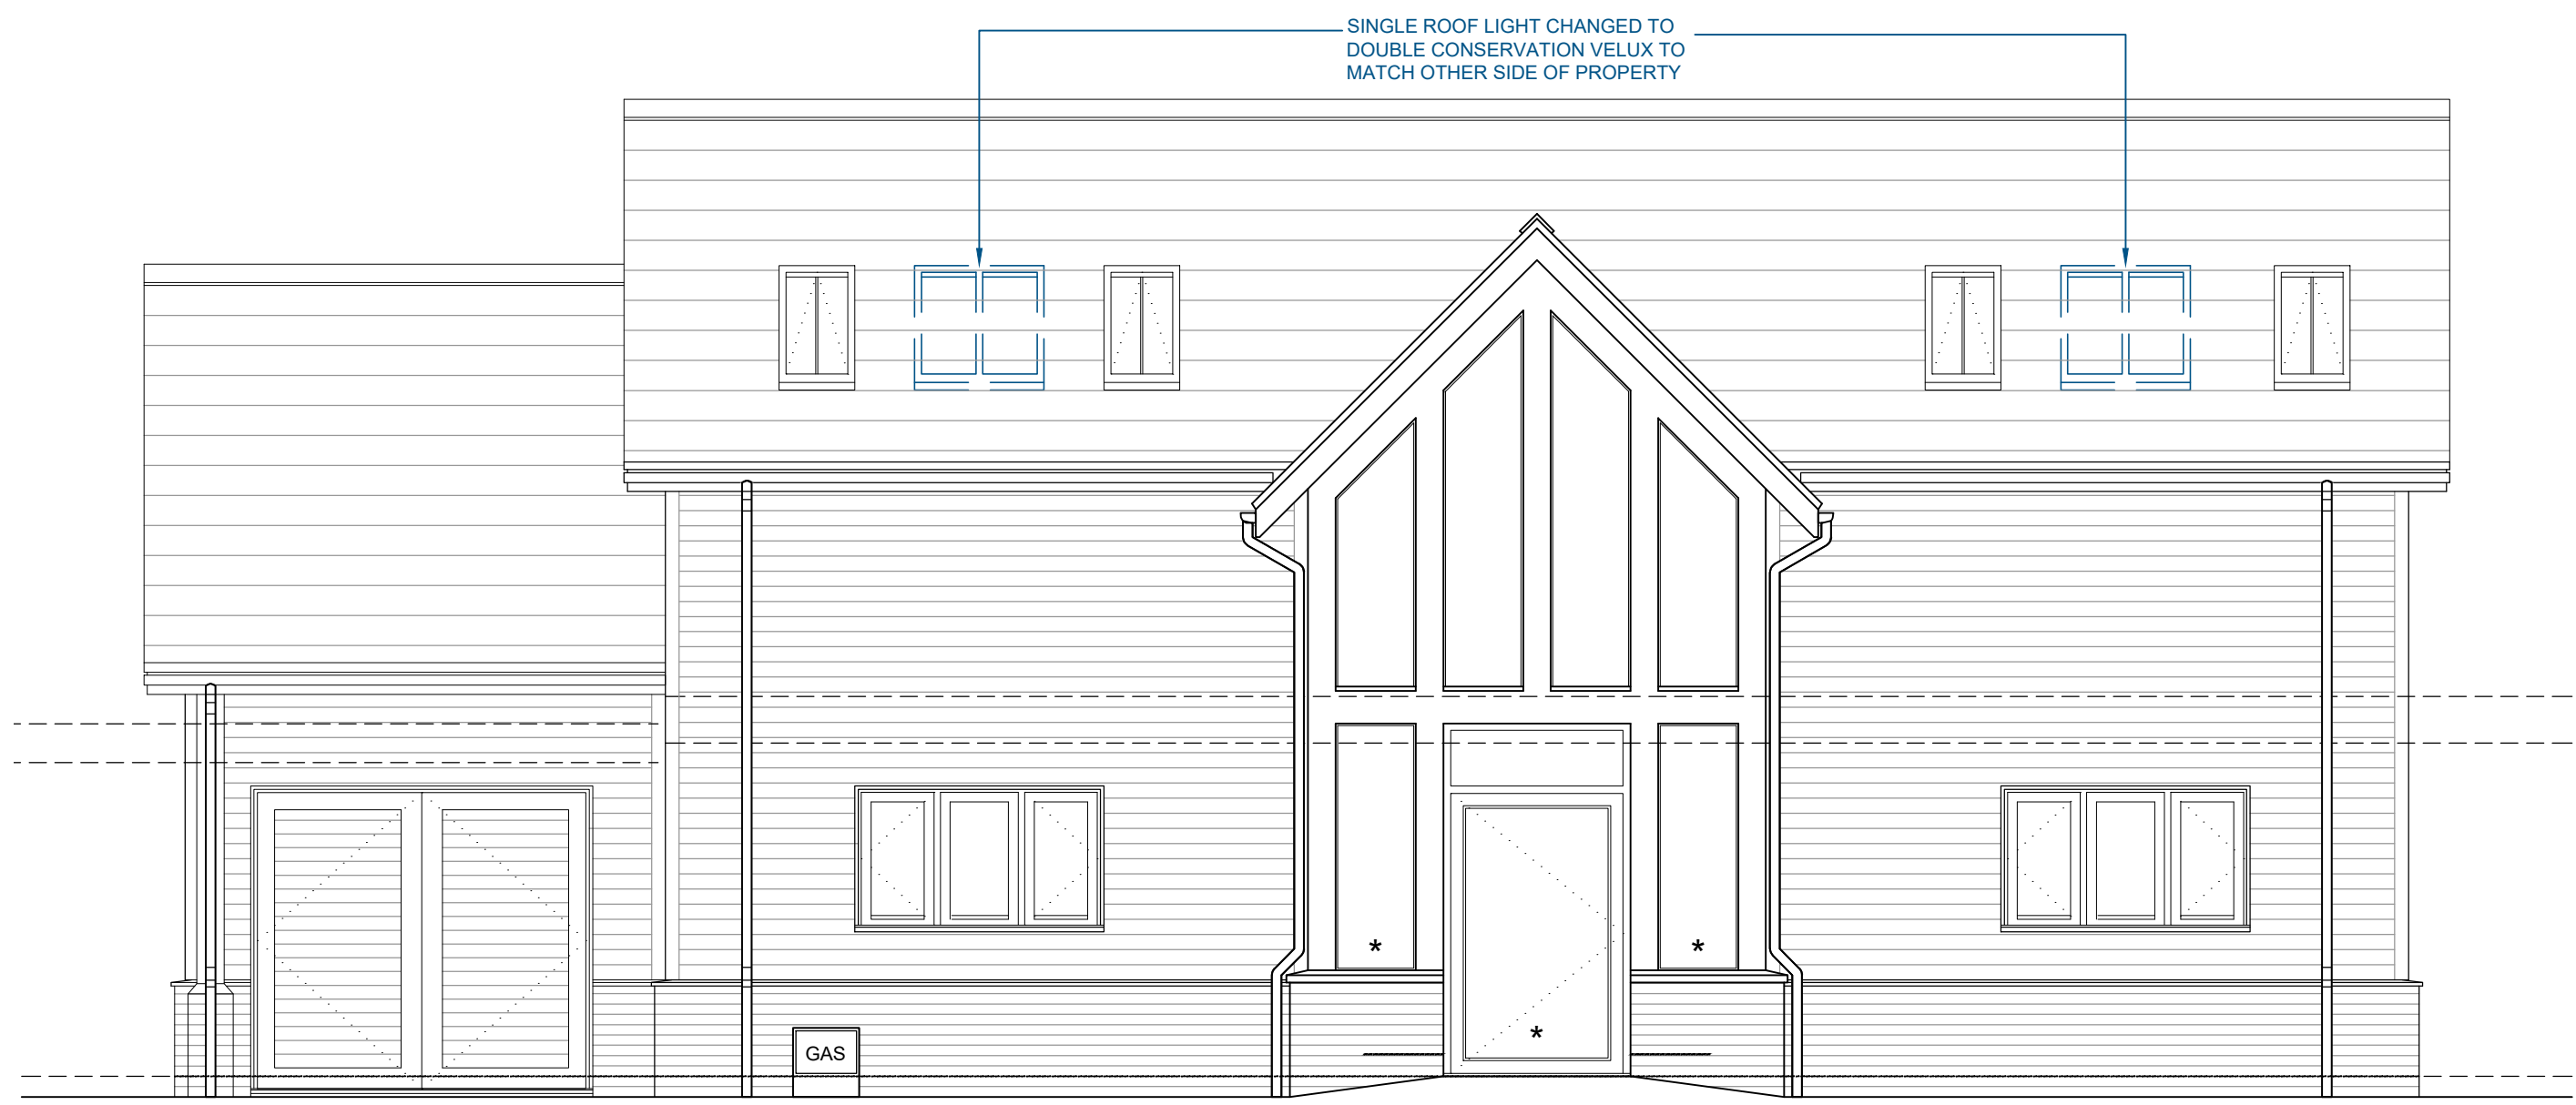

FRONT ELEVATION

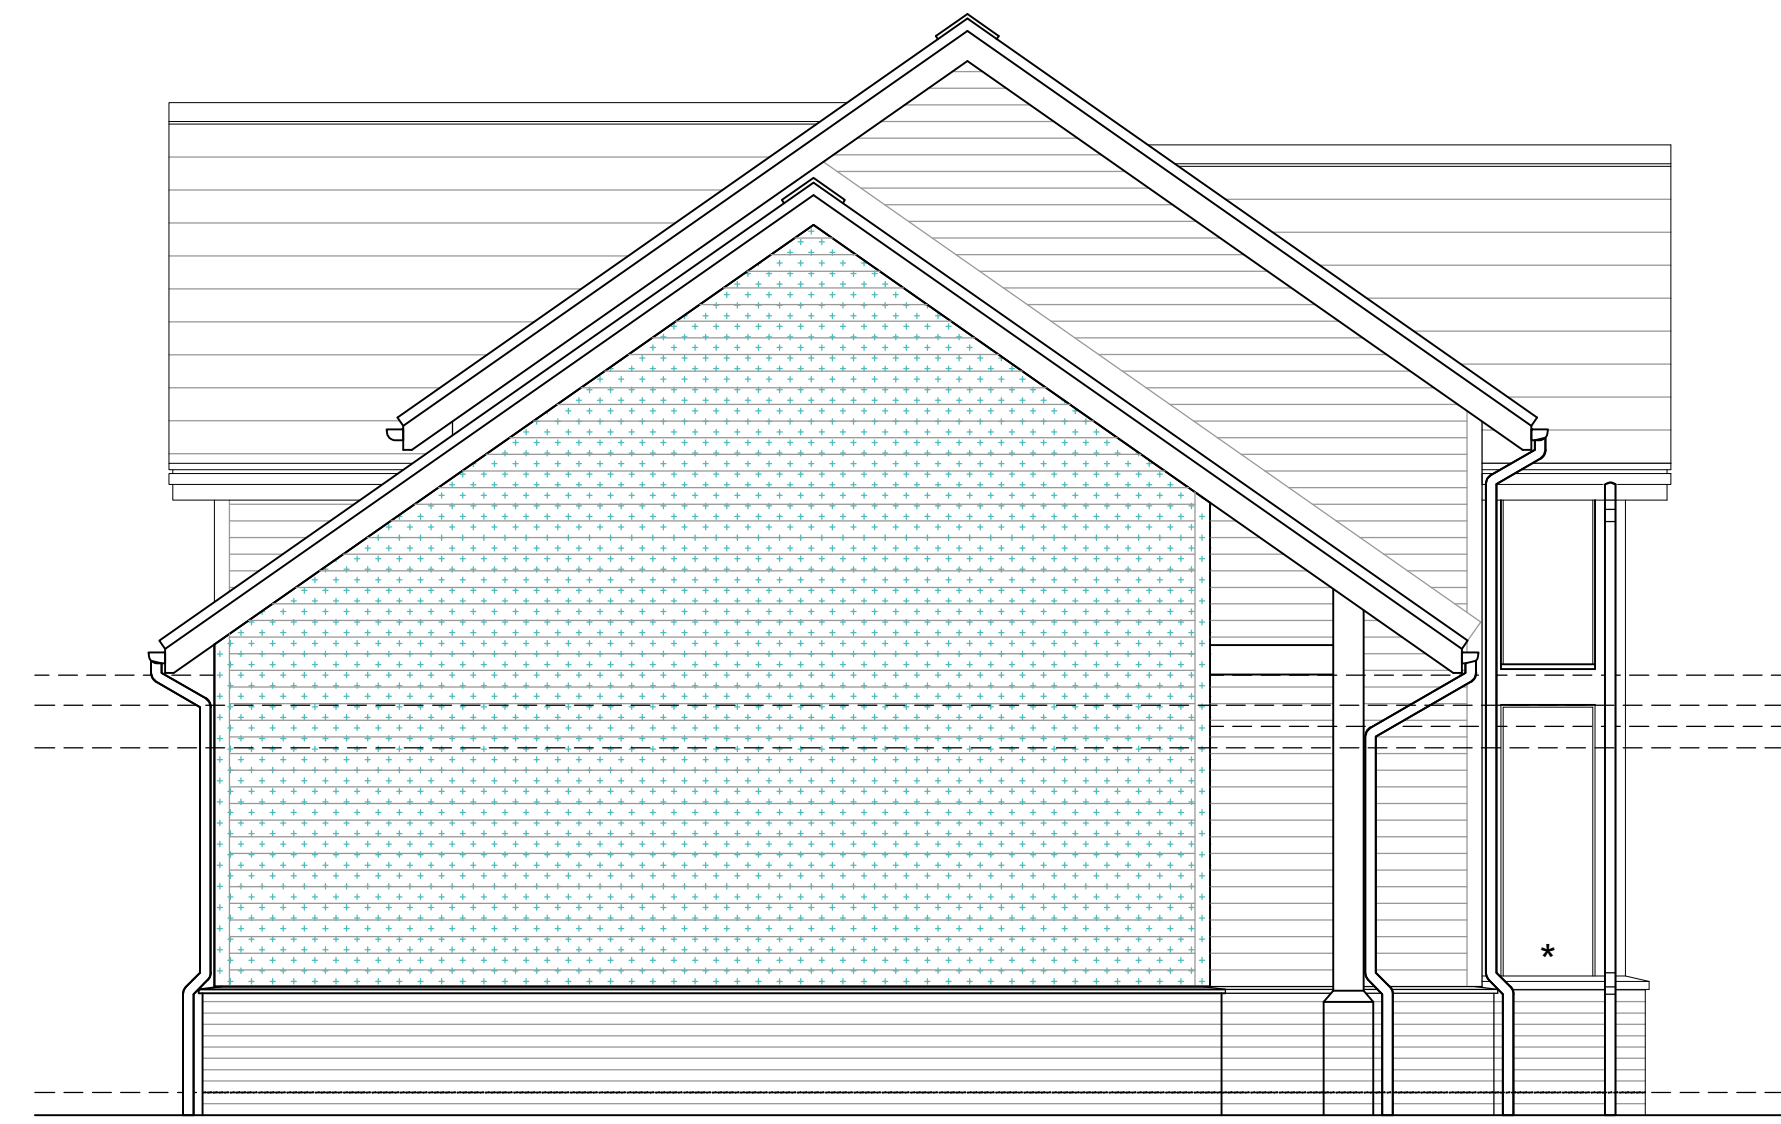

SIDE ELEVATION

P2 NMA AMENDMENTS TO CLIENT'S MARKUP SENT 02/06/21 08/06/21 JP
 P1 Planning Issue 18/12/20 BW

PLANNING

Project
 NORTHAW HOUSE
 COOPERS LANE
 NORTHAW

Title
 SETTLEMENT UNIT 2
 PLOT 24 ELEVATIONS

Scale	A1	Date	18/12/2020
1:50	A3		
Drawn		Checked	DR
BW			
Drawing Number	Revision		
8250-SAU-SU2-1010-DR-A	P2		

Saunders
 Architecture+UrbanDesign