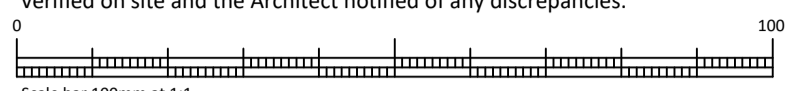
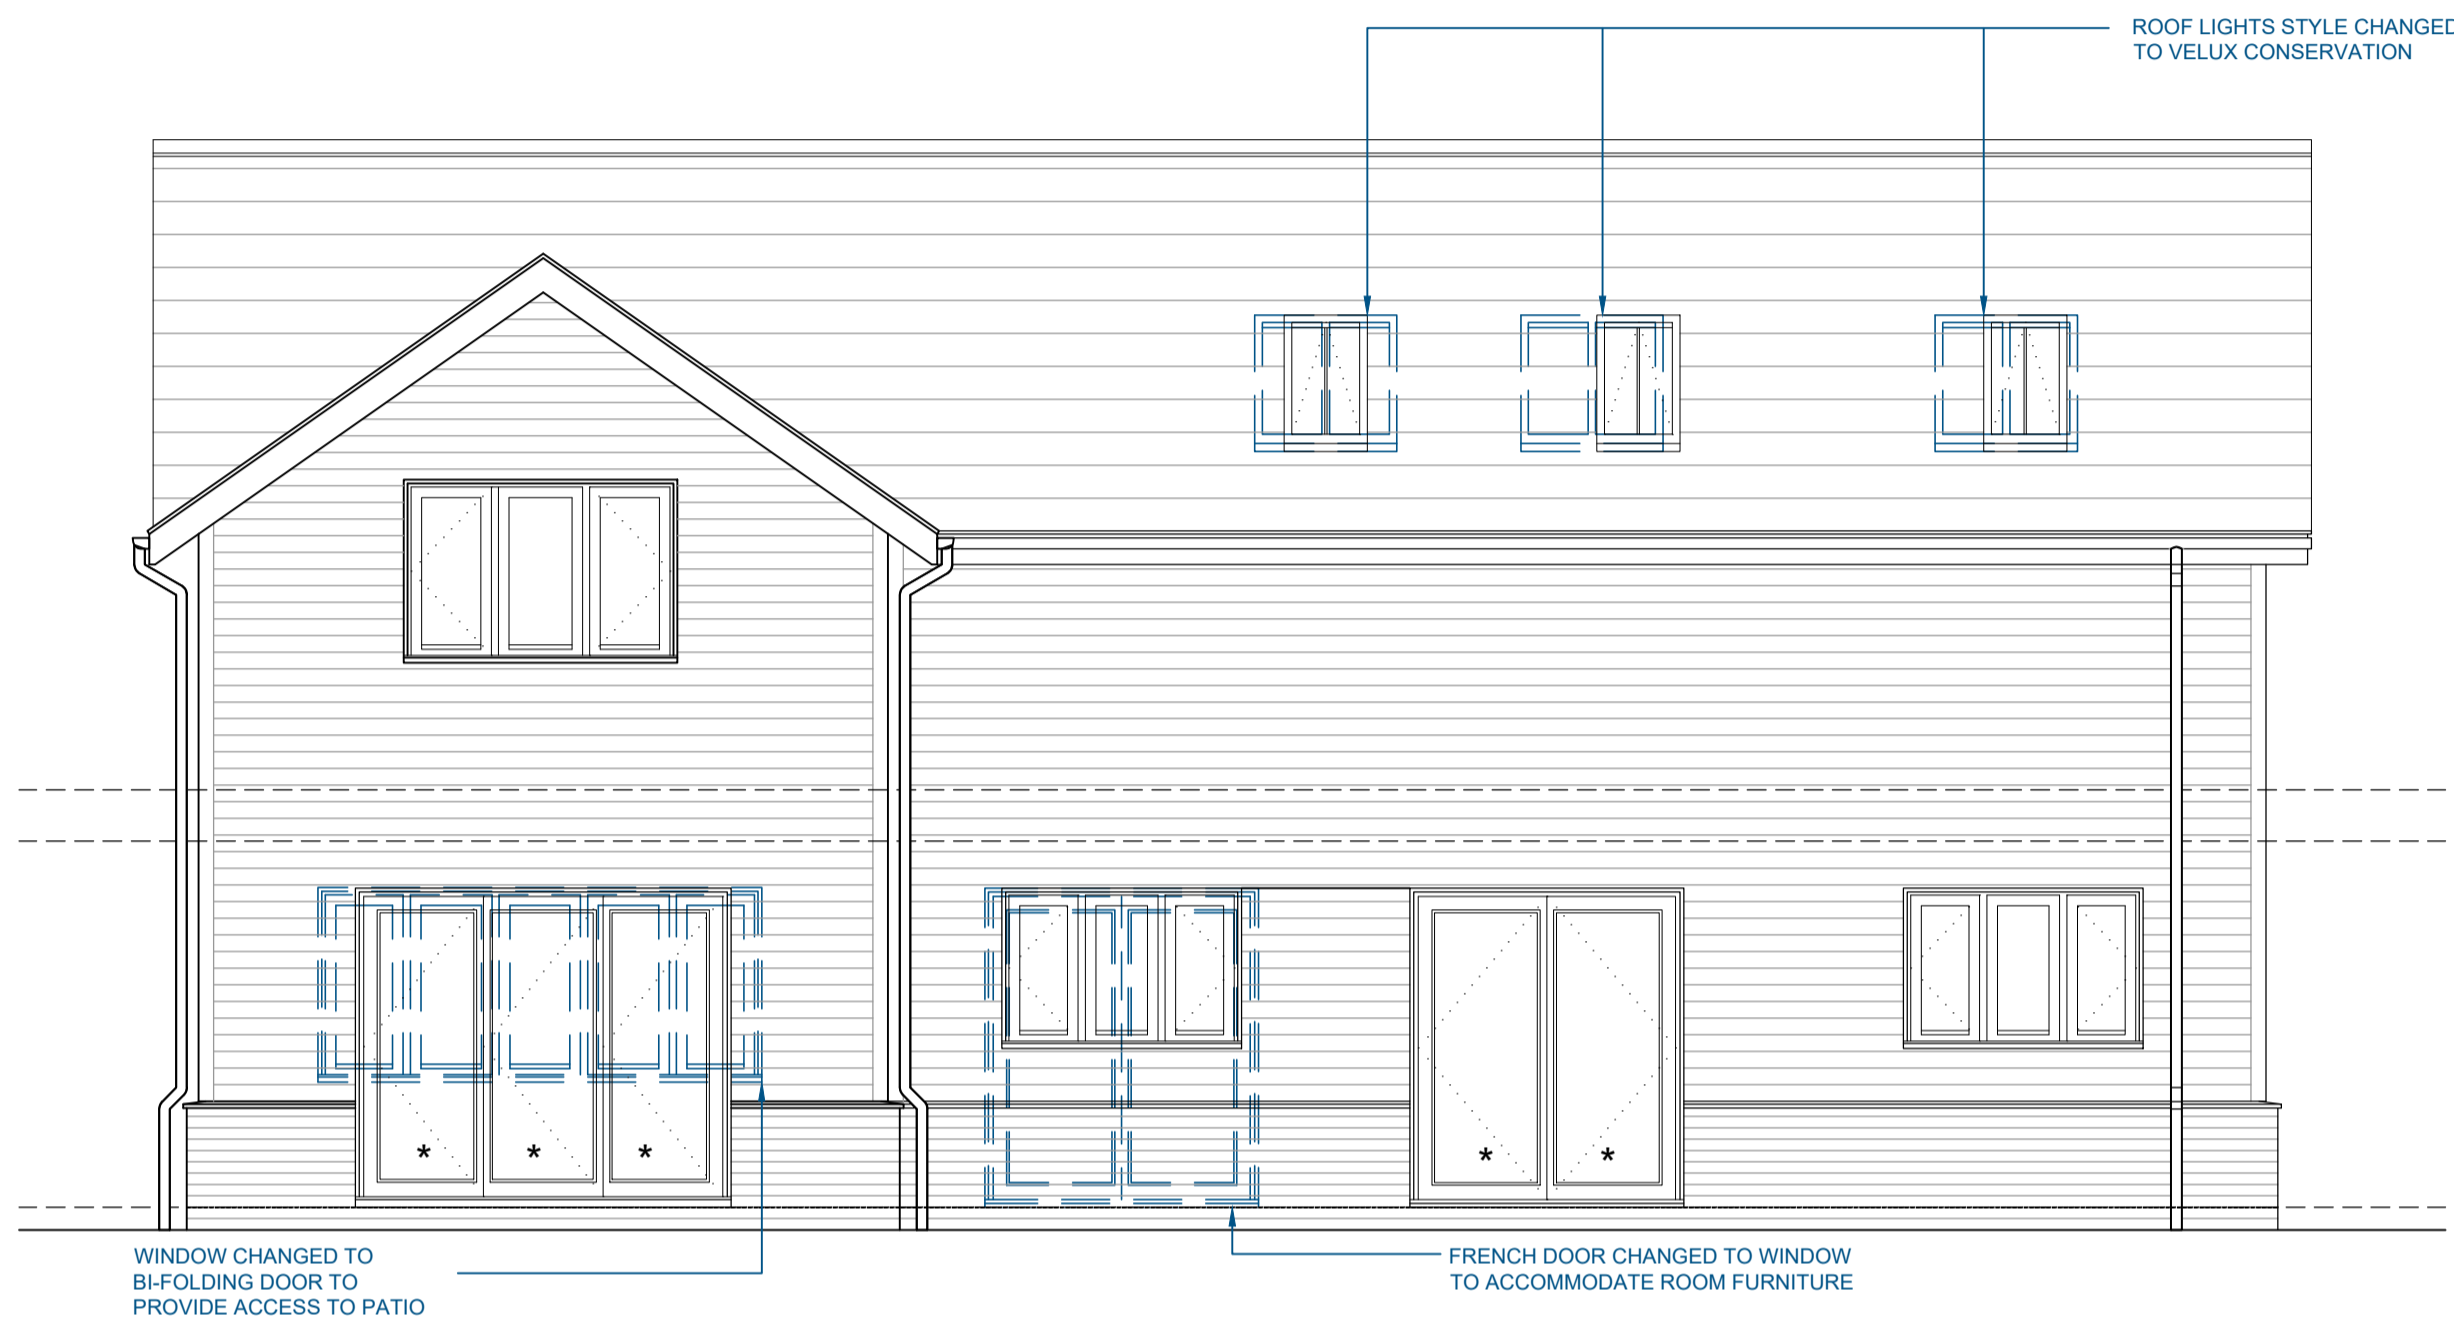


SU1 SETTLEMENT UNIT 1
 GIA: 195 sqm, 2097 sq ft
 AS: 21.22
 OPP:


NOTES

This drawing to be read in accordance with the specification/Bills of Materials and related drawings.

No Dimensions to be scaled from this drawing. All stated dimensions to be verified on site and the Architect notified of any discrepancies.

REAR ELEVATION

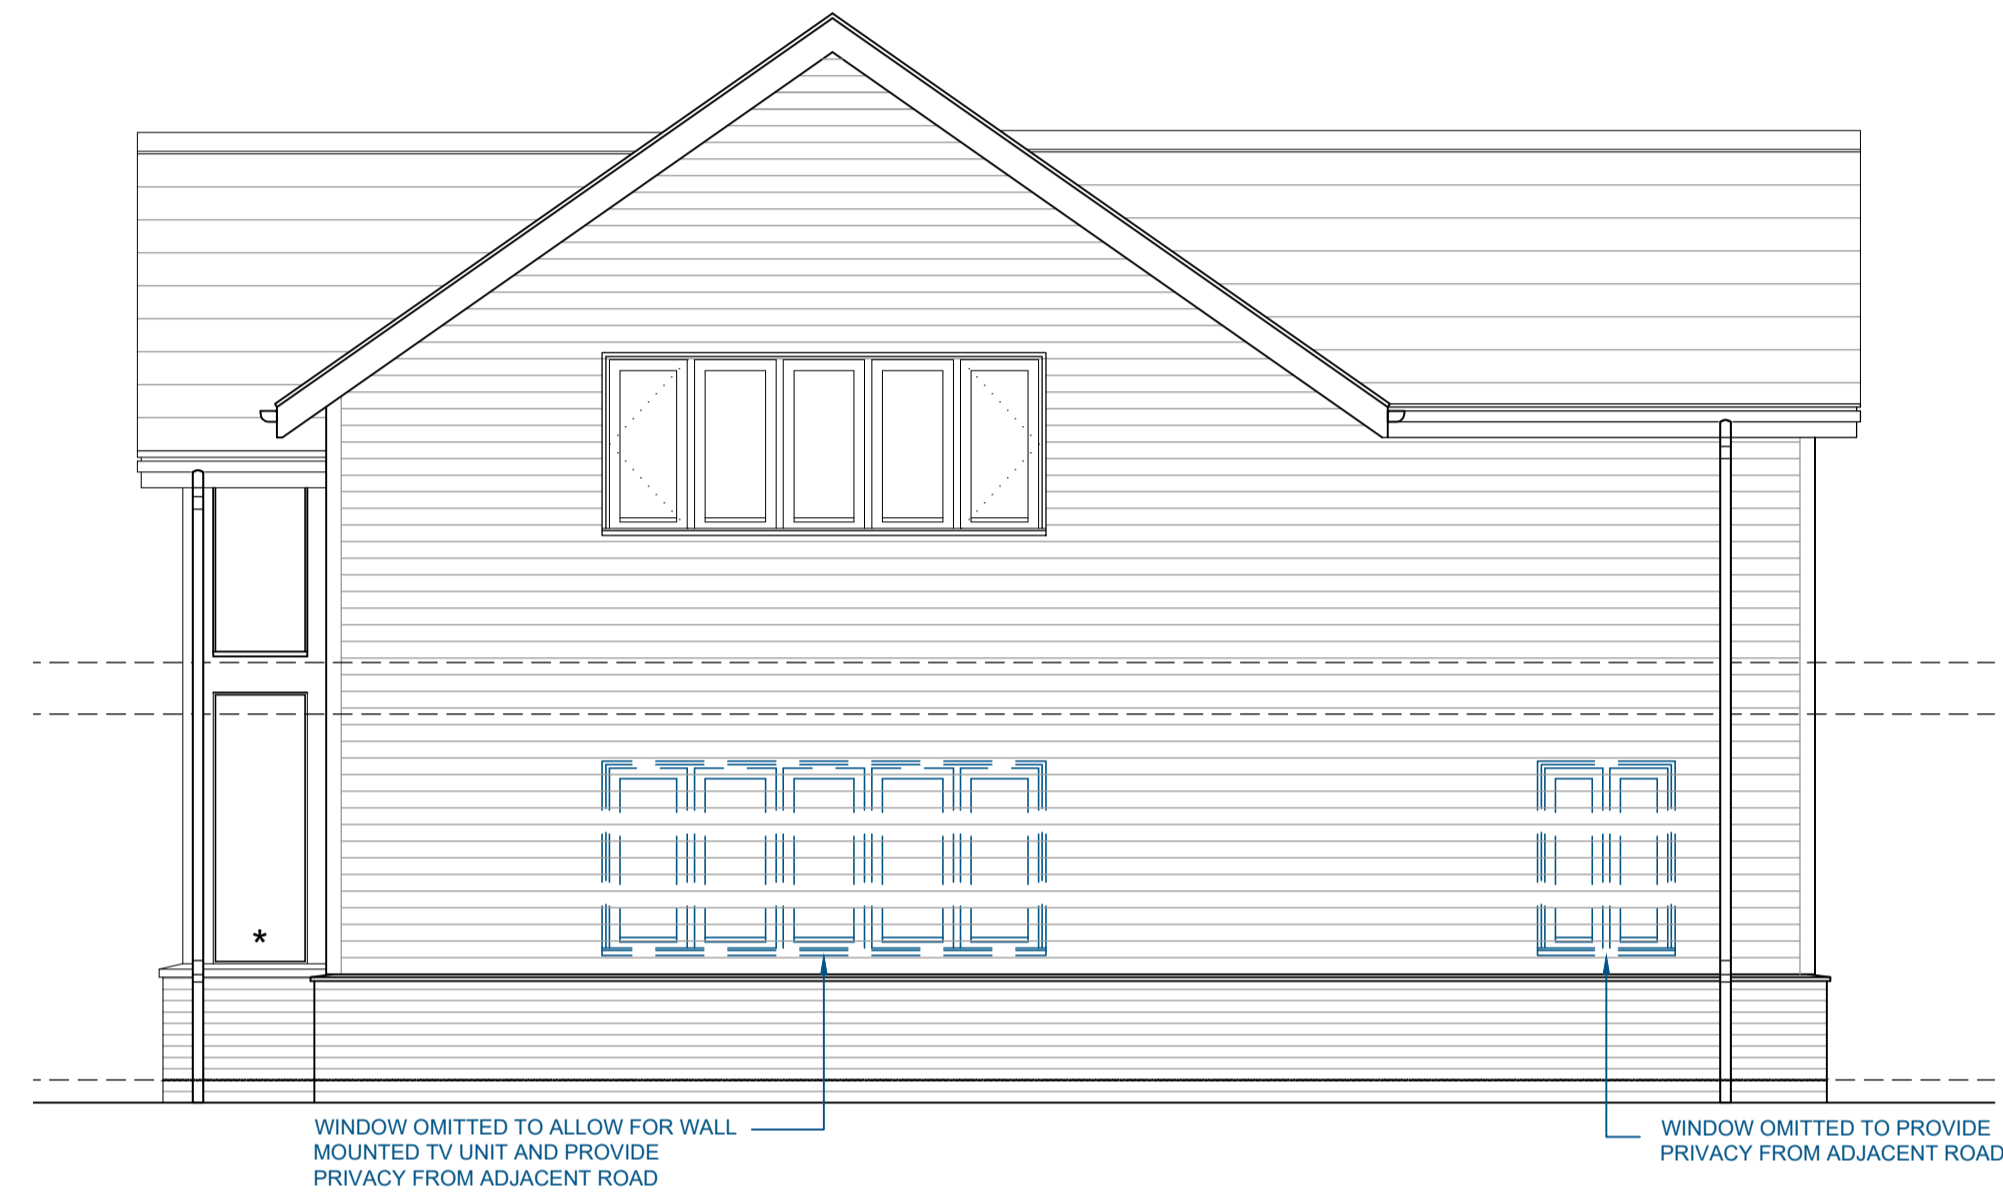

SIDE ELEVATION



FRONT ELEVATION



SIDE ELEVATION

P2 NMA AMENDMENTS TO CLIENT'S MARKUP SENT 02/06/21 08/06/21 JP
 P1 Planning Issue 07/01/21 BW

PLANNING

Project
 NORTHAW HOUSE
 COOPERS LANE
 NORTHAW

Title
 SETTLEMENT UNIT 1
 PLOT 21 ELEVATIONS

Scale	A1	Date	07/01/2021
1:50	A3		
Drawn		Checked	DR
BW			
Drawing Number	Revision		
8250-SAU-SU1-1010-DR-A	P2		

Saunders
 Architecture+UrbanDesign