


SU2 SETTLEMENT UNIT 2
 GIA: 208 sqm, 2236 sq ft
 AS: 25
 OPP:

NOTES


This drawing to be read in accordance with the specification/Bills of Quantities and related drawings.

No Dimensions to be scaled from this drawing. All stated dimensions to be verified on site and the Architect notified of any discrepancies.


Scale bar 100mm at 1:1

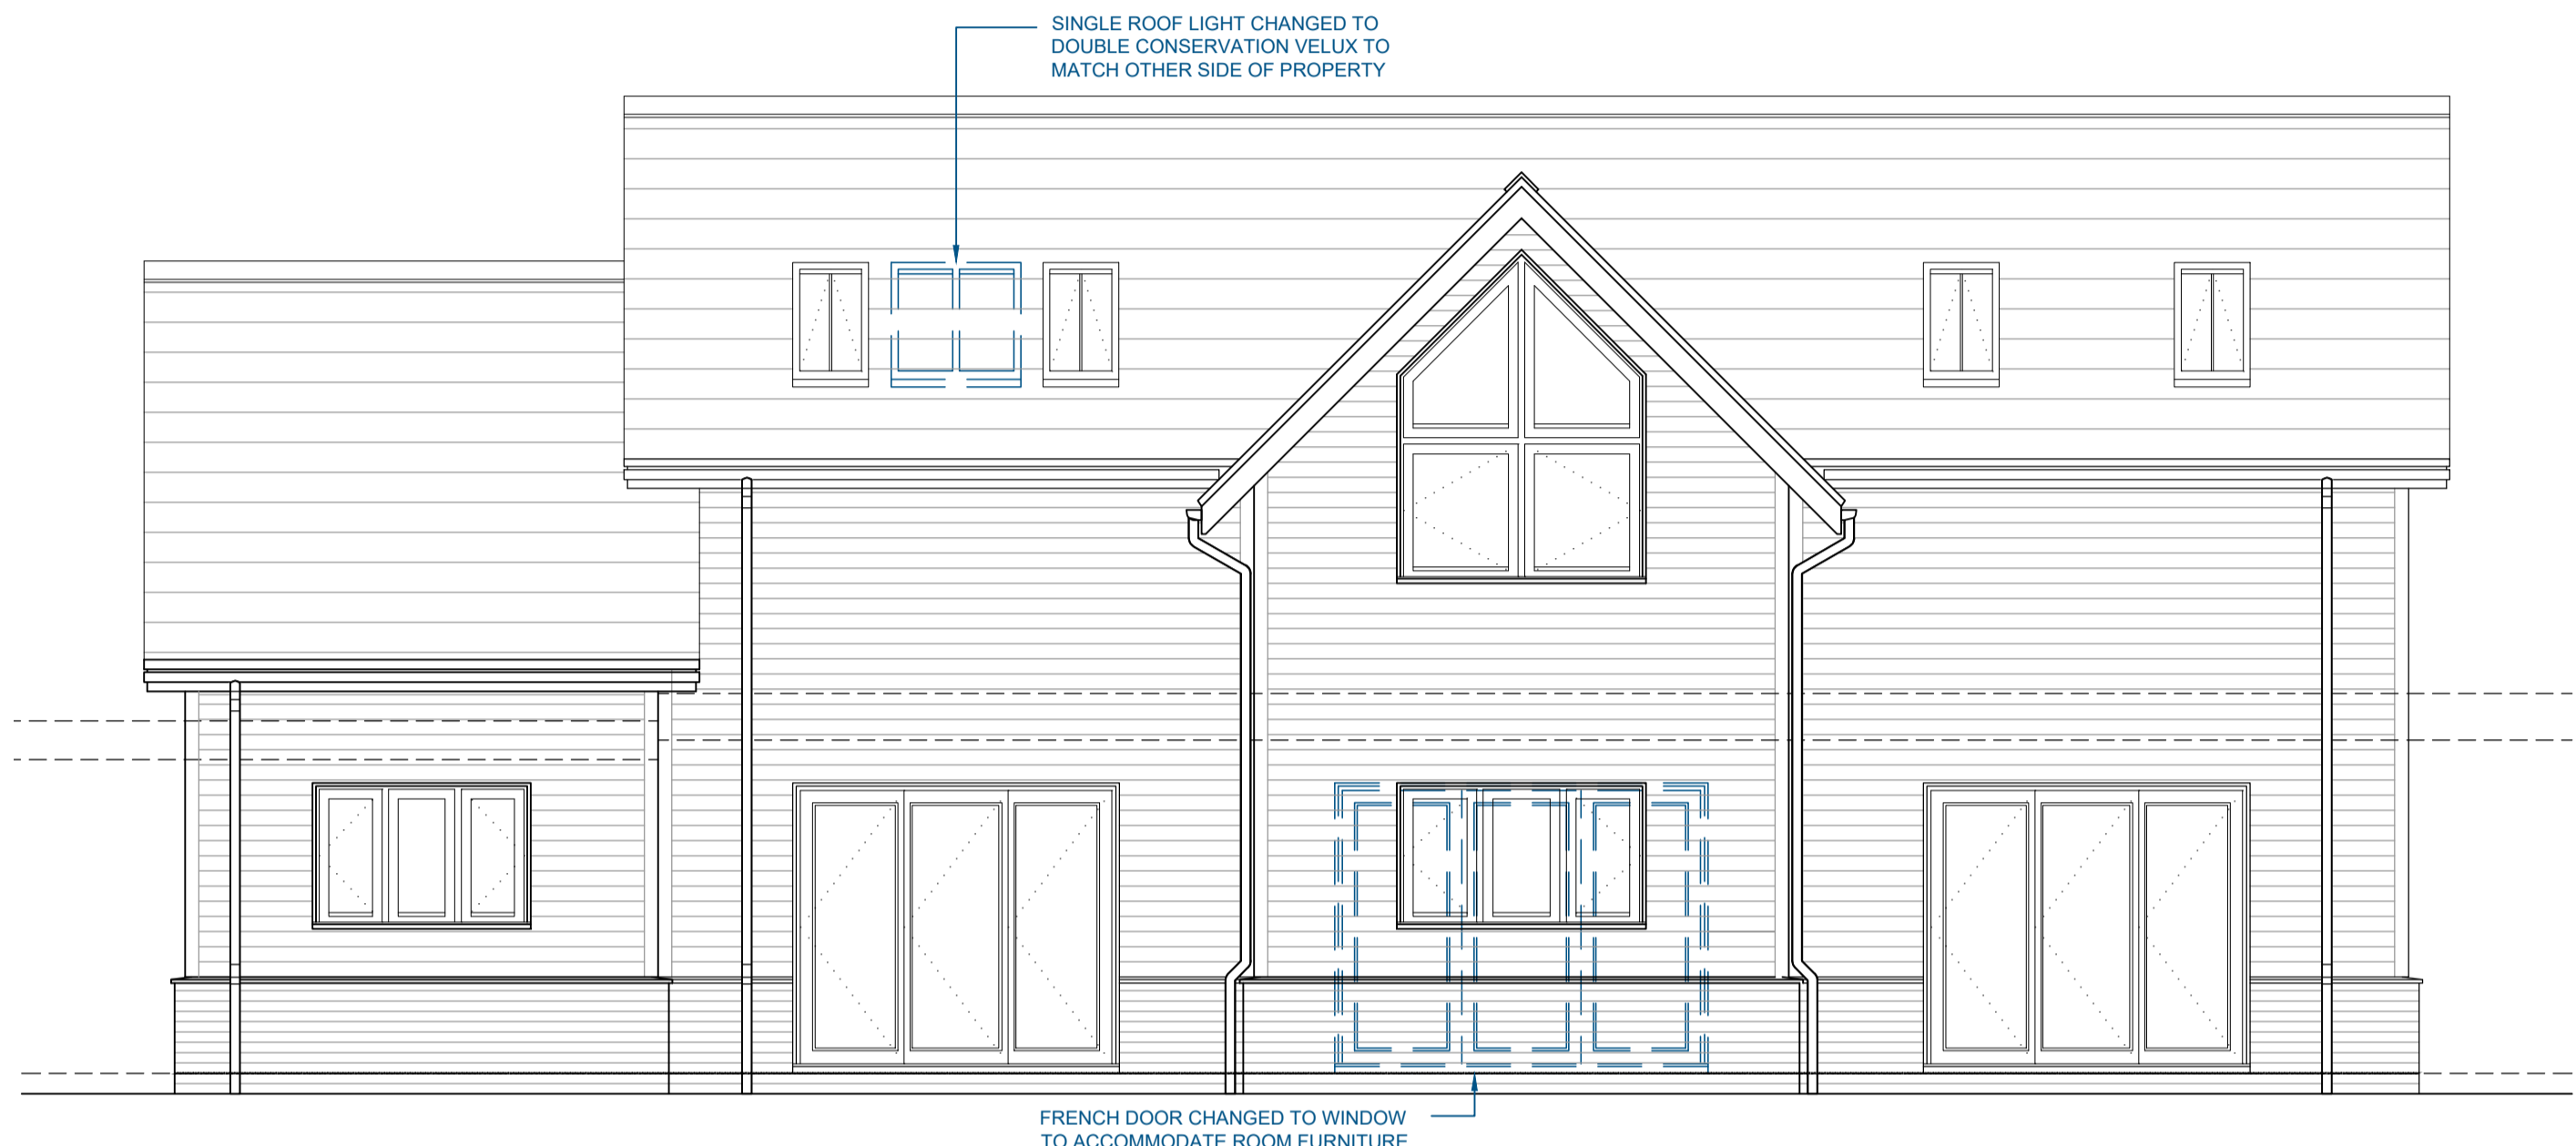

REAR ELEVATION

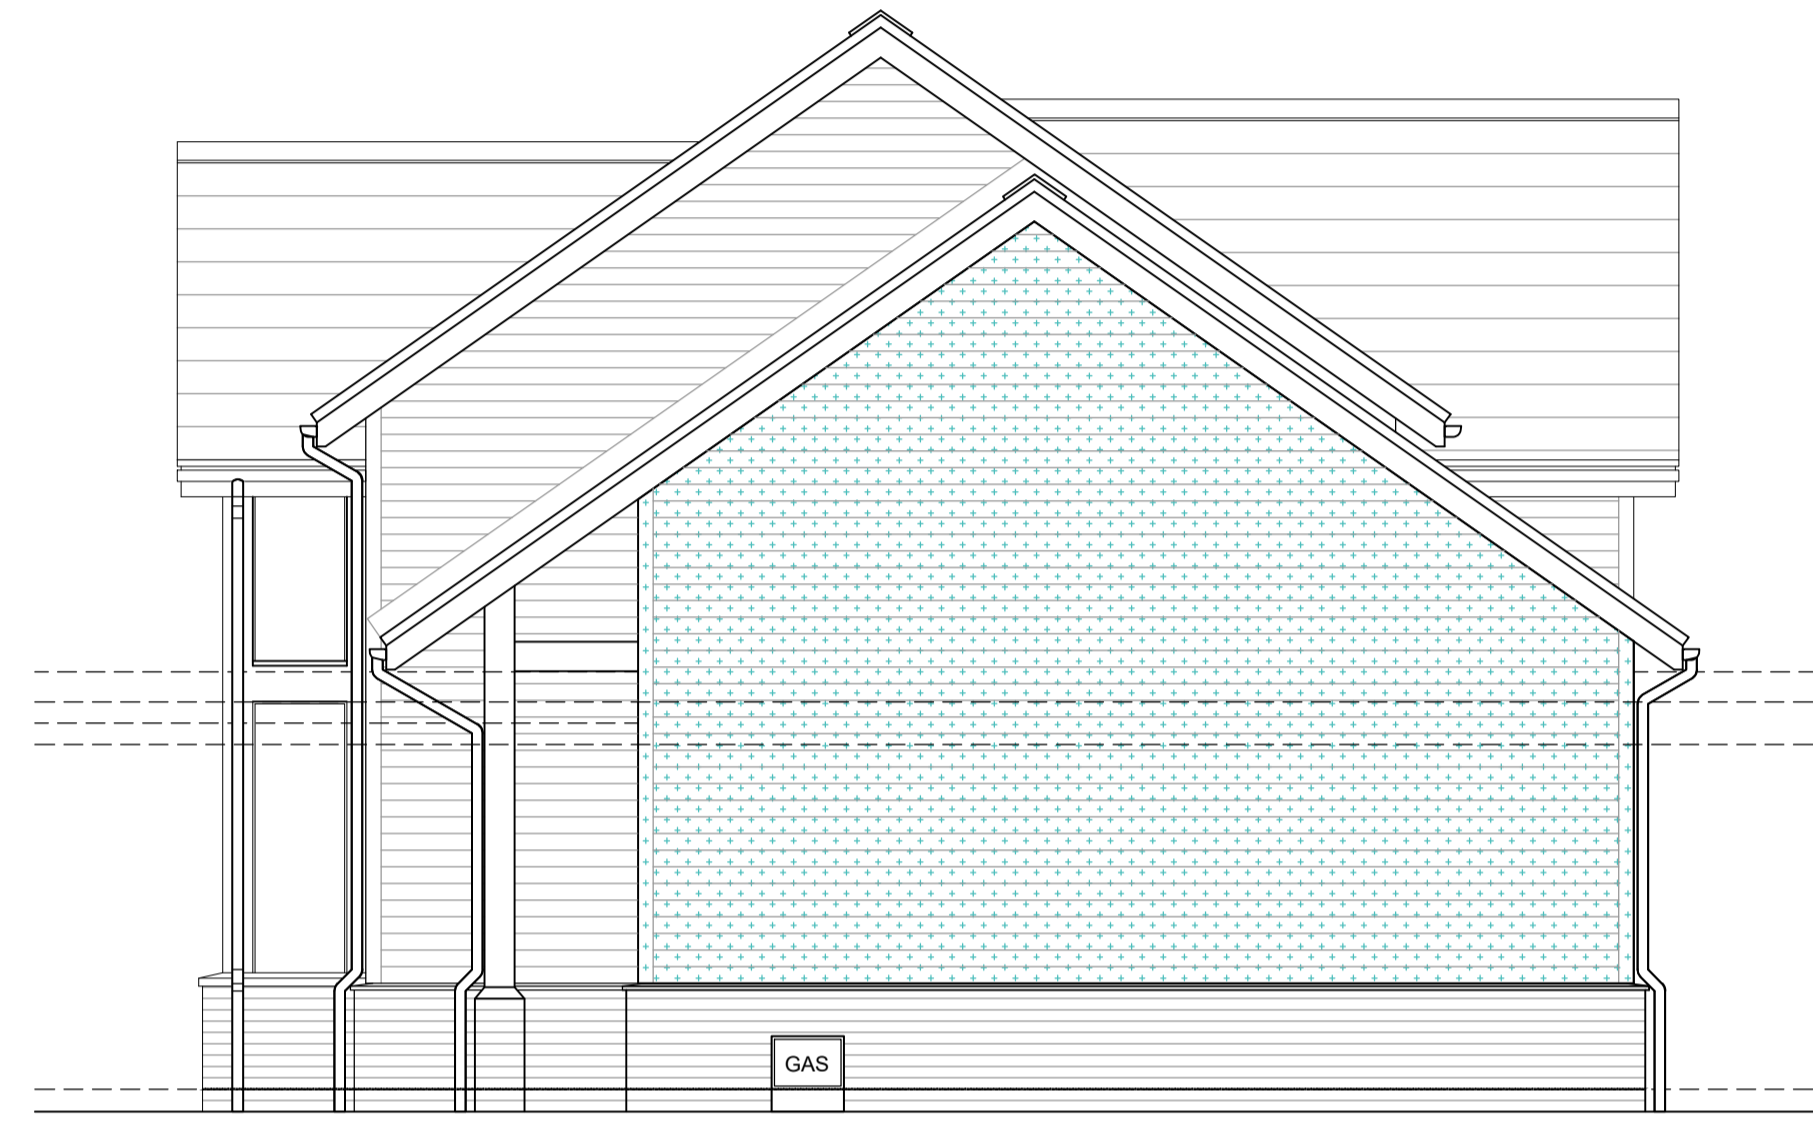

SIDE ELEVATION

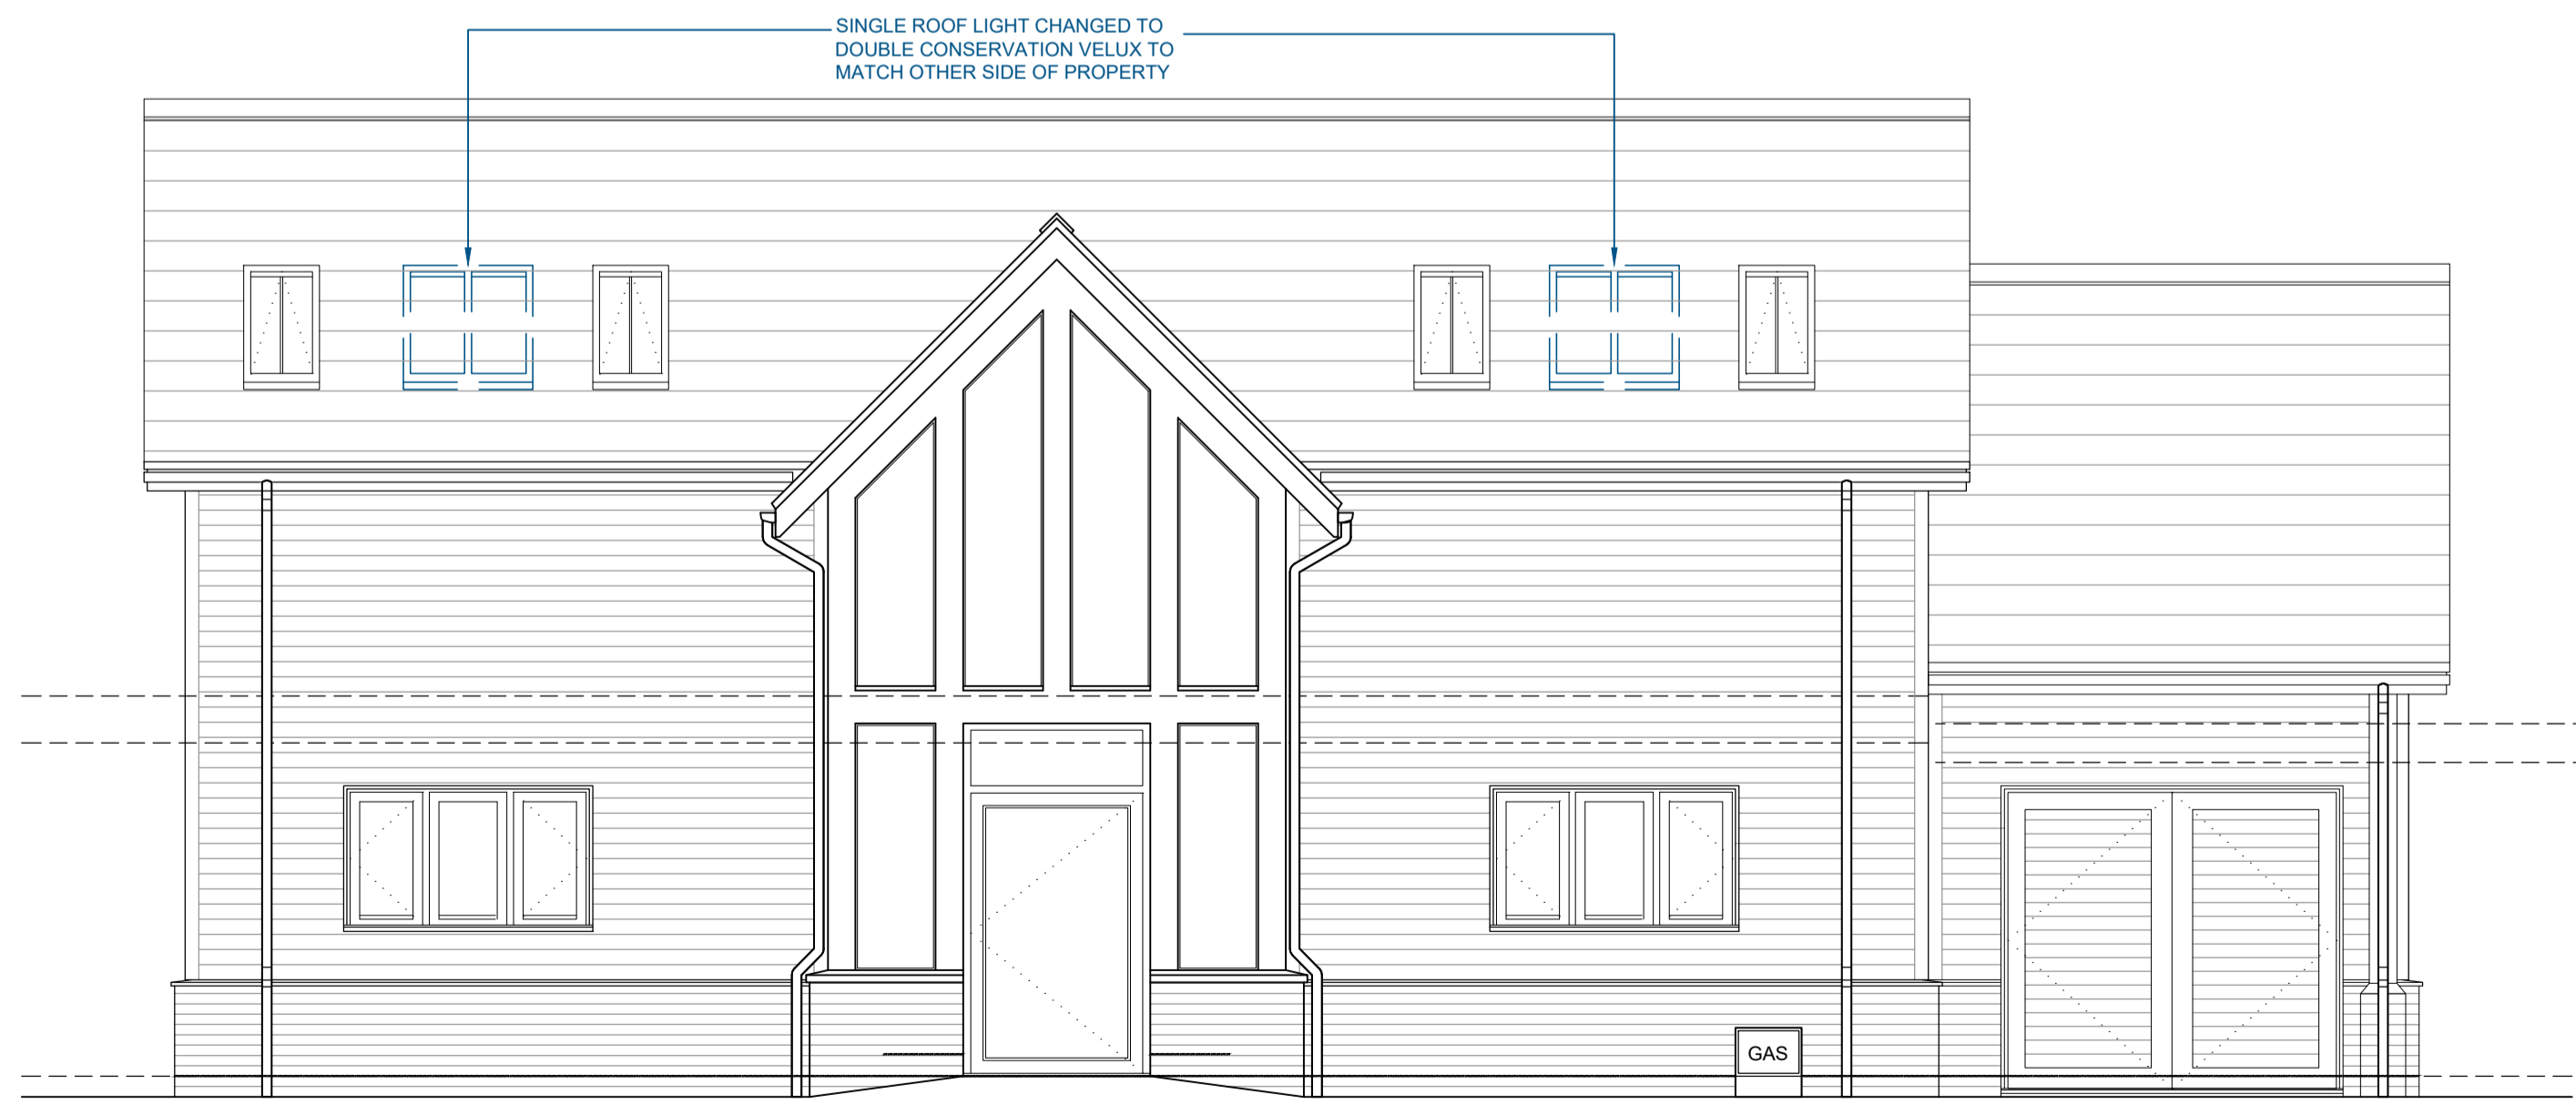

FRONT ELEVATION



SIDE ELEVATION

P2 NMA AMENDMENTS TO CLIENT'S MARKUP SENT 02/06/21 08/06/21 JP
 P1 Planning Issue 18/12/20 BW

PLANNING

Project
 NORTHAW HOUSE
 COOPERS LANE
 NORTHAW

Title
 SETTLEMENT UNIT 2
 PLOT 25 PROPOSED ELEVATIONS

Scale	A1	Date	18/12/2020
1:50	A3		
Drawn		Checked	DR
BW			
Drawing Number	Revision		
8250-SAU-SU2-0011-DR-A	P2		

Saunders
 Architecture+UrbanDesign