




The Excitement is Building

Chase new Homes  
16-18 Howard Business park  
Howard Close  
Waltham Abbey  
Essex  
EN9 1XE

Tel: 01992 766658  
fax: 01992 715406

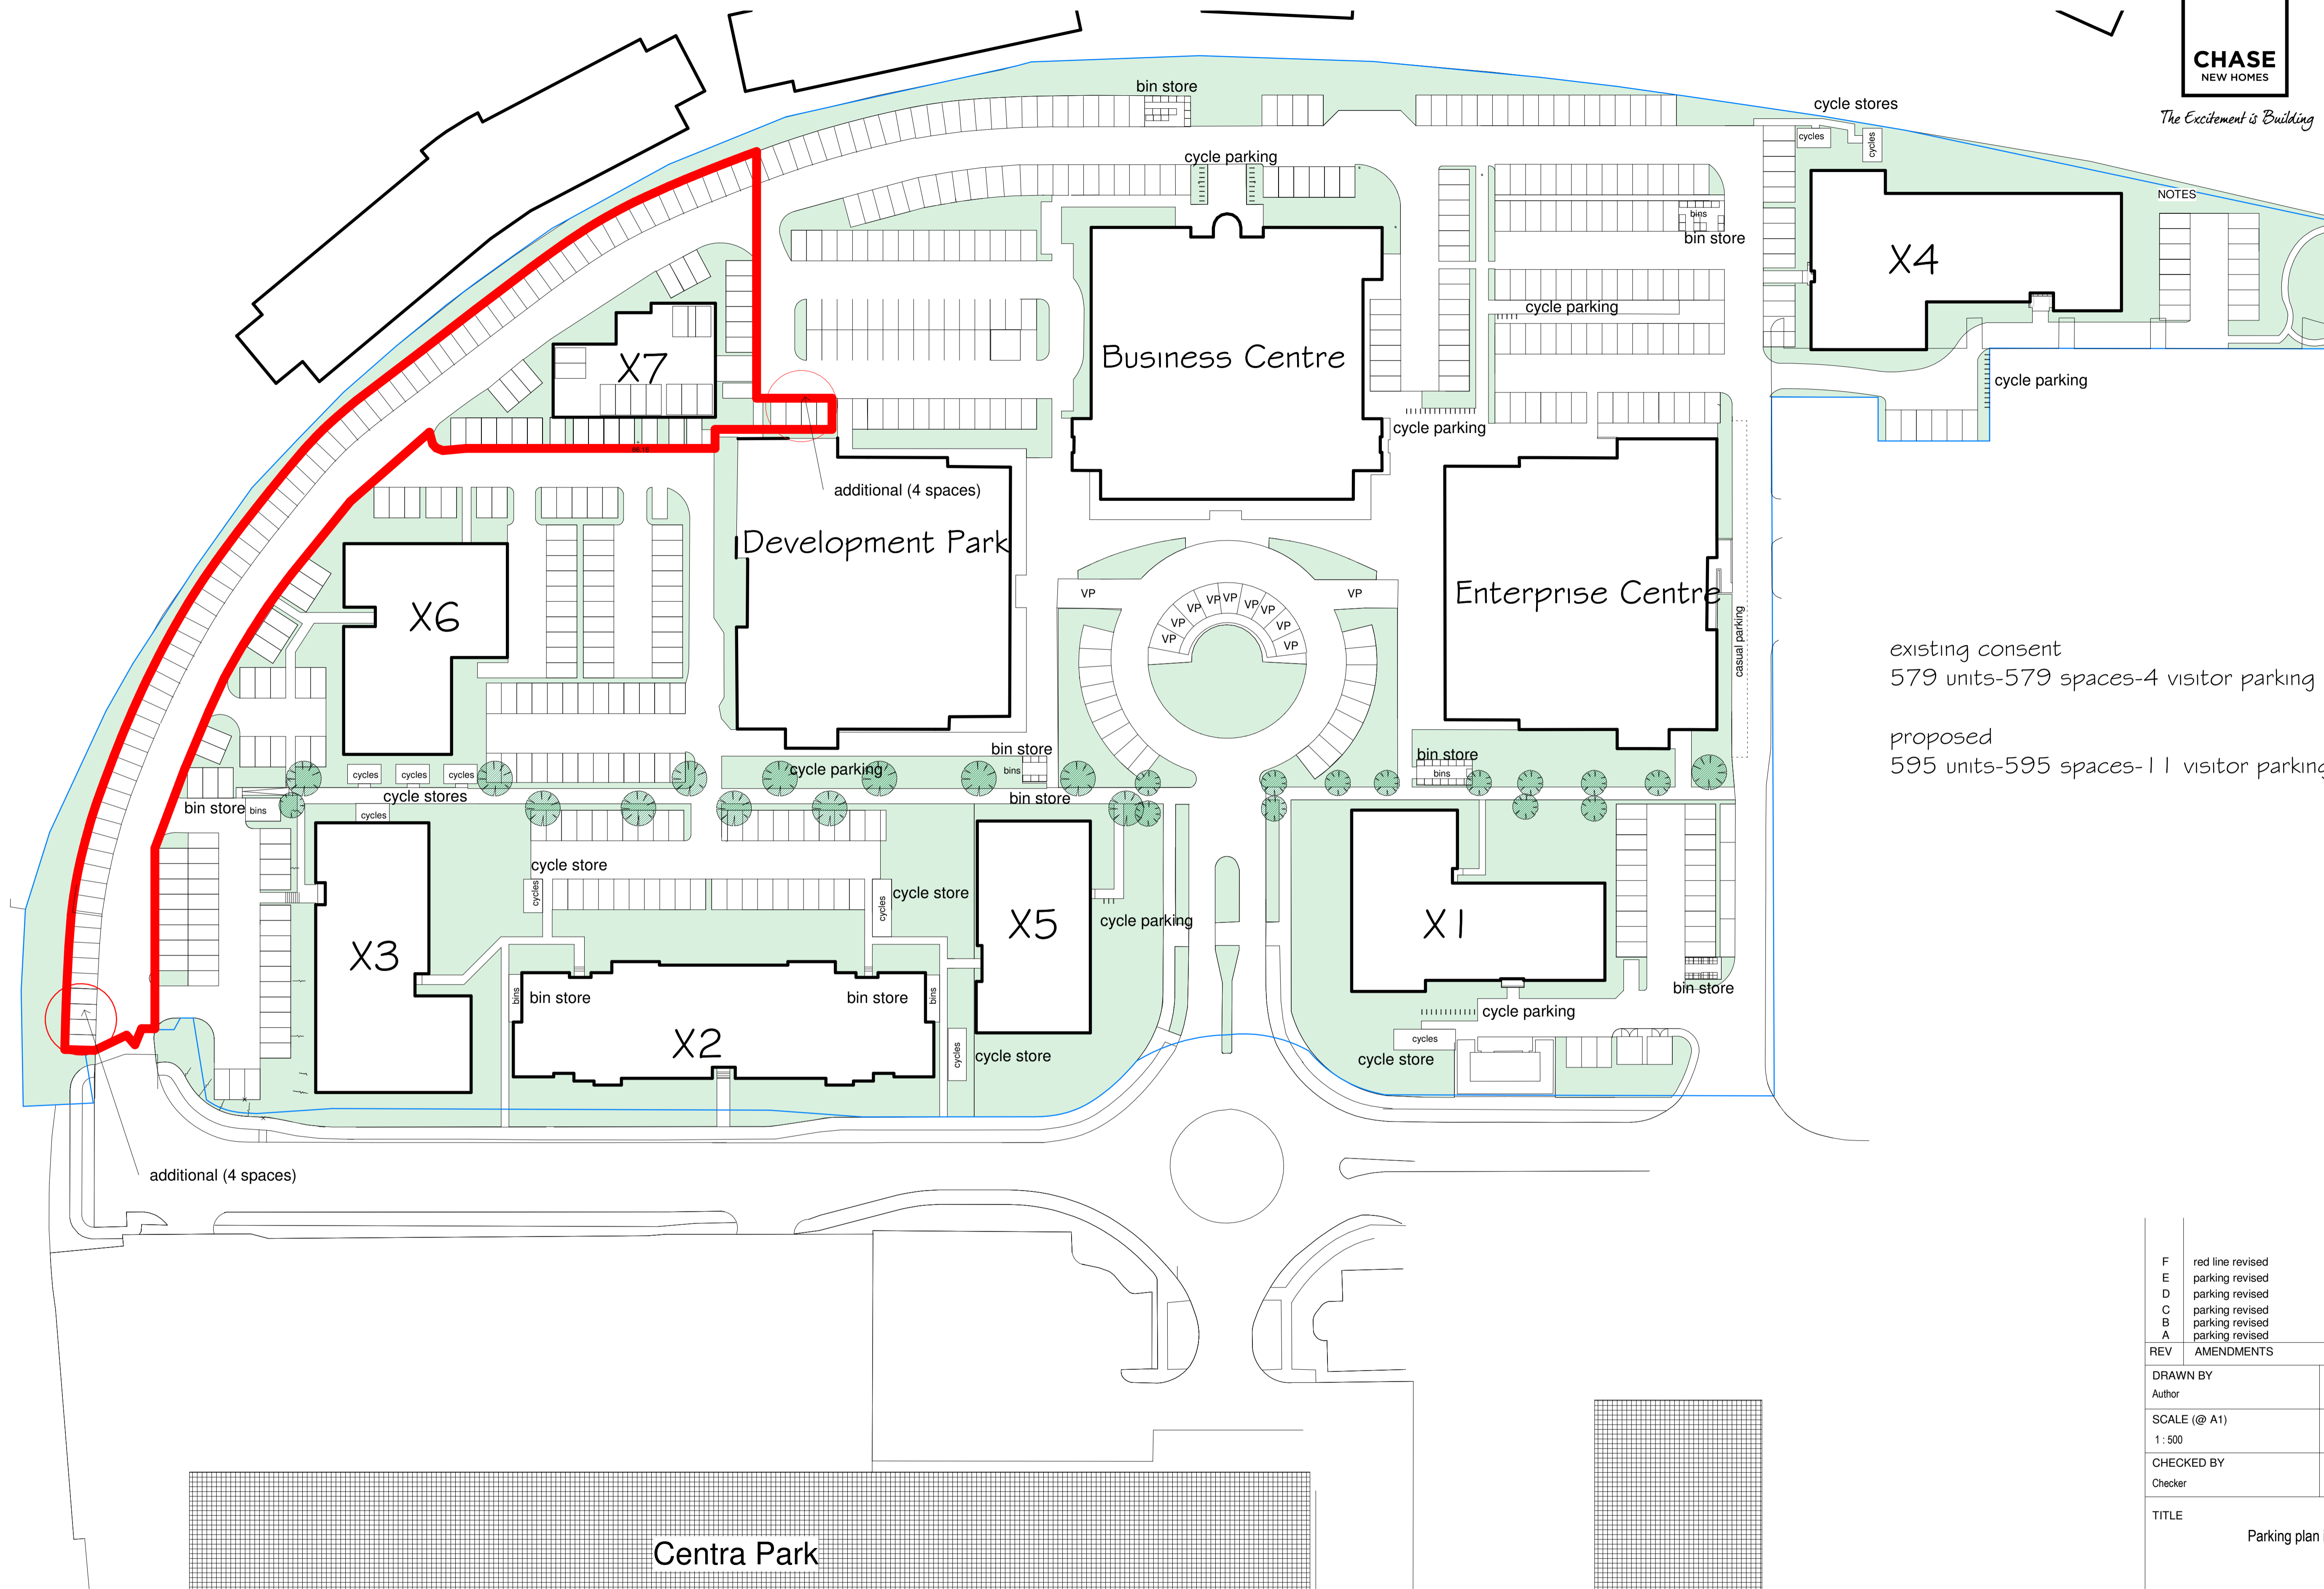

existing consent  
579 units-579 spaces-4 visitor parking spaces

proposed  
595 units-595 spaces-11 visitor parking spaces

F	red line revised	09/11/2018
E	parking revised	25/10/2018
D	parking revised	19/10/2018
C	parking revised	05/09/2018
B	parking revised	04/09/2018
A	parking revised	04/09/2018
REV	AMENDMENTS	DATE
DRAWN BY Author		DATE 12/19/17
SCALE (@ A1) 1 : 500		PROJECT NUMBER CNH 002
CHECKED BY Checker		APPROVED
TITLE Parking plan including X7		
PROJECT Xerox, Welwyn Garden City		
DRAWING NUMBER 16 002-905 F		

Site parking layout including X7  
1 : 500