

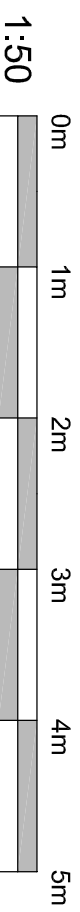


UNIT 12 GA PLAN - 1:50

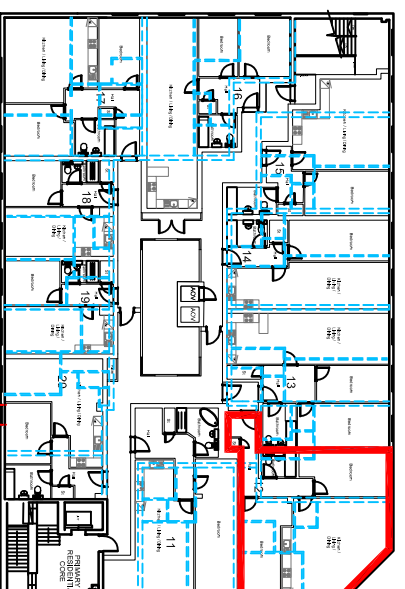

Existing Flat Walls shown in blue dashed line
Proposed Unit Boundary shown in red line

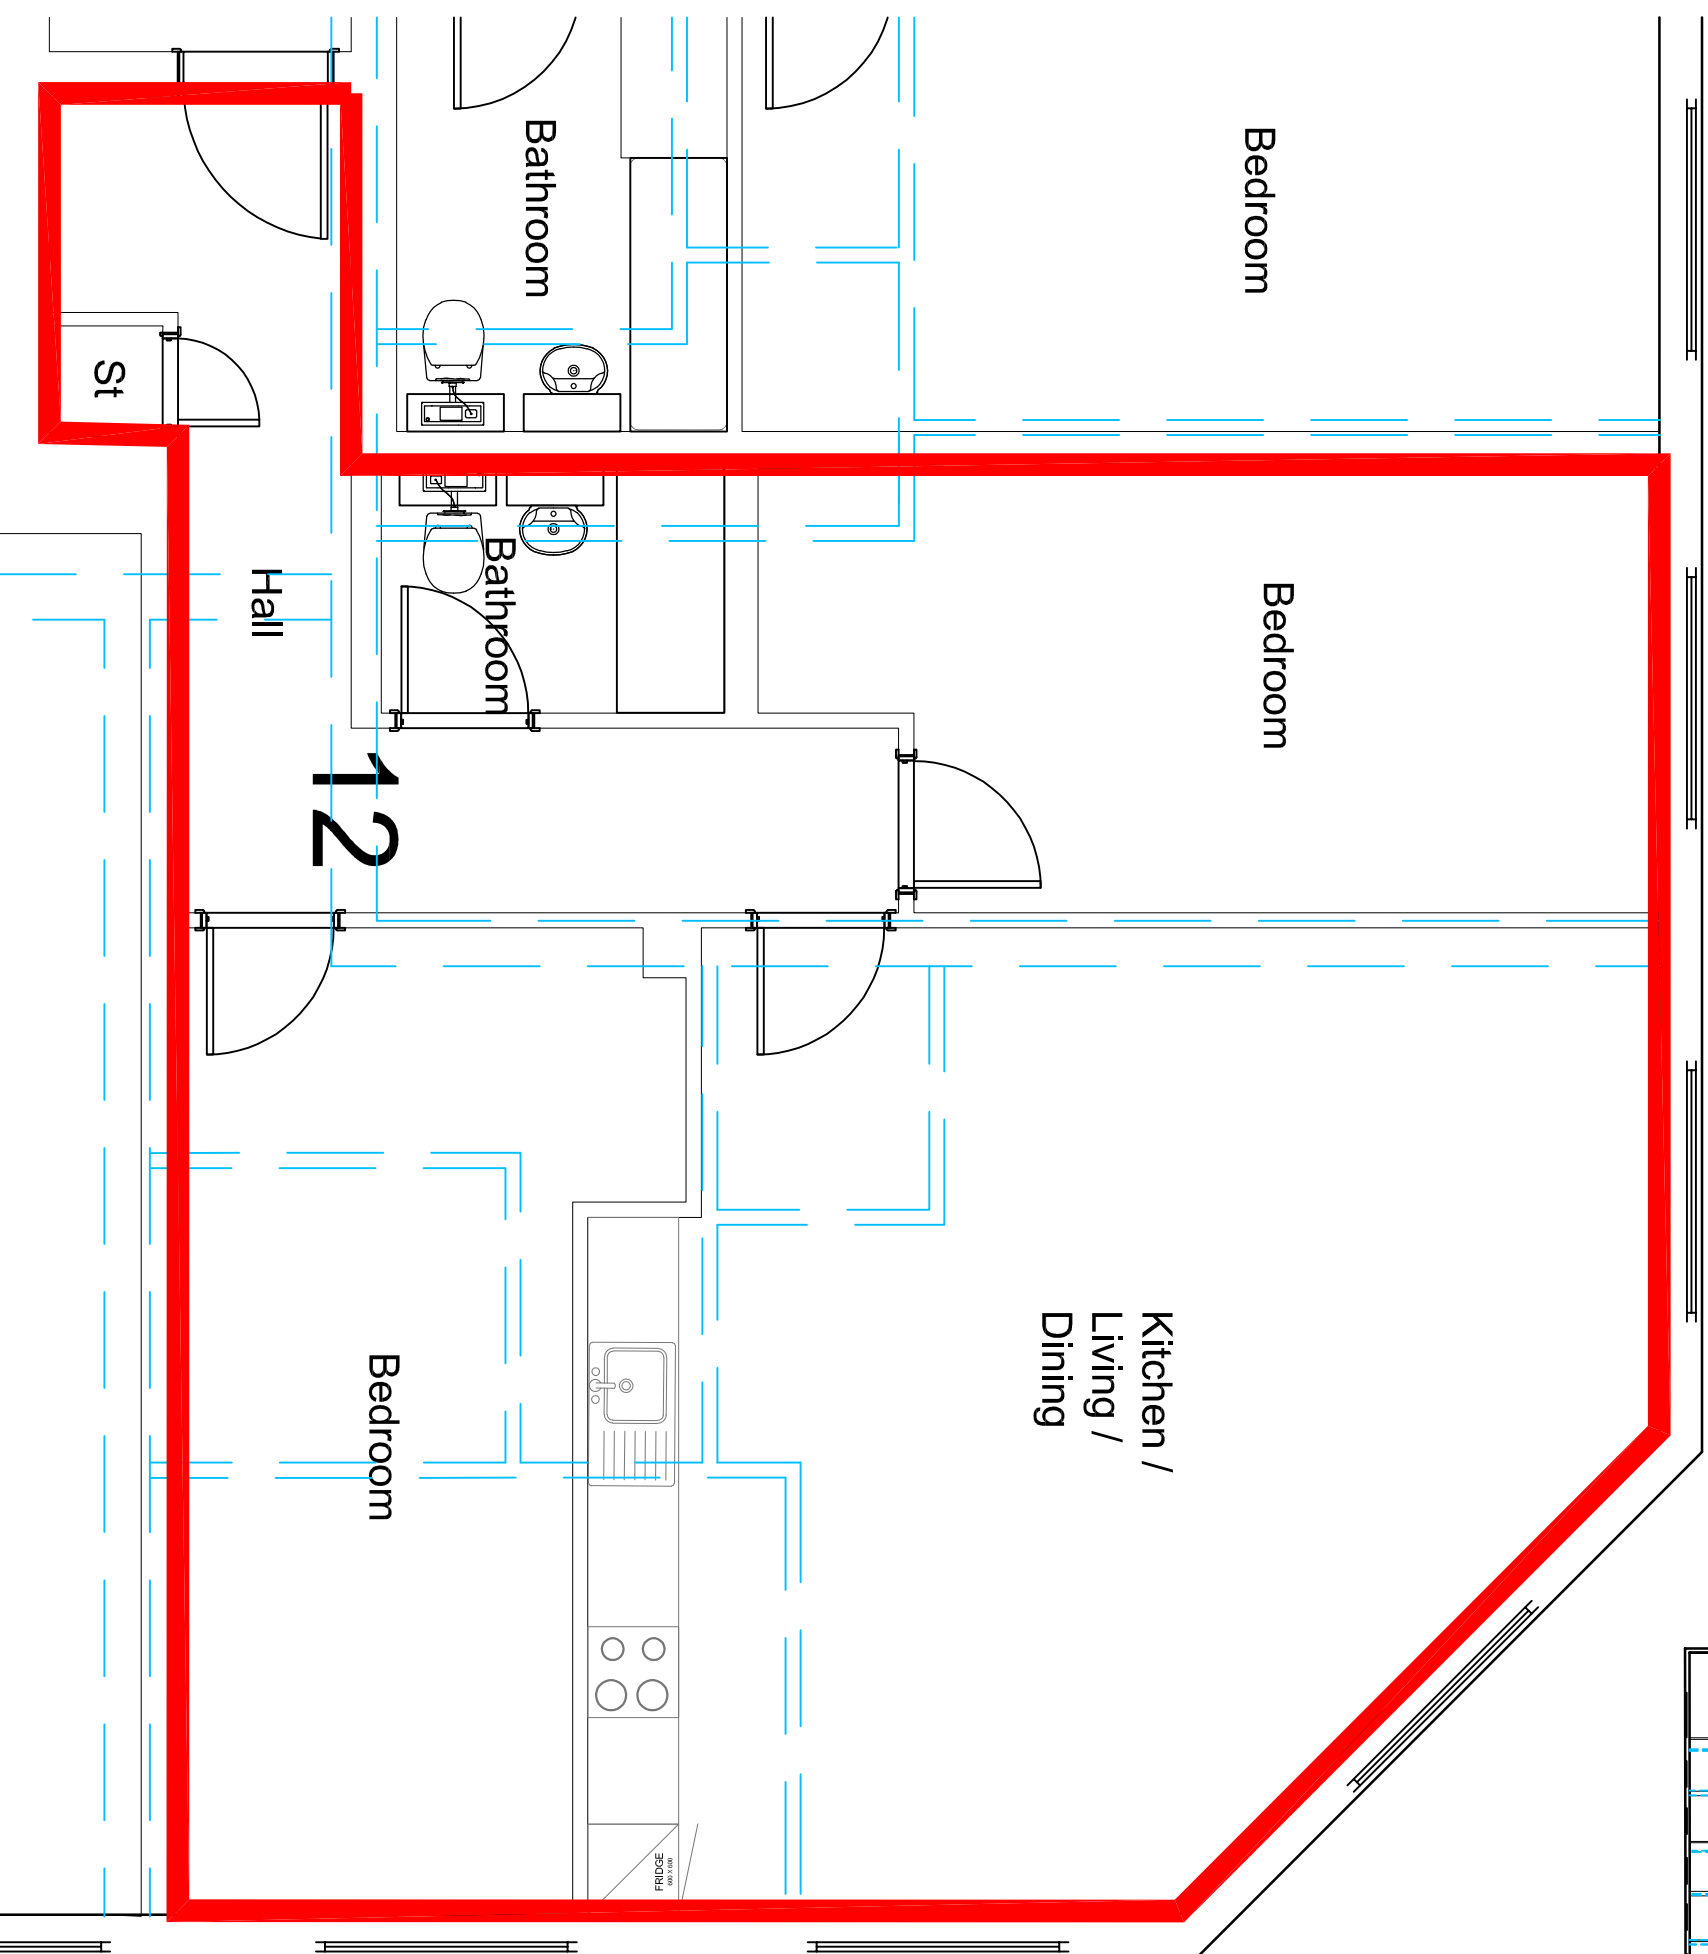

Notes:

do not scale
detailed drawings and larger scale drawings take precedence. Figured
dimensions only are to be taken from this drawing.

Revisions:

client:
Genesis Developments

project:
26 Stonehills
Welwyn City Gardens

description:
Second Floor Flat Plans
Unit 12
Proposed plans With Existing layover

head office:
the old stone masons, 10 st Johns st,
aberystwyth, ceredigion, north wales, np23 5rt
tel: 01873 851125 fax: 01873 851127

newport:
first floor, 5 gold tops,
newport, south wales, np20 4pg
tel: 01633 245020

e-mail: info@jdwarchitects.co.uk
w: www.jdwarchitects.co.uk



architects ltd

drawn: scale: 1:50 @A3
date: Feb 21 sheet OF
job drwg. no: JW984 - 441 rev:

this drawing is copyright of the architect and may not be reproduced without license