

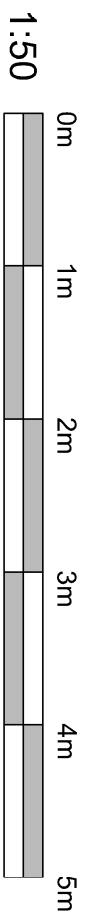


UNIT 23 GA PLAN - 1:50

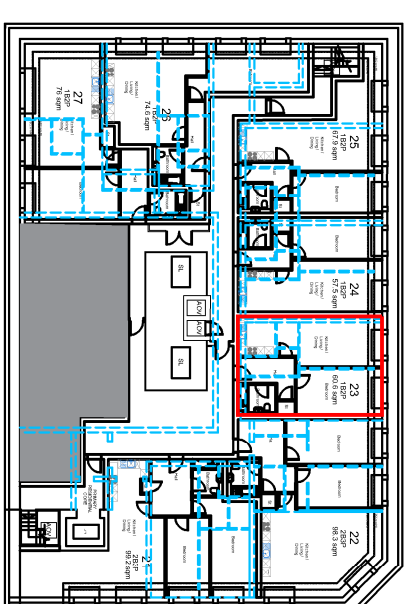

Existing Flat Walls shown in blue dashed line
Proposed Unit Boundary shown in red line

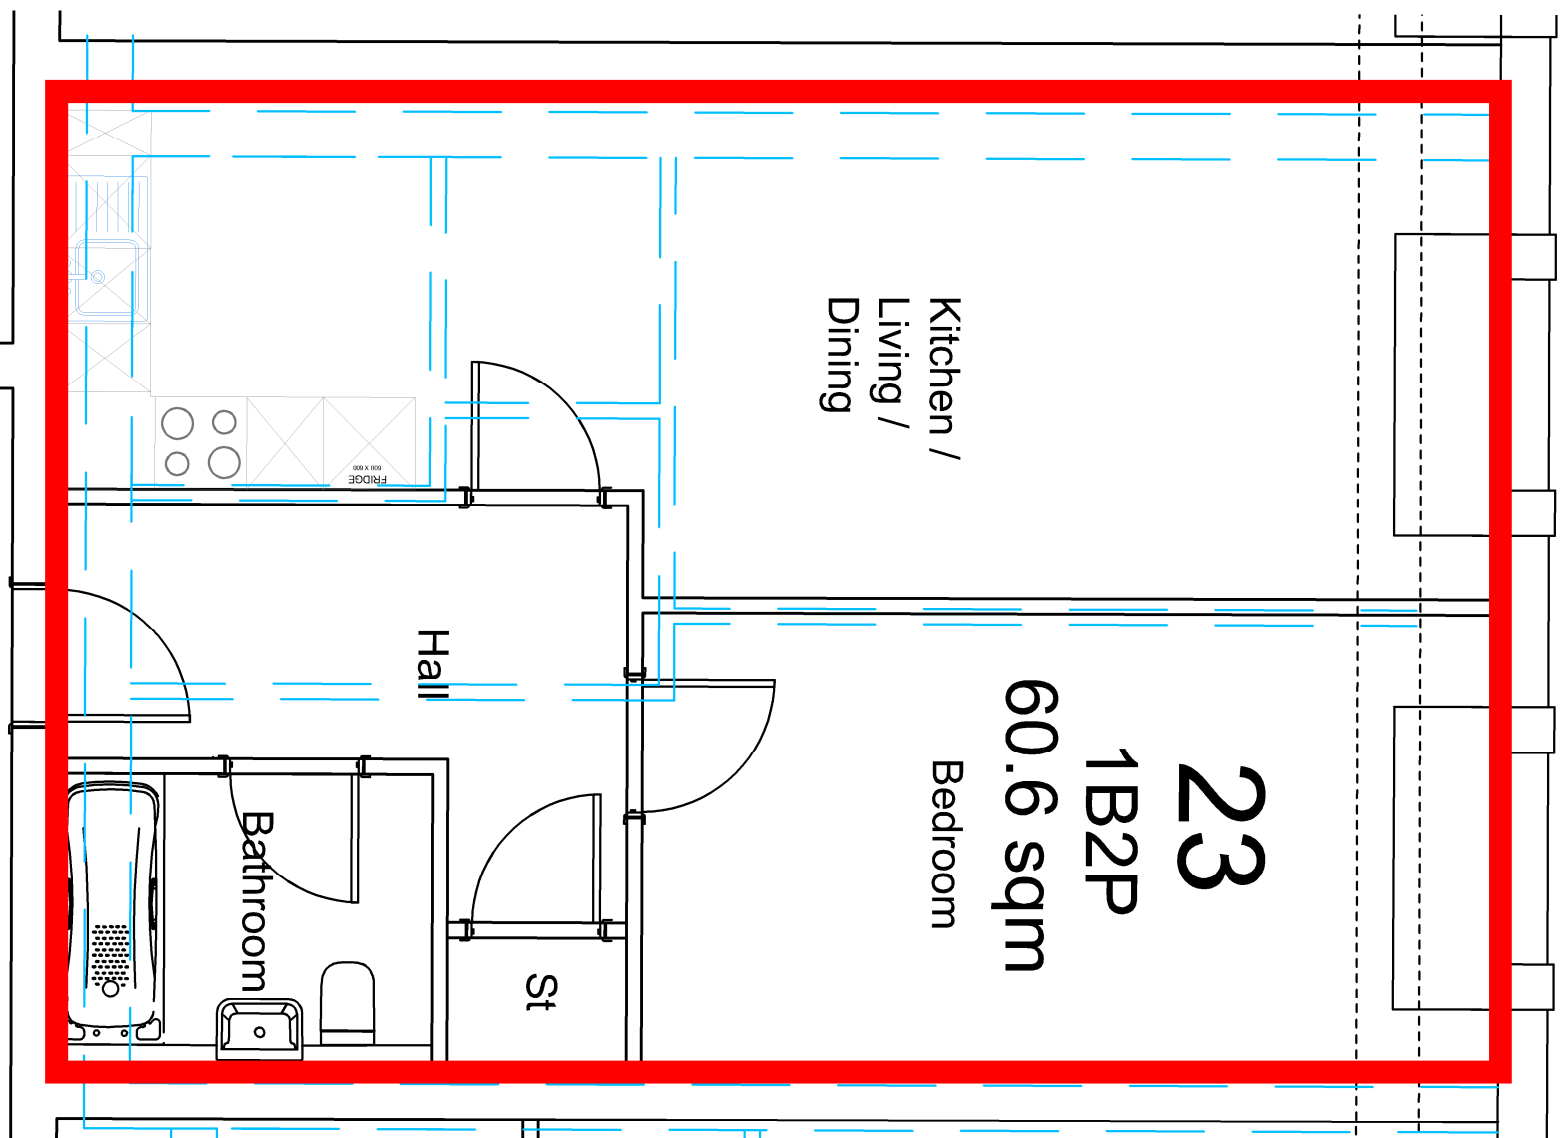

NOTES:

do not scale
detailed drawings and larger scale drawings take precedence. Figured
dimensions only are to be taken from the drawing.

REVISIONS:

client: Genesis Developments

project: 26 Stonehills
Welwyn City Gardens

description: Third Floor Flat Plans
Unit 23
Proposed plans With Existing layover



head office:
the old stone masons, 10 st Johns st,
aberqweany, mormonulshipe, np7 5fr
tel: 01873 851125 fax: 01873 851127

newport:
first floor, 5 gold tass,
newport, south wales, np20 4pg
tel: 01633 245020

e-mail: info@jdwarchitects.co.uk
w: www.jdwarchitects.co.uk

drawn: 1:50
date: Feb 21
job dwg. no: JW984 - 452

sheet of: SHEET OF
@A3