


SCALE: 1:1250 on A4
CENTRE COORDINATES: 523889 , 213511



LARGE

MATURE ASH TREE
LOCATION

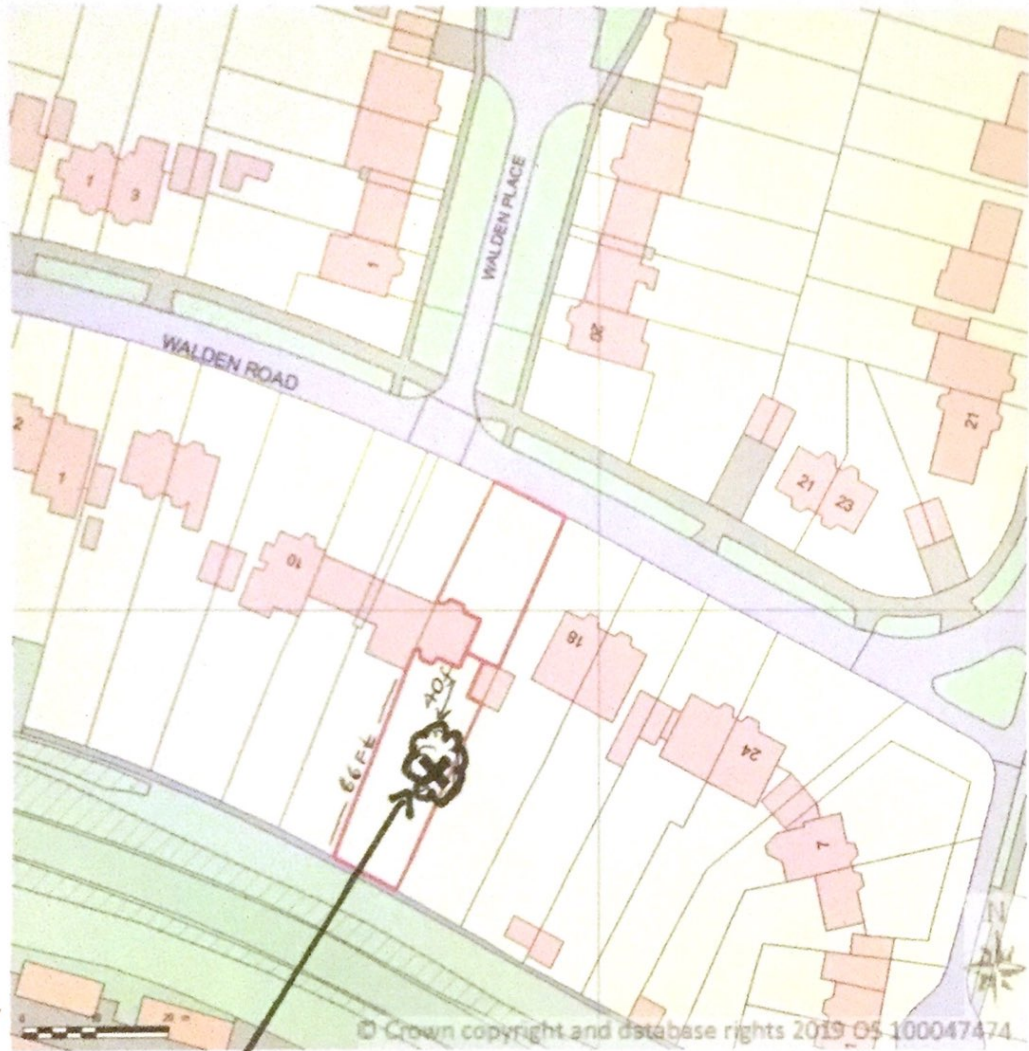

- 16 WALDEN RD
AL8 7PF

Supplied by ~~Streetwise Maps Ltd~~

~~www.streetwise.net~~

~~Licence No: 100047474~~

~~10:57:18 06/08/2019~~

PLOT OUTLINED IN RED.

ASH TREE approx 40ft from house/patio

BACK GARDEN approx 68ft total

ASH TREE is next to no 18 (neighbour) hedge + boundary.