PLANNING REGS.

BROOKMANS PARK TRANSMITTER STATION, S6/200/86

GT NORTH RD, BROOKMANS PARK.

2/2

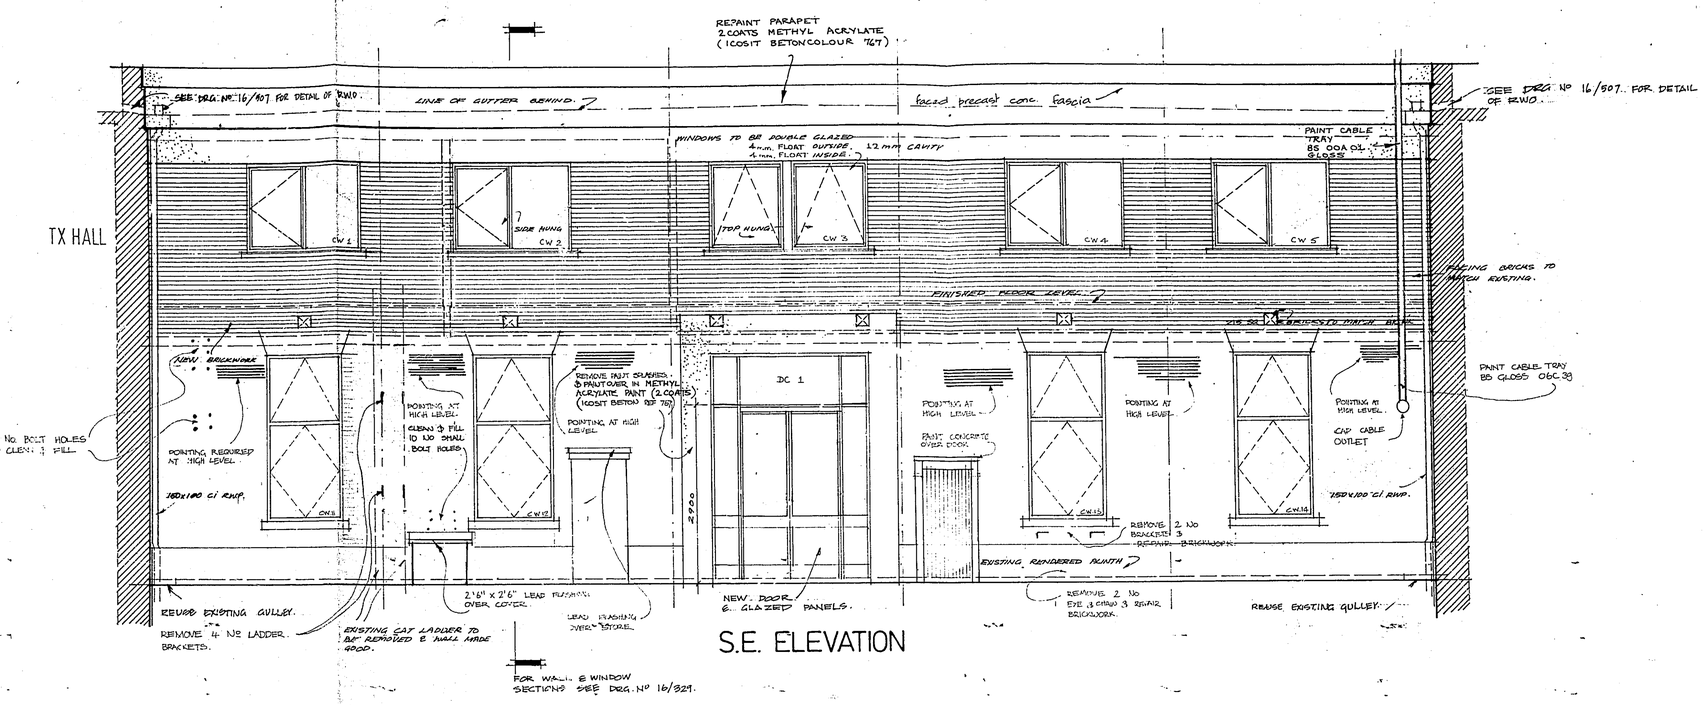

S.E. ELEVATION

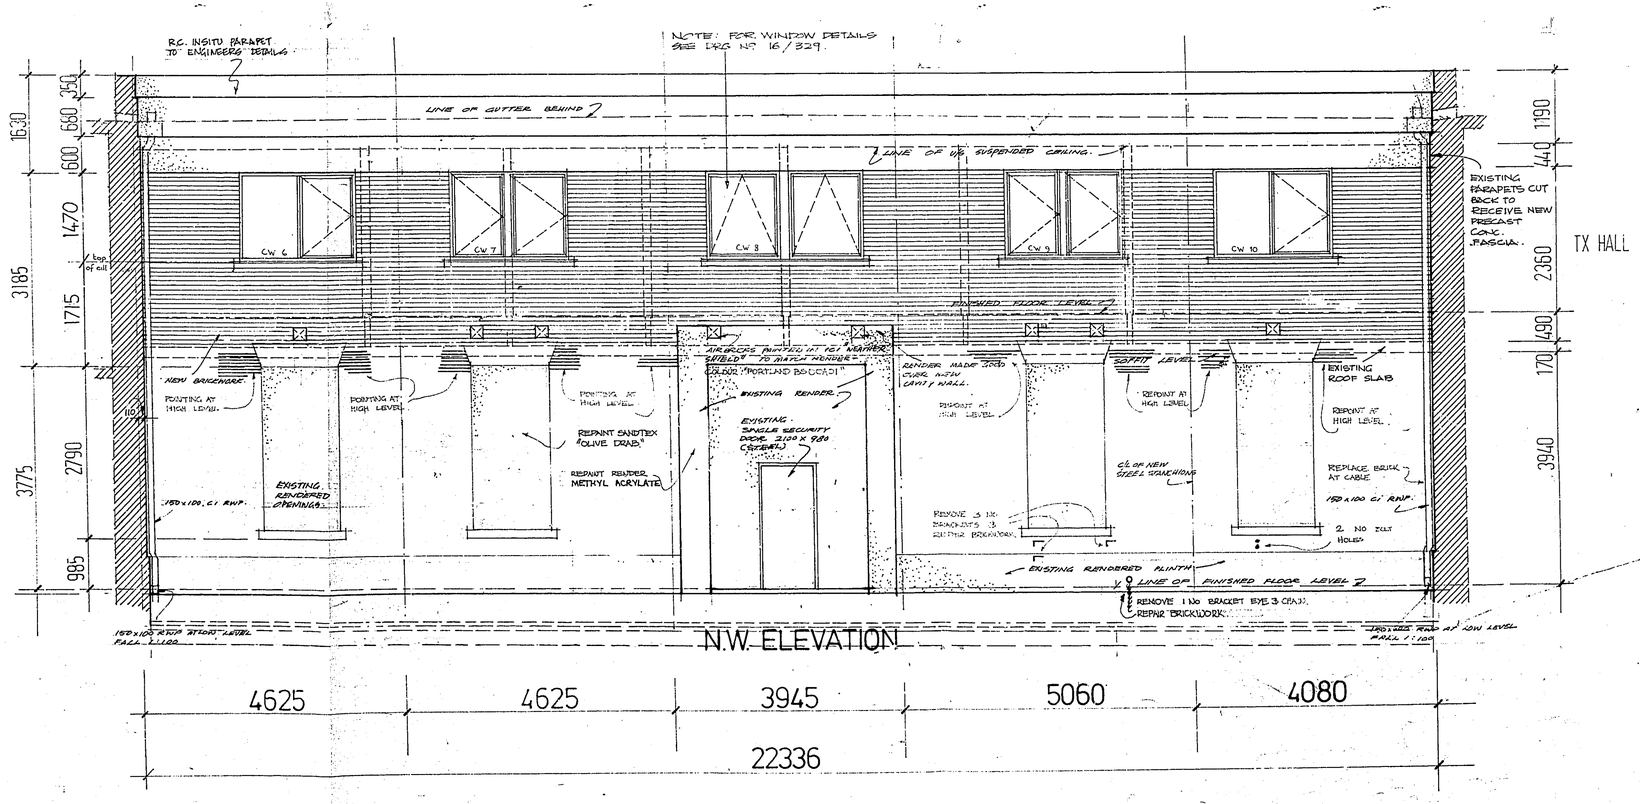

N.W. ELEVATION

4625 | 4625 | 3945 | 5060 | 4080

22336

OFFICE COPY

WELWYN HATFIELD D.C.
RECEIVED.....

6/200/86

WELWYN HATFIELD D.C.
TOWN & COUNTRY PLANNING ACT 1971
PLAN REFERRED TO IN CONSENT/REFUSAL
Date 16 MAY 1986

Rev	Date	Drn	Details
7	3/4/82		ADD CEILING REPAIR NOTES. REPAINT SOFFITS.
6	21.5.81	RA	AIRBRICK position raised one brickcourse.
5.	22.9.81	MJDE	EXTERNAL PANE OF GLAZING REDUCED TO 4mm. GLAZING REVISED. WINDOW REFS. ADDED.
4	9.9.81	MJDE	HEIGHT OF FIRST FLOOR CILLS SHOWN.
3	22.7.81	RA	MINOR AMENDMENTS.
2	3.7.81	RA	DIMS AMENDED. EXISTING FOUNDATION SHOWN.
1	3.4.81	RA	WINDOWS AMENDED. NOTES ADDED.

BBC

Architectural and Civil Engineering Department.
Broadcasting House, London, W1A 1AA.
Tel: 01-580 4468

Site / premises BROOKMANS PARK
Project accommodation redevelopment stage II
Title cet offices - elevations (as built)
Drawn scale
Scale 1:50 Drawn by R.A. Date 11 3 81

Category	Site number	Drawing number	Revision
	16	491	7

S & H LTD L6031A

A2 A3 A4 A4 A4 A4 A3 A2 A1

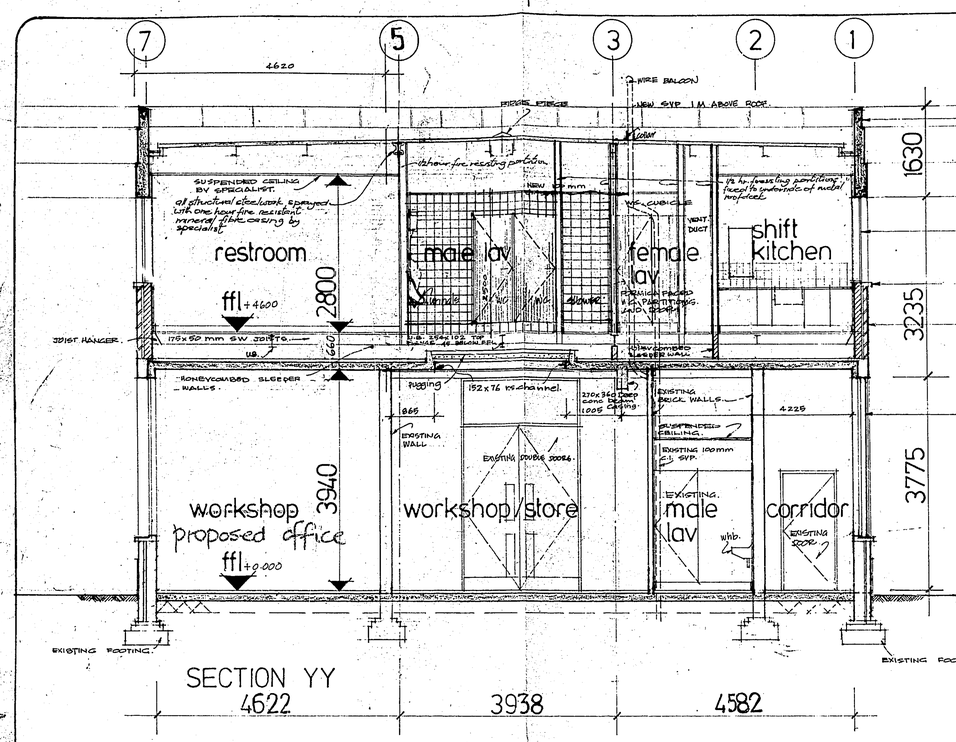

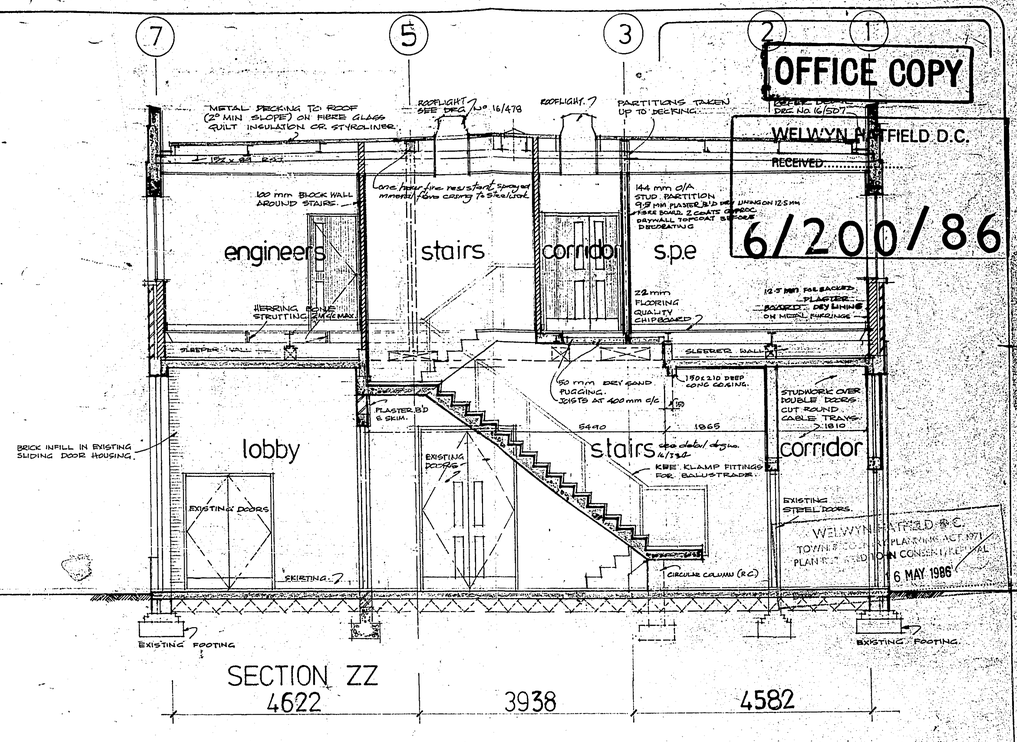

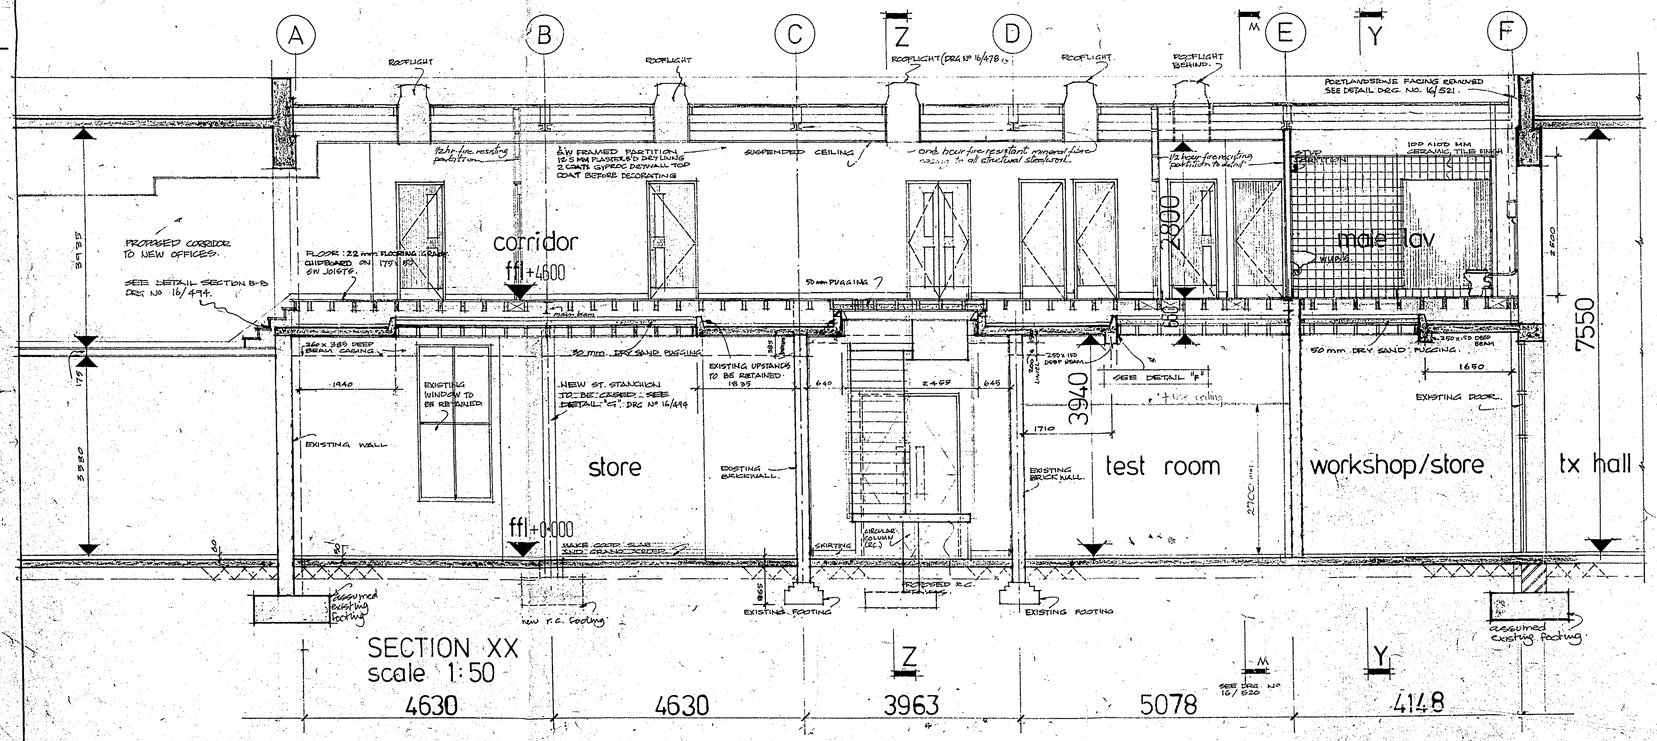

OFFICE COPY

WELWYN HATFIELD D.C.
RECEIVED
6/200/86

WELWYN HATFIELD D.C.
PLANNING ACT 1971
TOWN & COUNTRY PLANNING GENERAL DEVELOPMENT ORDER
CONSENT REQUIRED
6 MAY 1986

Rev	Date	Drn	Details
9	2-7-82	RWH	False ceiling shown in test room.
8	7-6-82	JC	corridor and ceiling layout revised along grid line A. vent duct in section YY shown. 1st f.c. fire lobby doors in corridor (section AA) repositioned. one hour fire resistant plasterboard and fibre board ceiling to rear of lift door indicated in engineers rm. section. zz. grid line dimensions corrected in accordance with Hawkes Construction drwgs. Portland stone face to wall on GRID F removed. Chipboard thickness 22mm instead of 25. plaster fork heads omitted on grid lines shown.
7	17-5-82	JC	
6	4-3-82	JC	
5	15-2-82	JC	
4	12.10.81	RA.	SOUTH ROOFLIGHT & LIFT ADDED.
3	21.7.81	R.A	EXISTING WORK SHOWN
2	1.7.81	RA	ROOFLIGHTS REPOSITIONED. SECTION LINE MM MINOR AMENDMENTS TO WALLS & FOUNDATIONS.
1	1.5.81	RA	DETAIL A REMOVED SEE DRG. 16/494 MAJOR REVISIONS.

BBC

Architectural and Civil Engineering Department,
Broadcasting House, London, W1A 1AA.
Tel: 01-580 4468.

Site/premises: BROOKMANS PARK
Project: accommodation redevelopment stage II
Title: NEW C.E.T. OFFICES SECTION XX YY ZZ
Drawn scale
Scale 1:50 Drawn by RA Date 9.3.81

Category	Site number	Drawing number	Revision
	16	490	9

S & H LTD L6031A

A1 A2 A3 A4 A4 A4 A4 A3 A2 A1

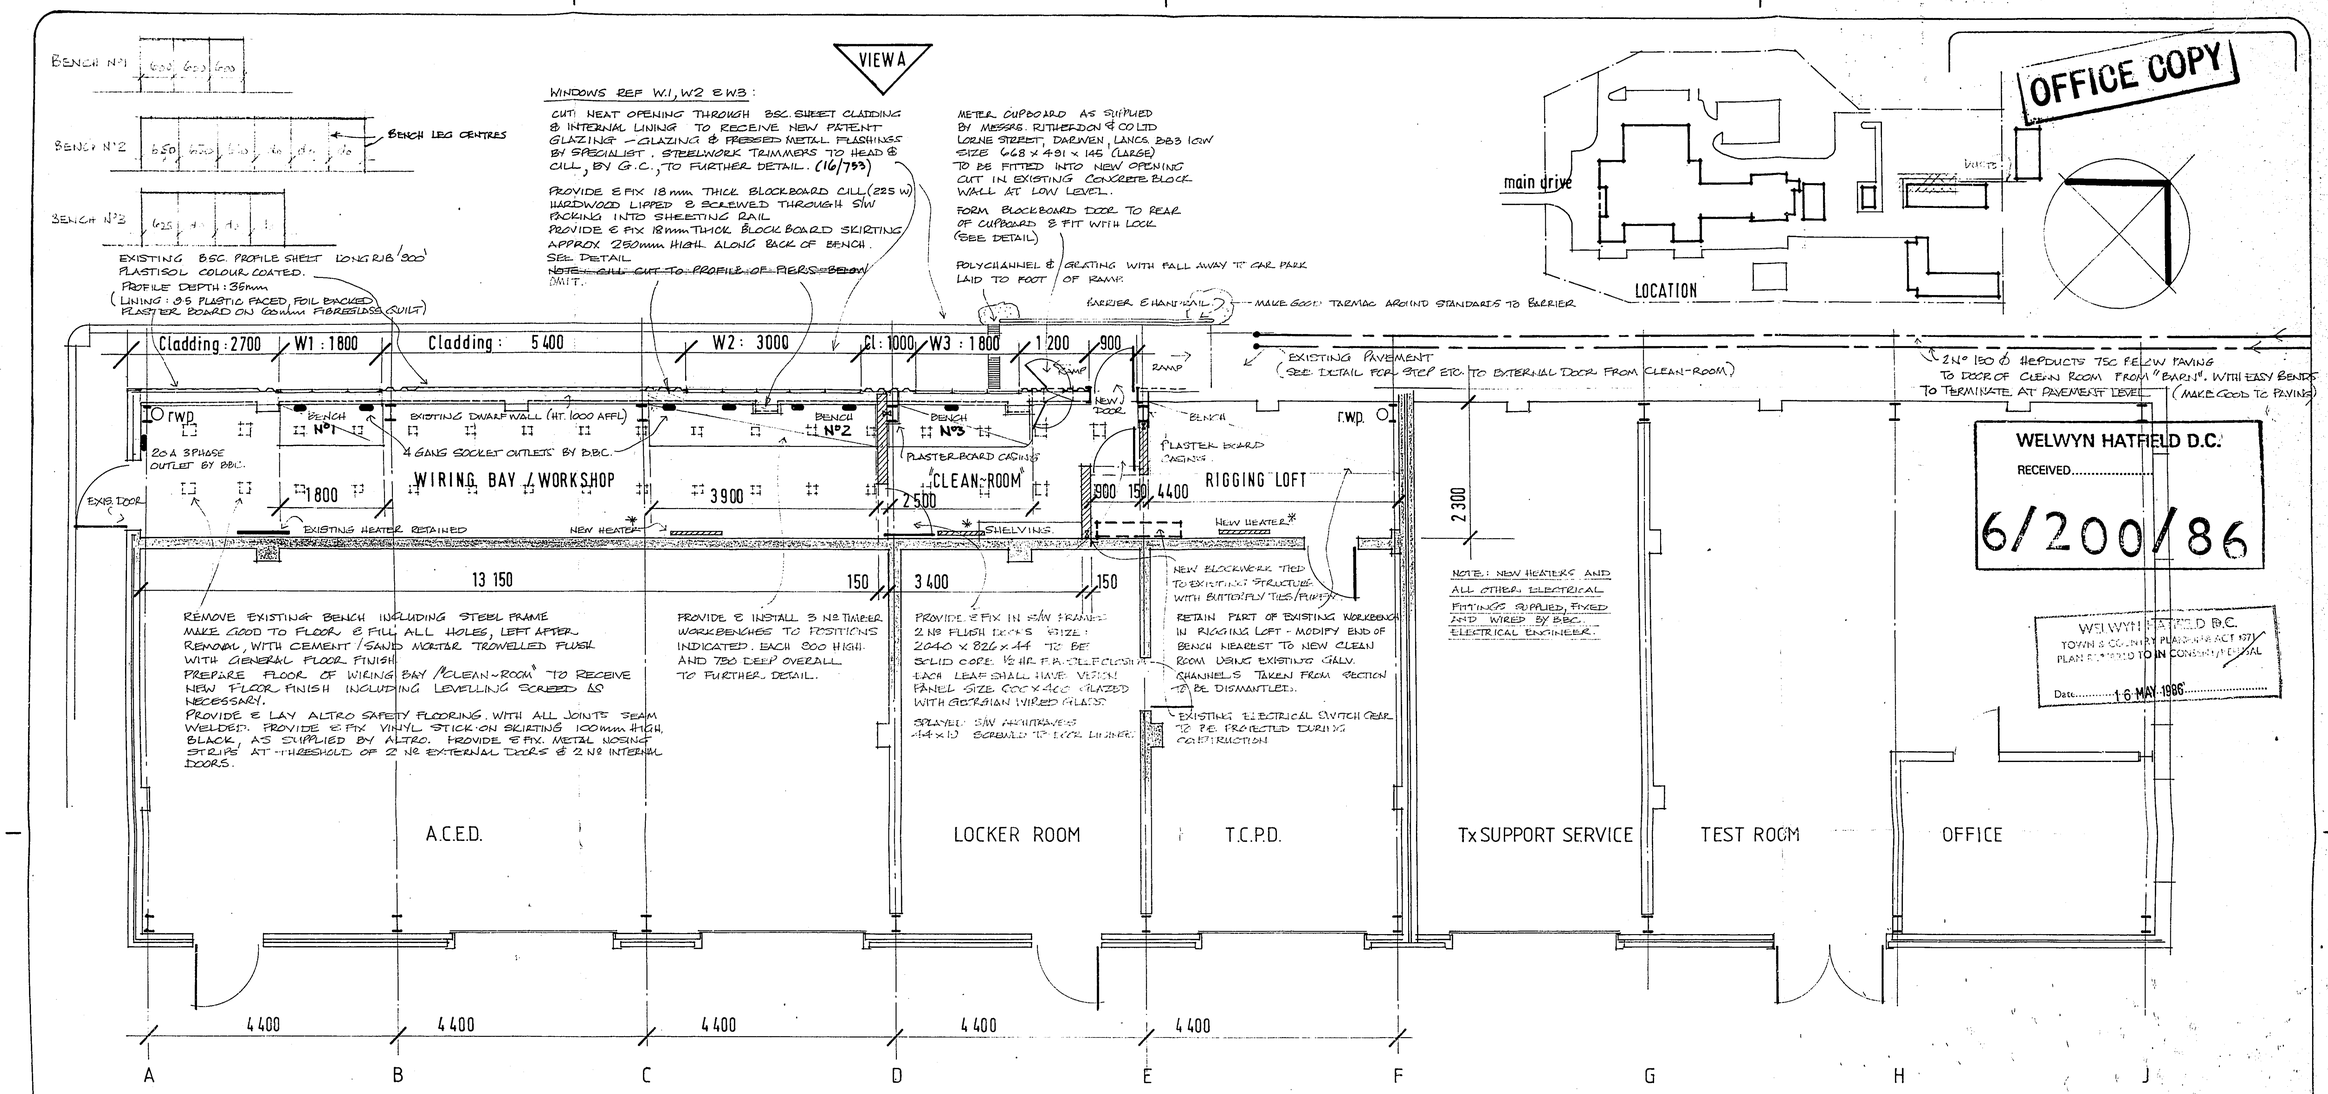

PLAN TO SHOW LAYOUT IN CONVERTED AERIAL LOFT

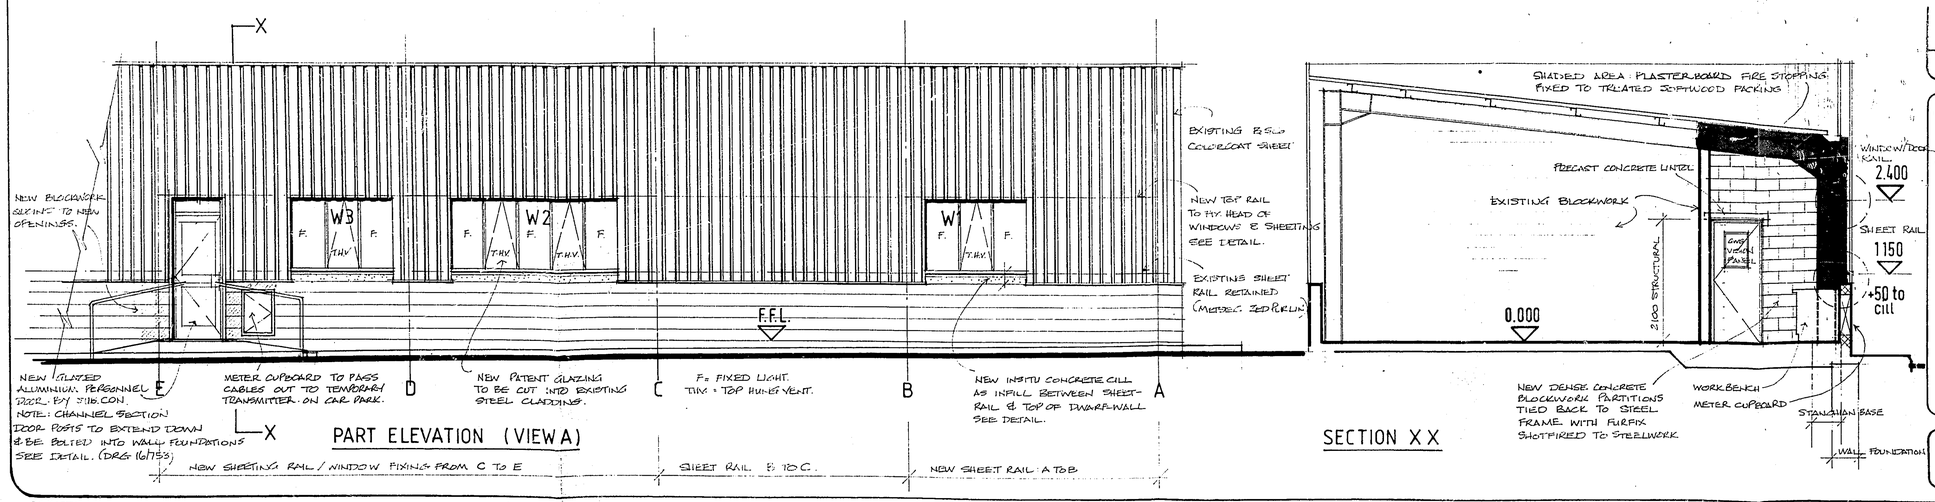

PART ELEVATION (VIEW A)

SECTION XX

Rev	Date	Drn	Details

BBC

Architectural and Civil Engineering Department.
Broadcasting House, London, W1A 1AA.
Tel: 01-580 4468

Site/premises BROOKMANS PARK
Project STAGE III(A) REFURBS
Title Conversion of existing aerial loft into wiring bay. Plan, section & elevation.
Drawn scale
Scale 1:50 Drawn by M.K. Date 11.12.85

Category	Site number	Drawing number	Revision
	16	752	

S & H L7376A

A1 A2 A3 A4 A4 A4 A4 A3 A2 A1