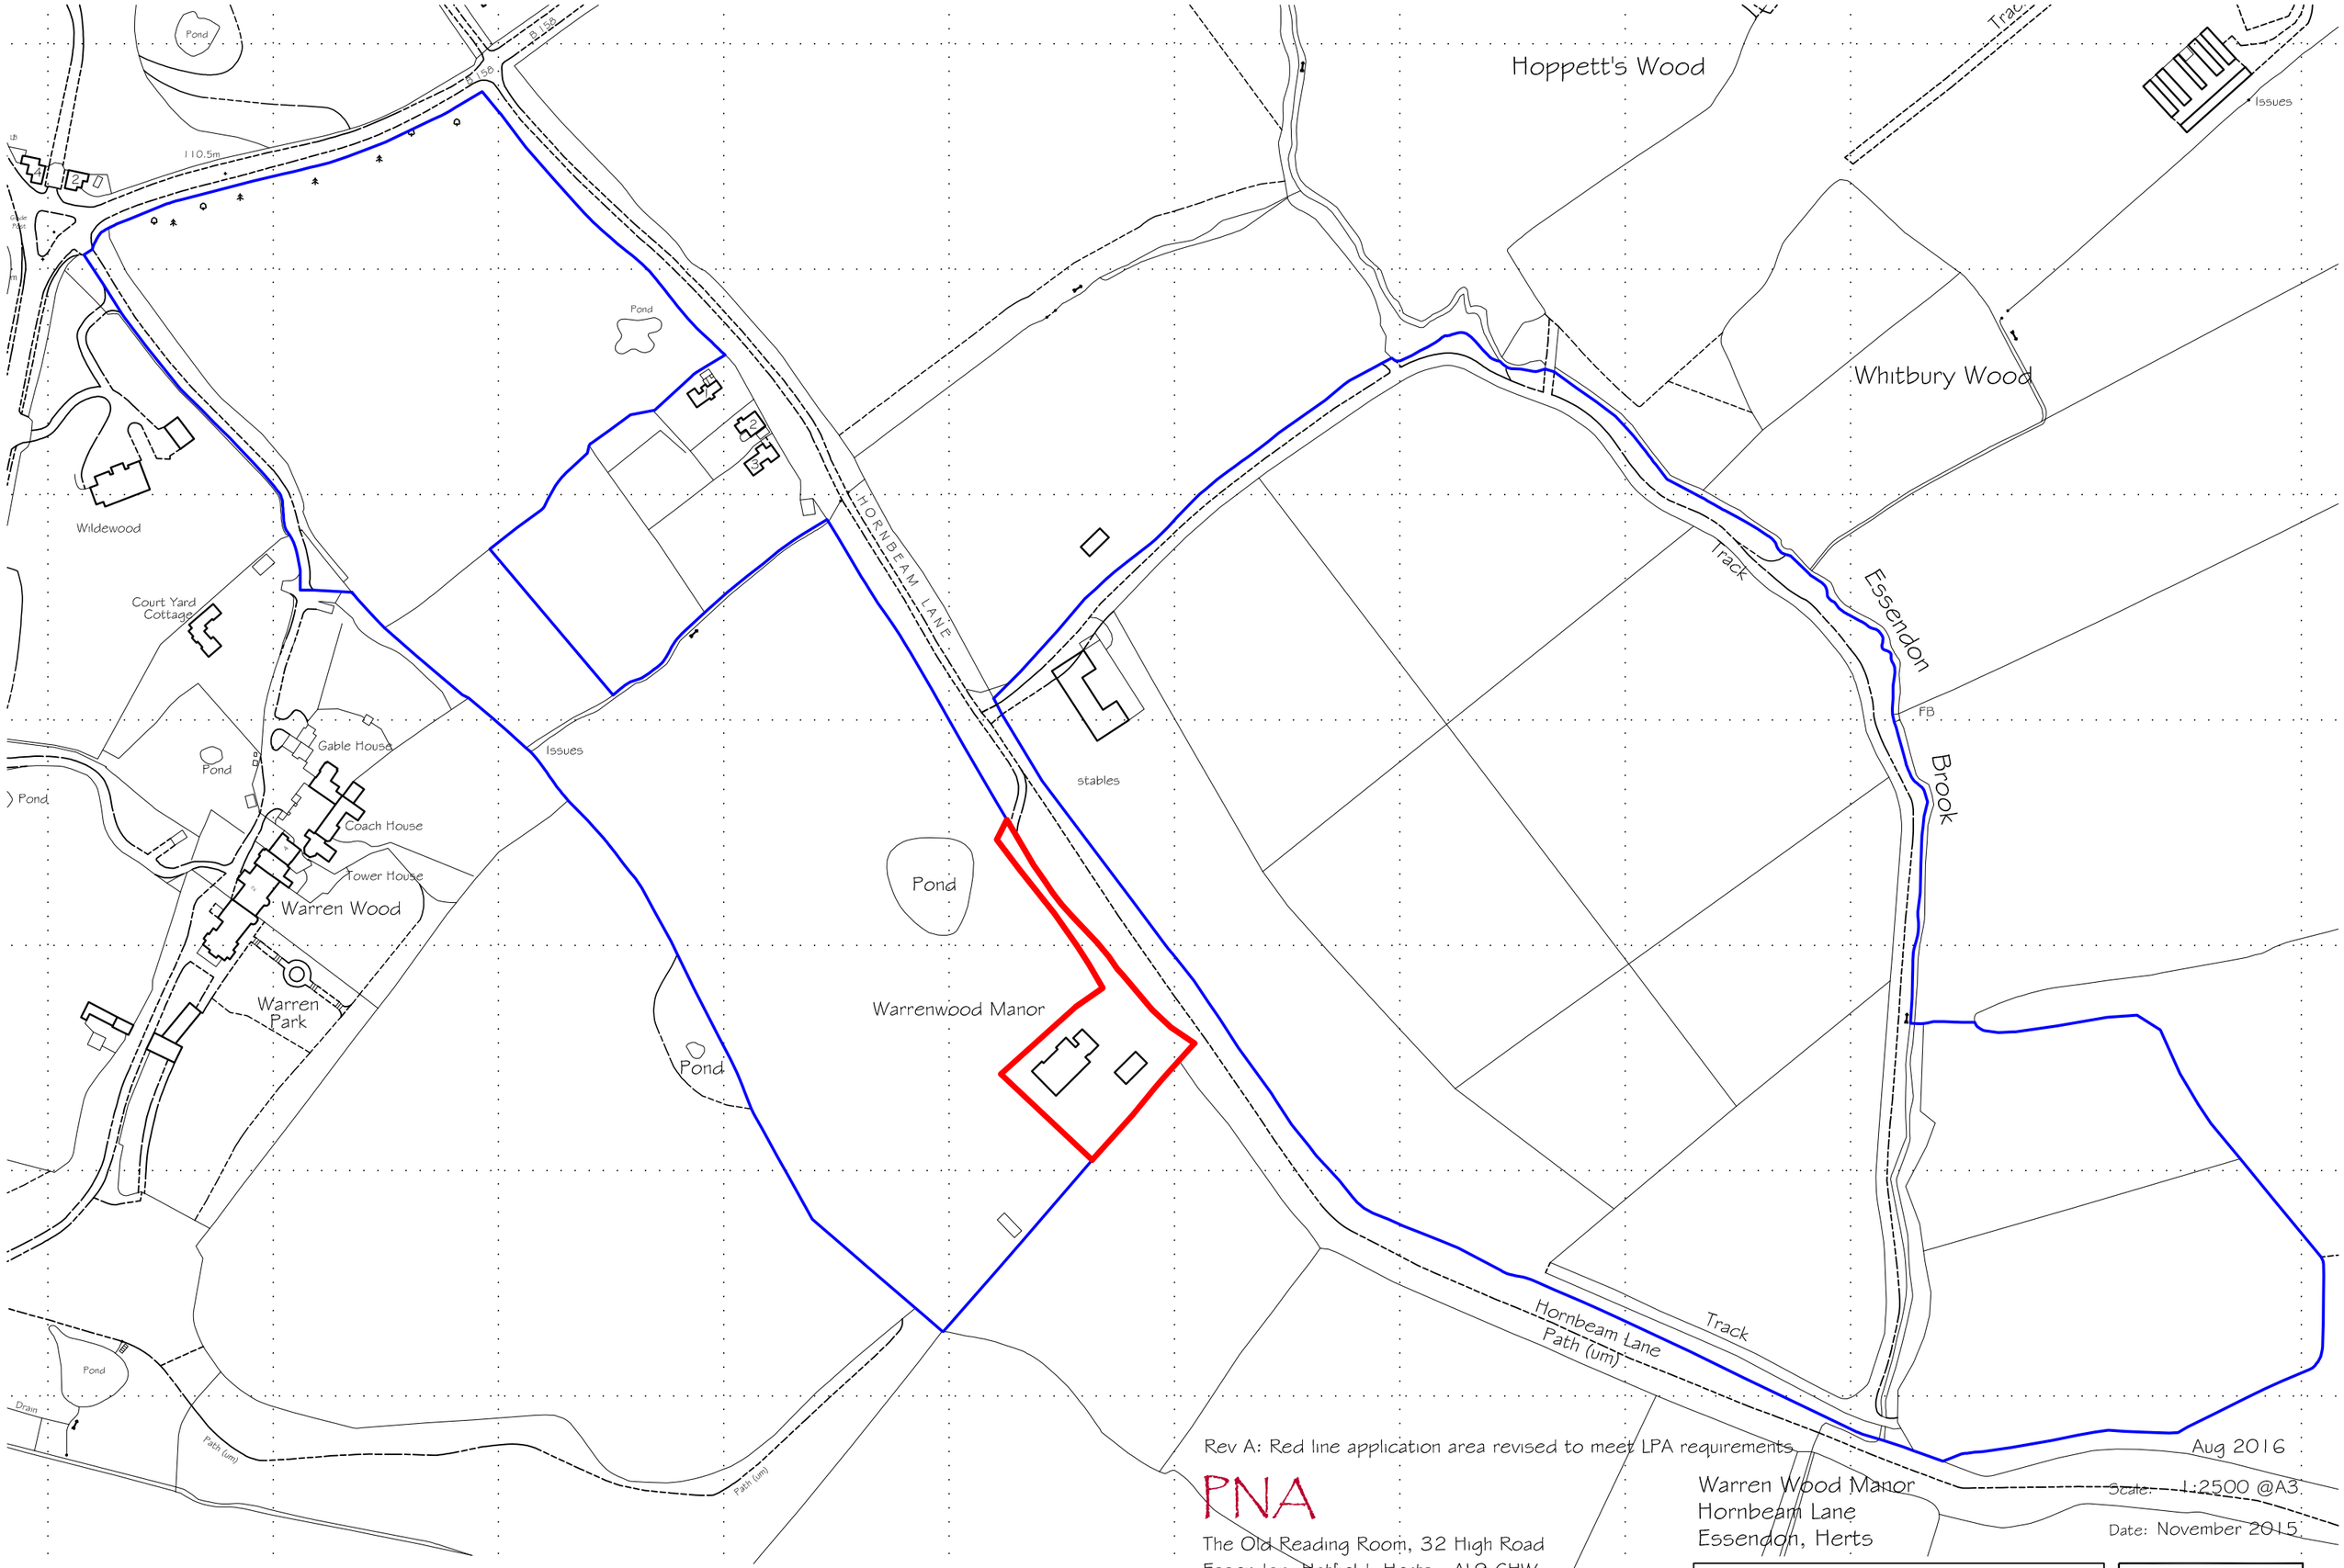

© Crown Copyright 2009. All rights reserved. Licence number 100020449

Rev A: Red line application area revised to meet LPA requirements

PNA
The Old Reading Room, 32 High Road
Essendon, Hatfield, Herts. AL9 6HW
Tel: 01707 276595 Fax : 01707 260024
Copyright © email : info@pna.eclipse.co.uk ~~Do Not Scale~~

Aug 2016

Warren Wood Manor
Hornbeam Lane
Essendon, Herts

Scale: 1:2500 @A3

Date: November 2015

Location Plan

Drg. No
703 / LP1A