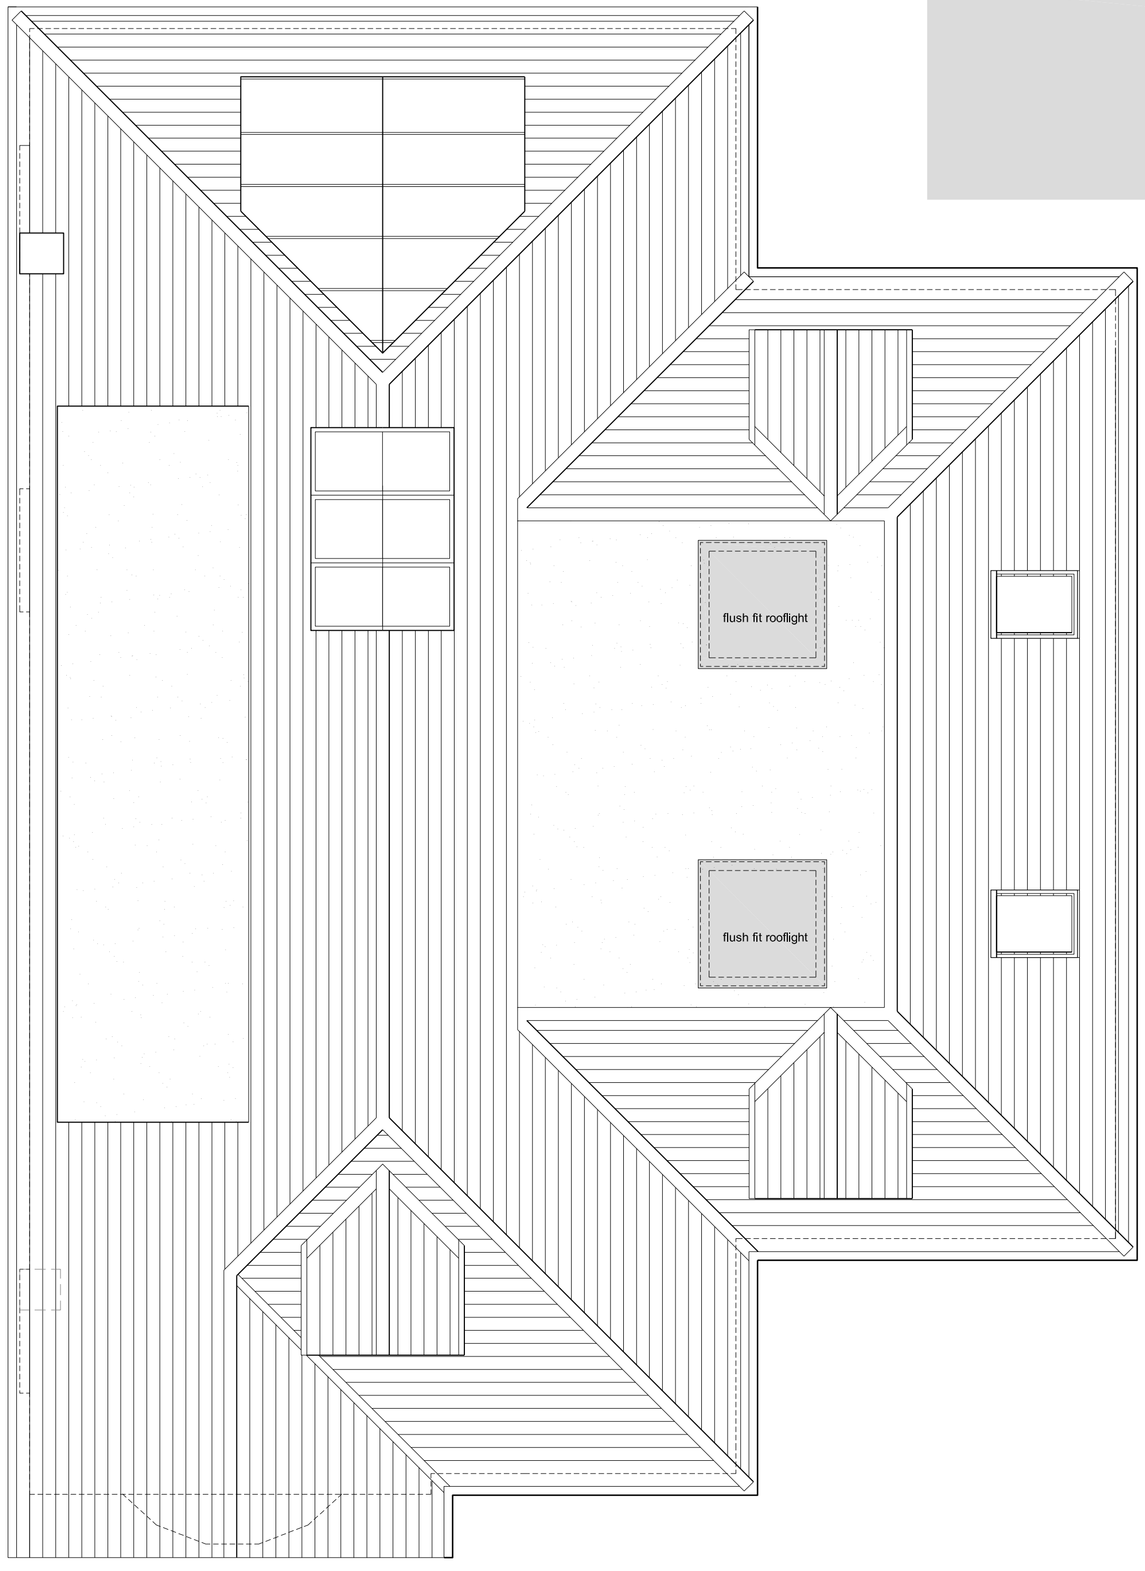

Roof Floor Plan

0 1 5

1:50@A1

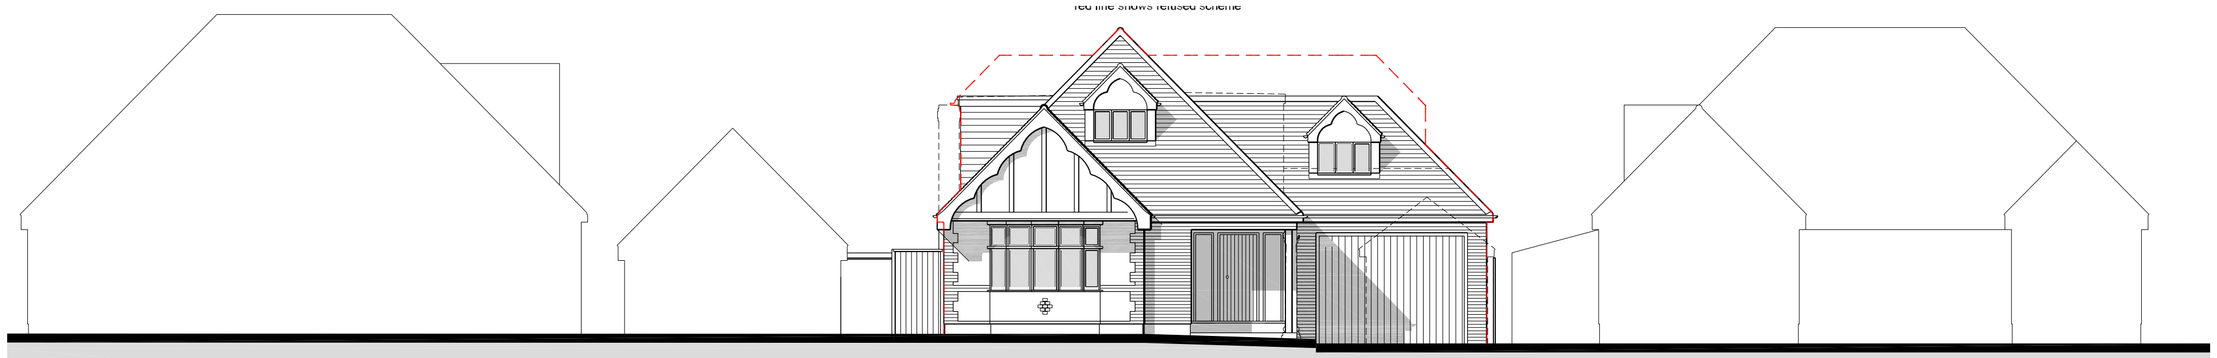

Proposed
Front Elevation

0 5 10m

1:100@A1

red line shows refused scheme

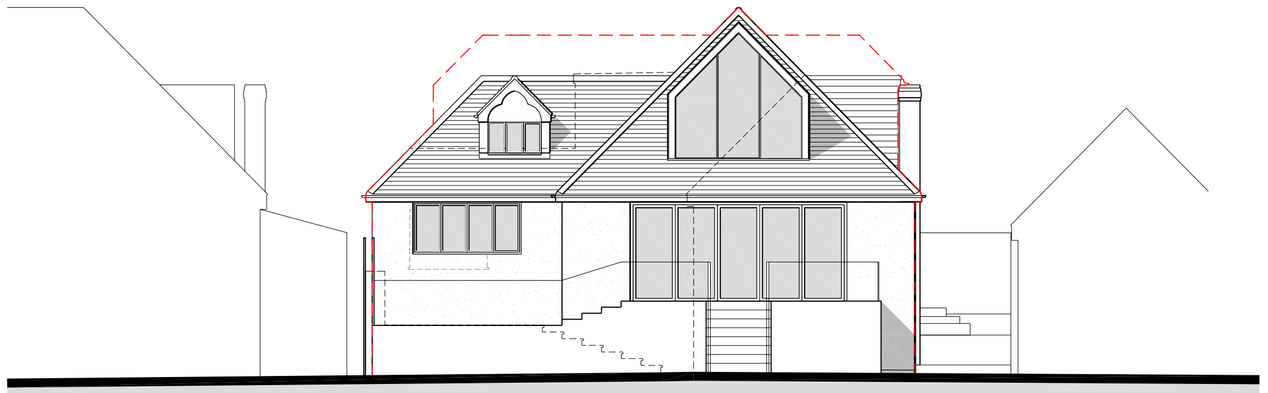

Proposed
Rear Elevation

0 5 10m

1:100@A1

red line shows refused scheme

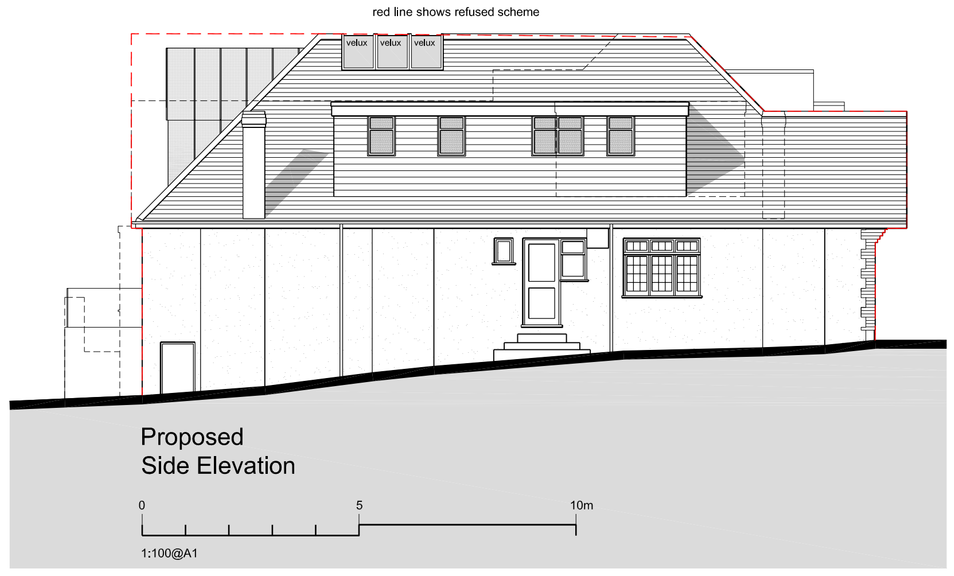

Proposed
Side Elevation

0 5 10m

1:100@A1

red line shows refused scheme

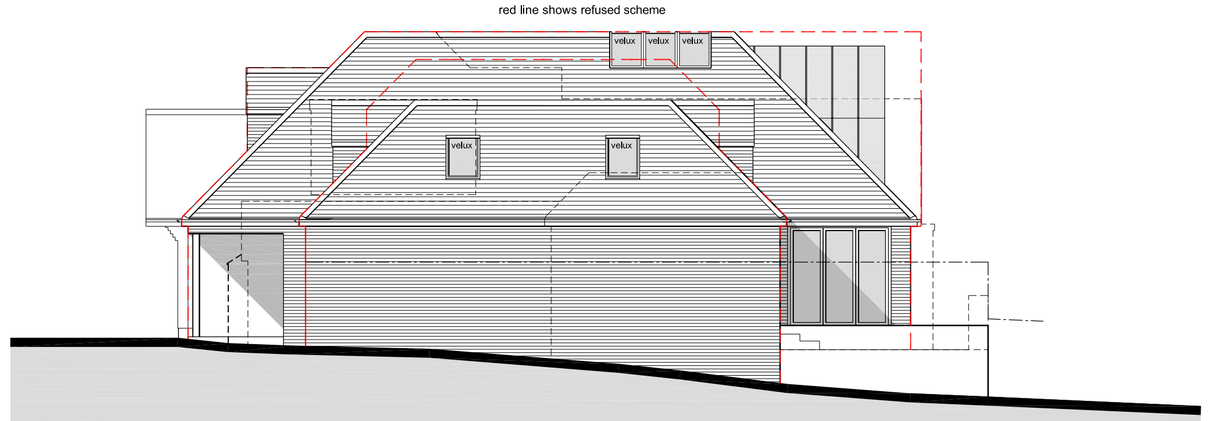

Proposed
Side Elevation

0 5 10m

1:100@A1

FINISHES

Roof
plain tiles to match existing on slopes
flat roof & crown to be asphalt
rear dormer to be lead faced

Walls
plain white render
brickwork to match existing
side dormer to be plain natural timber

Windows & Doors
new to be aluminum framed in grey RAL 9016

REV	DESCRIPTION	DATE
P7	Planning	20.09.10
P6	Client - Revised Scheme	14.09.10
P5	Revised Planning	10.09.10
P4	Revised Planning	27.04.10
P3	Planning	04.01.10
P2	Planning	02.12.09
P1	Prelimary	05.10.09

67 The Ridgeway, Cuffley
Hertfordshire EN6 4BD

Proposed Roof Plan,
Elevations

Scale @ A1	1:50 1:100
Created	05.10.2009
Purpose of Issue	PLANNING

Open Architecture
Architecture
Building Surveying
Project Management
Interior design

46-56 Royal Parade Mews
Blackheath Village
London / SE3 0TN

www.openarc.co.uk
T +44 020 8318 9700
F +44 020 8313 0990

Job Reference	Drawing Number	Rev
09033	007	P7