©2010 Arqiva
All rights reserved. No part of this publication may be reproduced, stored in a retrieval system or transmitted in any form or by any means (Electronic, Mechanical, Photocopying, Recording or otherwise), without the prior written consent of the Company.

NOTES

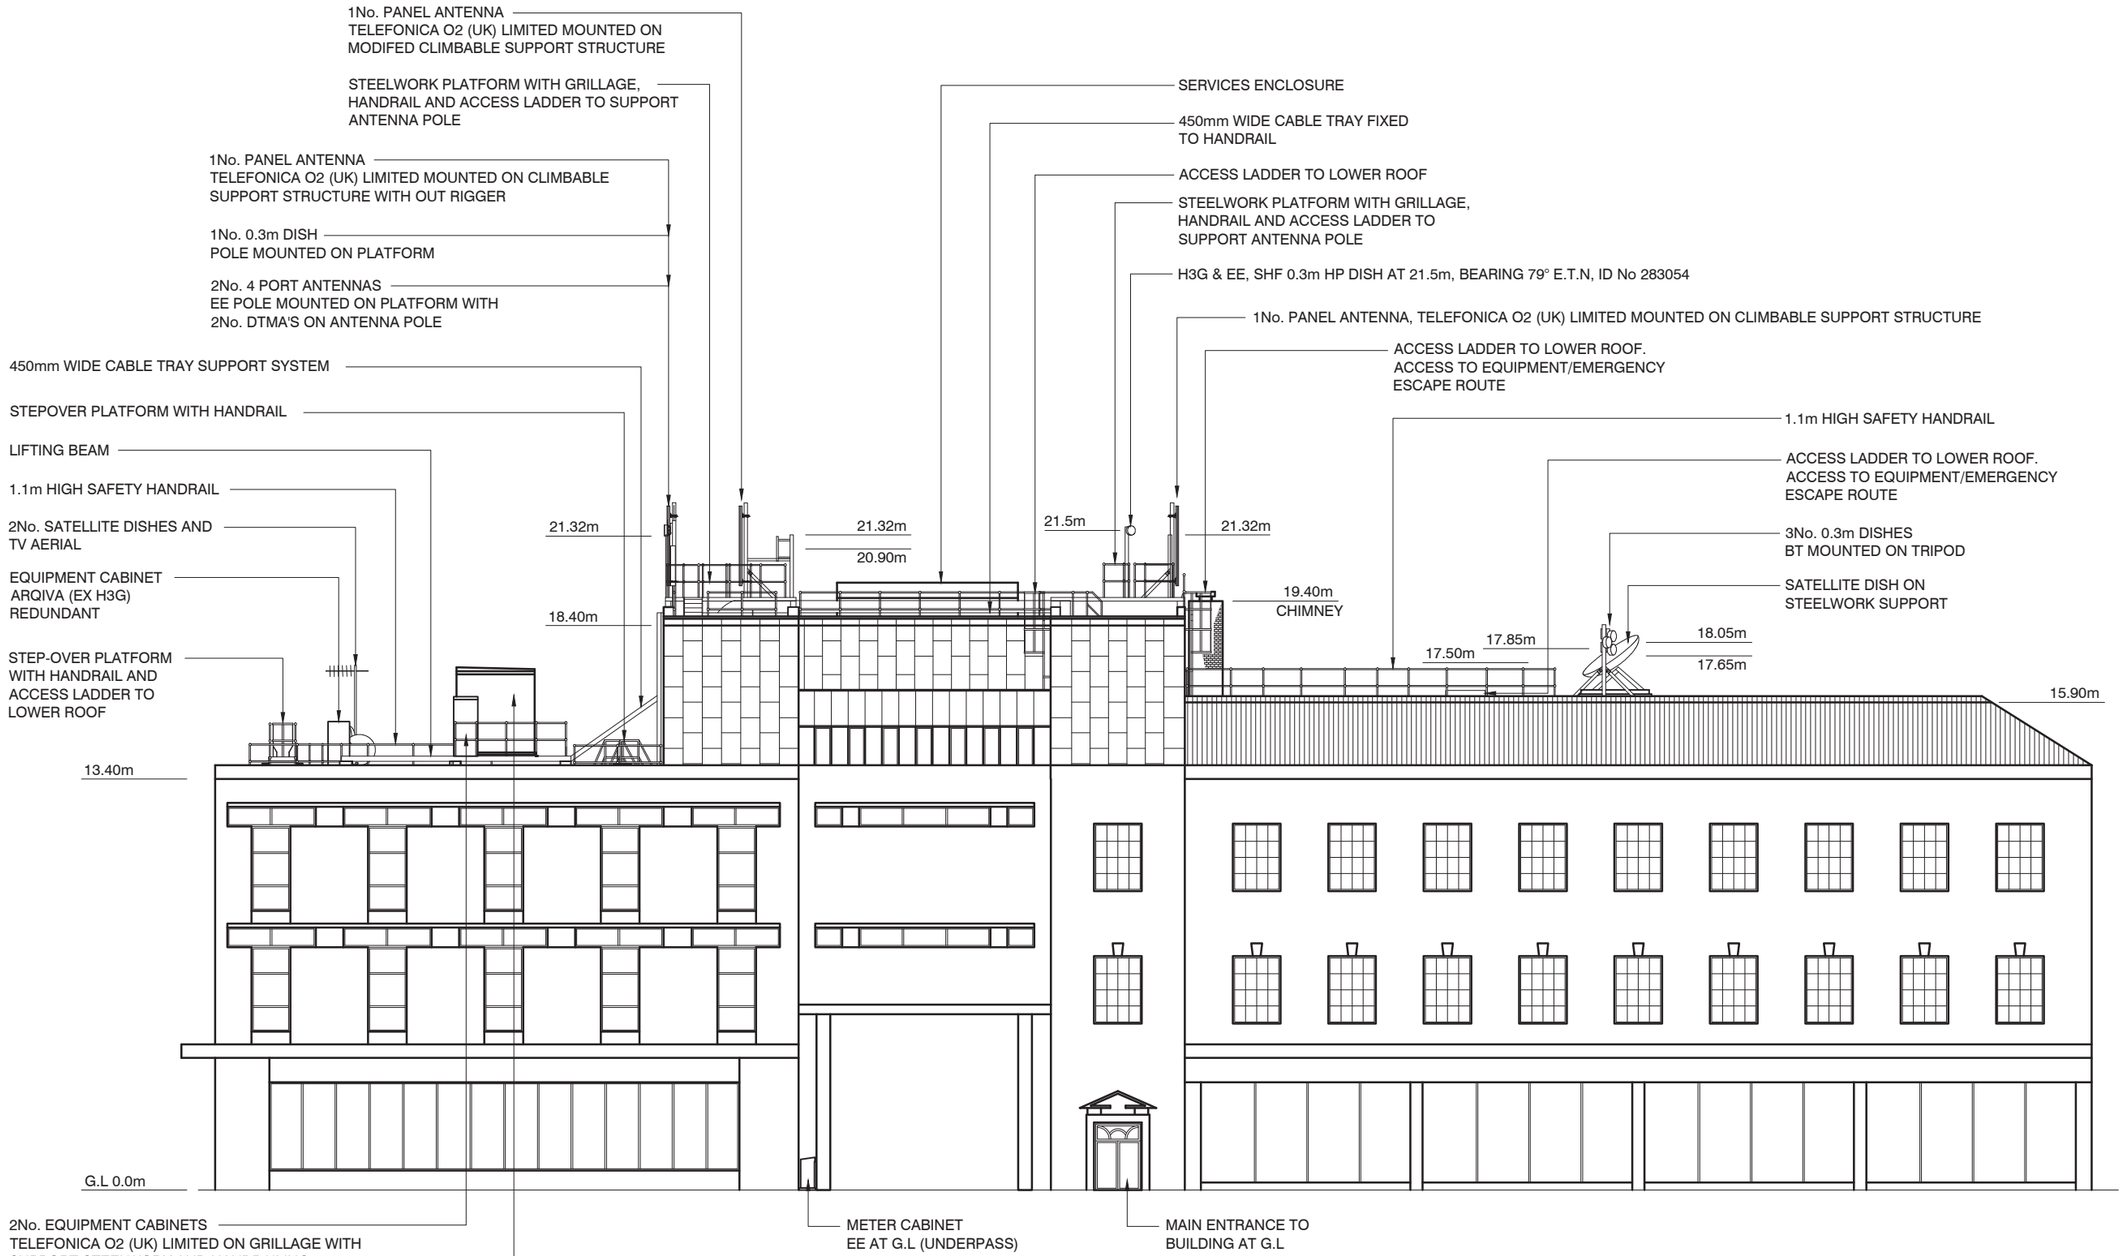

ISS	REVISION	DATE	DRN	APP
7	PROJ No 175297 MINOR AMEND	16/12/16	HFC	MF
6	PROJ No 181158 MINOR AMEND	26/10/16	PJX	PJX
5	PROJ No 175297 MINOR AMEND	06/10/16	HFC	HFC
4	PROJ No 175297 PLANNING ISSUE	13/09/16	HFC	MF
3	PROJ No 181158 PLANNING	31/08/16	PJX	CF

arqiva
Crawley Court, Winchester, Hampshire, SO21 2QA
Tel. 01962 823434, Fax. 01962 822378

SITE No 163138
WELWYN GARDEN CITY TE
WIGMORES NORTH
WELWYN GARDEN CITY
HERTFORDSHIRE
AL8 6PH

NGR TL 23710 13060
OS GRID 523710 213060

TITLE
ELEVATION
EXISTING
EAST

SCALE 1:200

DRAWN	IM	19/08/11
APPROVED	MF	16/12/16

DRG No. 163138-00-002-MD007 Sheet 1 of 1 Rev 7

A3